


(D1)

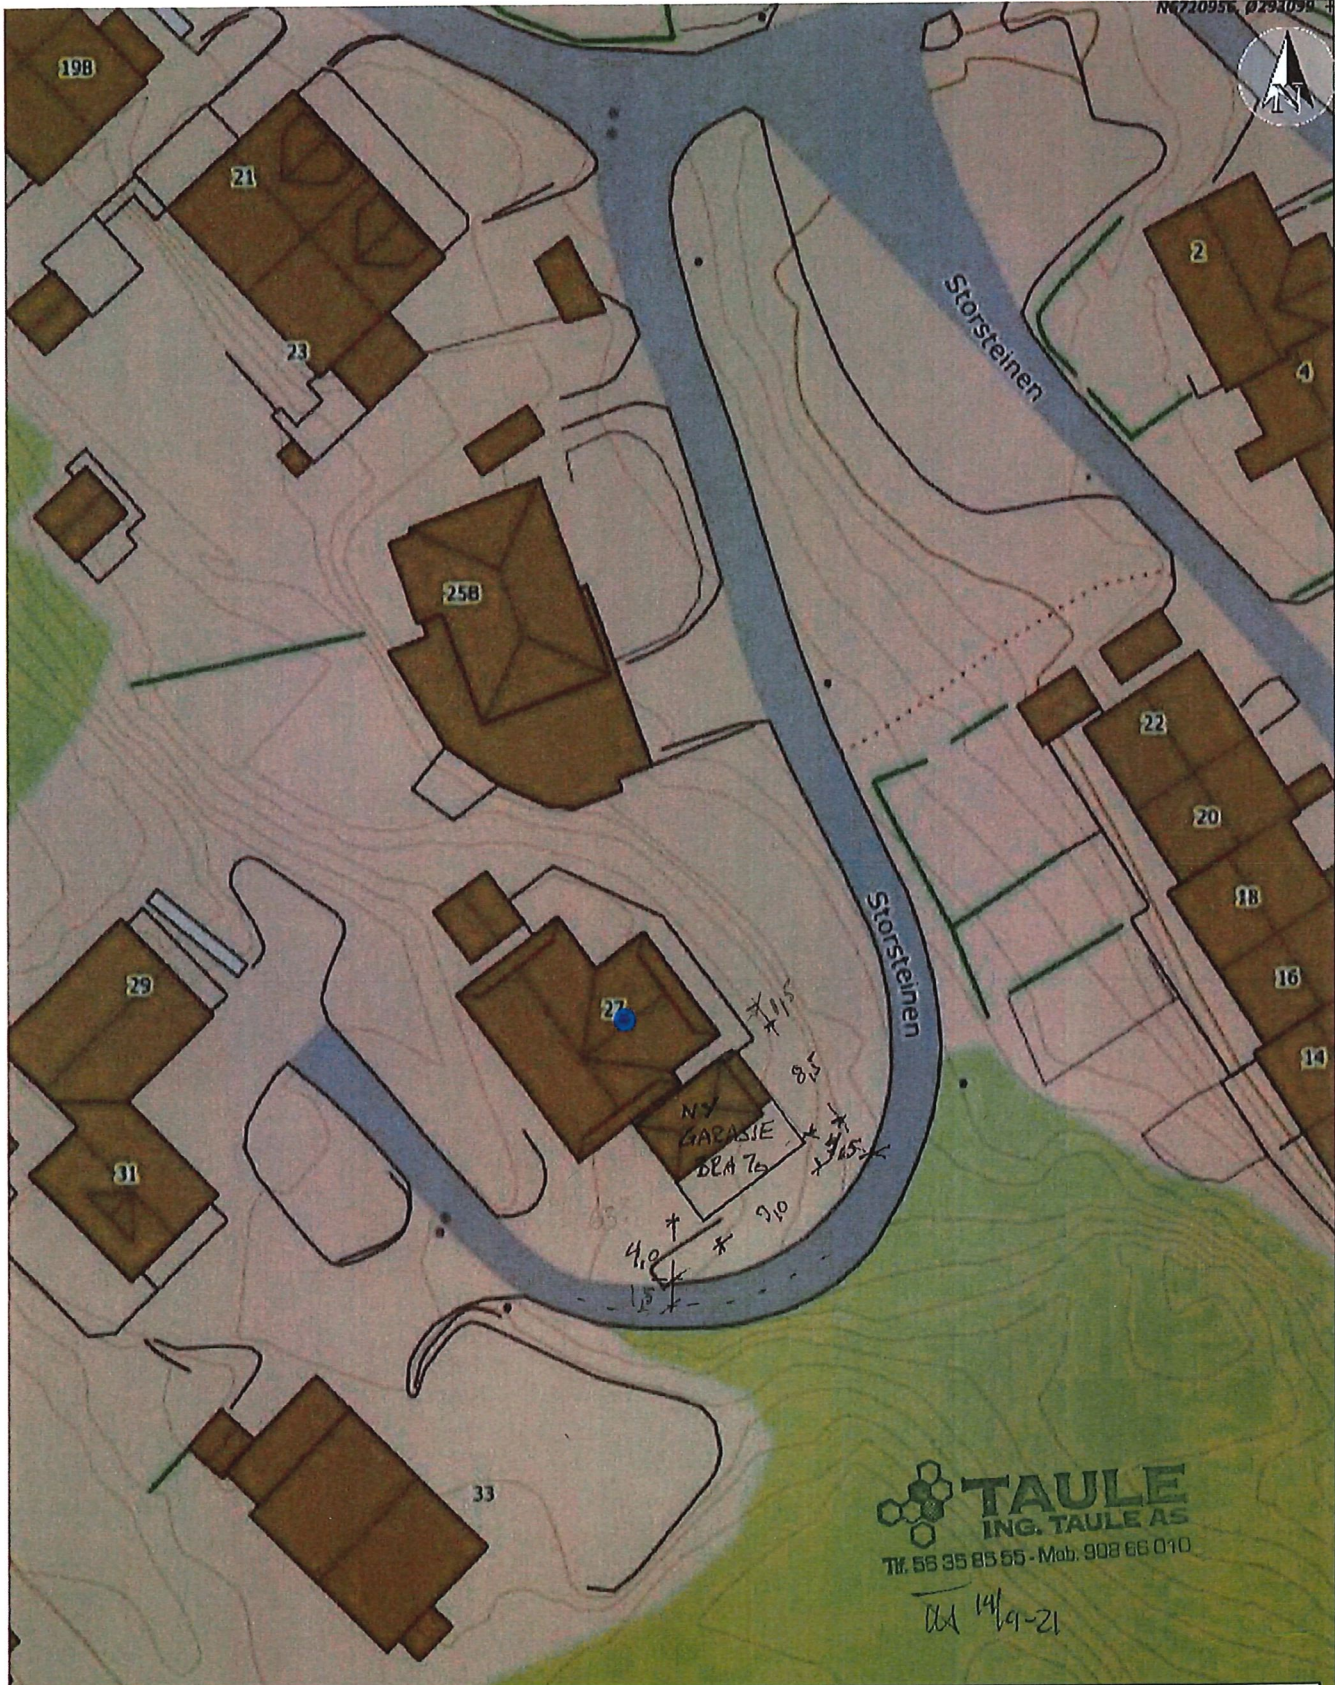

TAULE
 ING. TAULE AS
 Tlf. 55 95 85 55 - Mob. 908 66 010

14/09-21

Situasjonskart - Storsteinen 27, 5911 Alversund-
 GBNR 134/333 ang av garasje

GBNR 134/333



Dato: 03-09-2021

Målestokk: 1:500

