


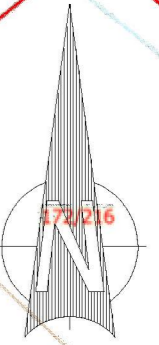


Innmålt ringmur
kote + 29.93m (1-etg)



Seim Bygg AS Nesbrekka 28 5912 Seim				 Epost: post@sh-oppmaling.no Tlf 472 99 092
Dato	Konstr./Regnet	Godkjent	Målestokk	
15.07.2021	sh		1:250	
Innmålt ringmur Gnr 172, bnr 203 Tiltakshaver: Lene og Roald Valle			Erstatning for:	Erstatet av:
Henvisning:			Beregning:	901
				Alver kommune