




Radøy, gnr 45 bnr 472,
Data på innmålt grunnmur

13.05.2019

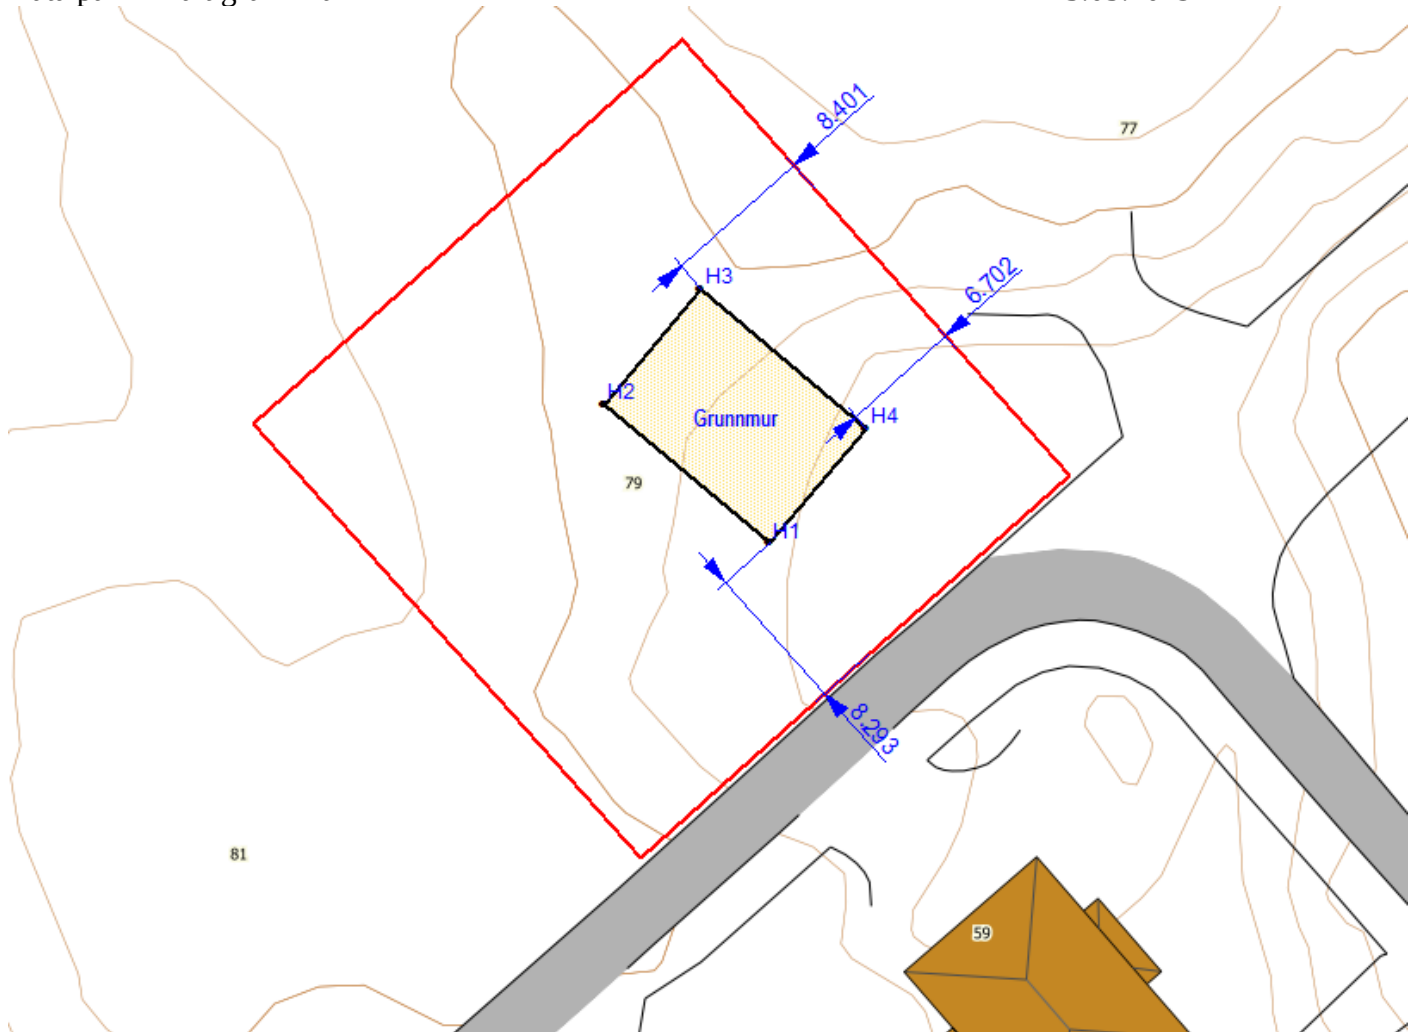

PunktID	N-koord.	Ø-koord.	Høyde
H1	6729488,28	282851,32	16,18
H2	6729496,01	282842,16	16,18
H3	6729502,43	282847,56	16,18
H4	6729494,69	282856,73	16,17