




FASADE MOT:



FASADE MOT:



FASADE MOT:

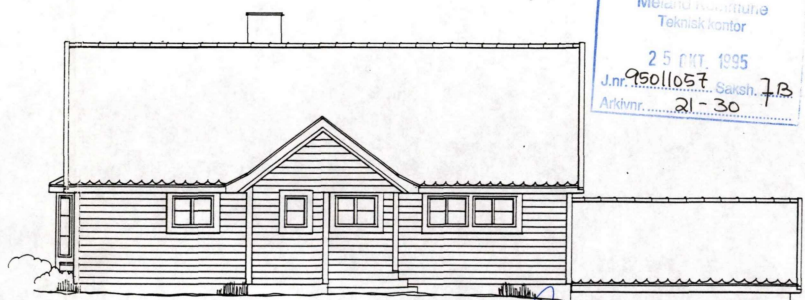

FASADE MOT:


Teknisk kontor
J.nr. 9501057 Saksh. JB
Arkivnr. 21-30

Godtaks m. merker.


Sak nr. FTE. 48/95

Teknisk sjef 29/11-95

BLINK HUS			
Byggherre JAN K. HUSA			
Byggadresse DALEMARKA			
Mål. 1:400	Type BOLIG	Tegn.nr. P 71-100	Blad 2
Utg.p.	Sign. G.H.	Dato 14/9-95	
© Tegningen er beskyttet i.h.t. lov om opphavsrett.			
		BLINK HUS HELGE ROD A/S SAG- / PRELAD- / BYGGESTYREFORRETTNING 5240 Valestrandfossen Telefon 56 39 44 80, Telefax 56 39 49 40.	

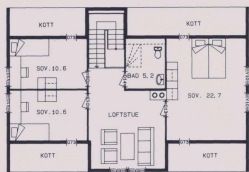

PLAN 2. ETASJE

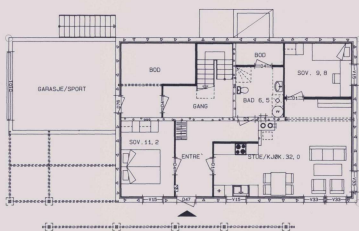

PLAN UNDERETASJE










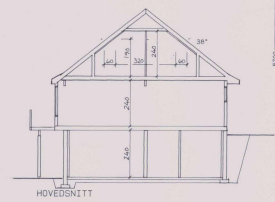

HOVENSNIITT

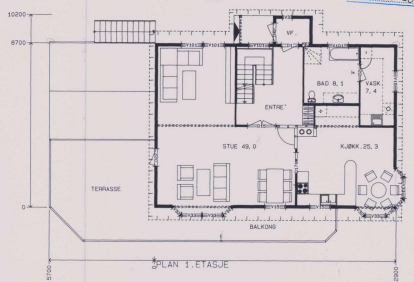

PLAN 1. ETASJE




