

ambita


03 Kommune: 1256 Meland ALVER  
Eiendom: 1256/38/23 — 338/23

Målestokk 1:1000

Dato: 22.4.2016

DATO:03.12.2020

KORRIGERT DATO:09.12.2021

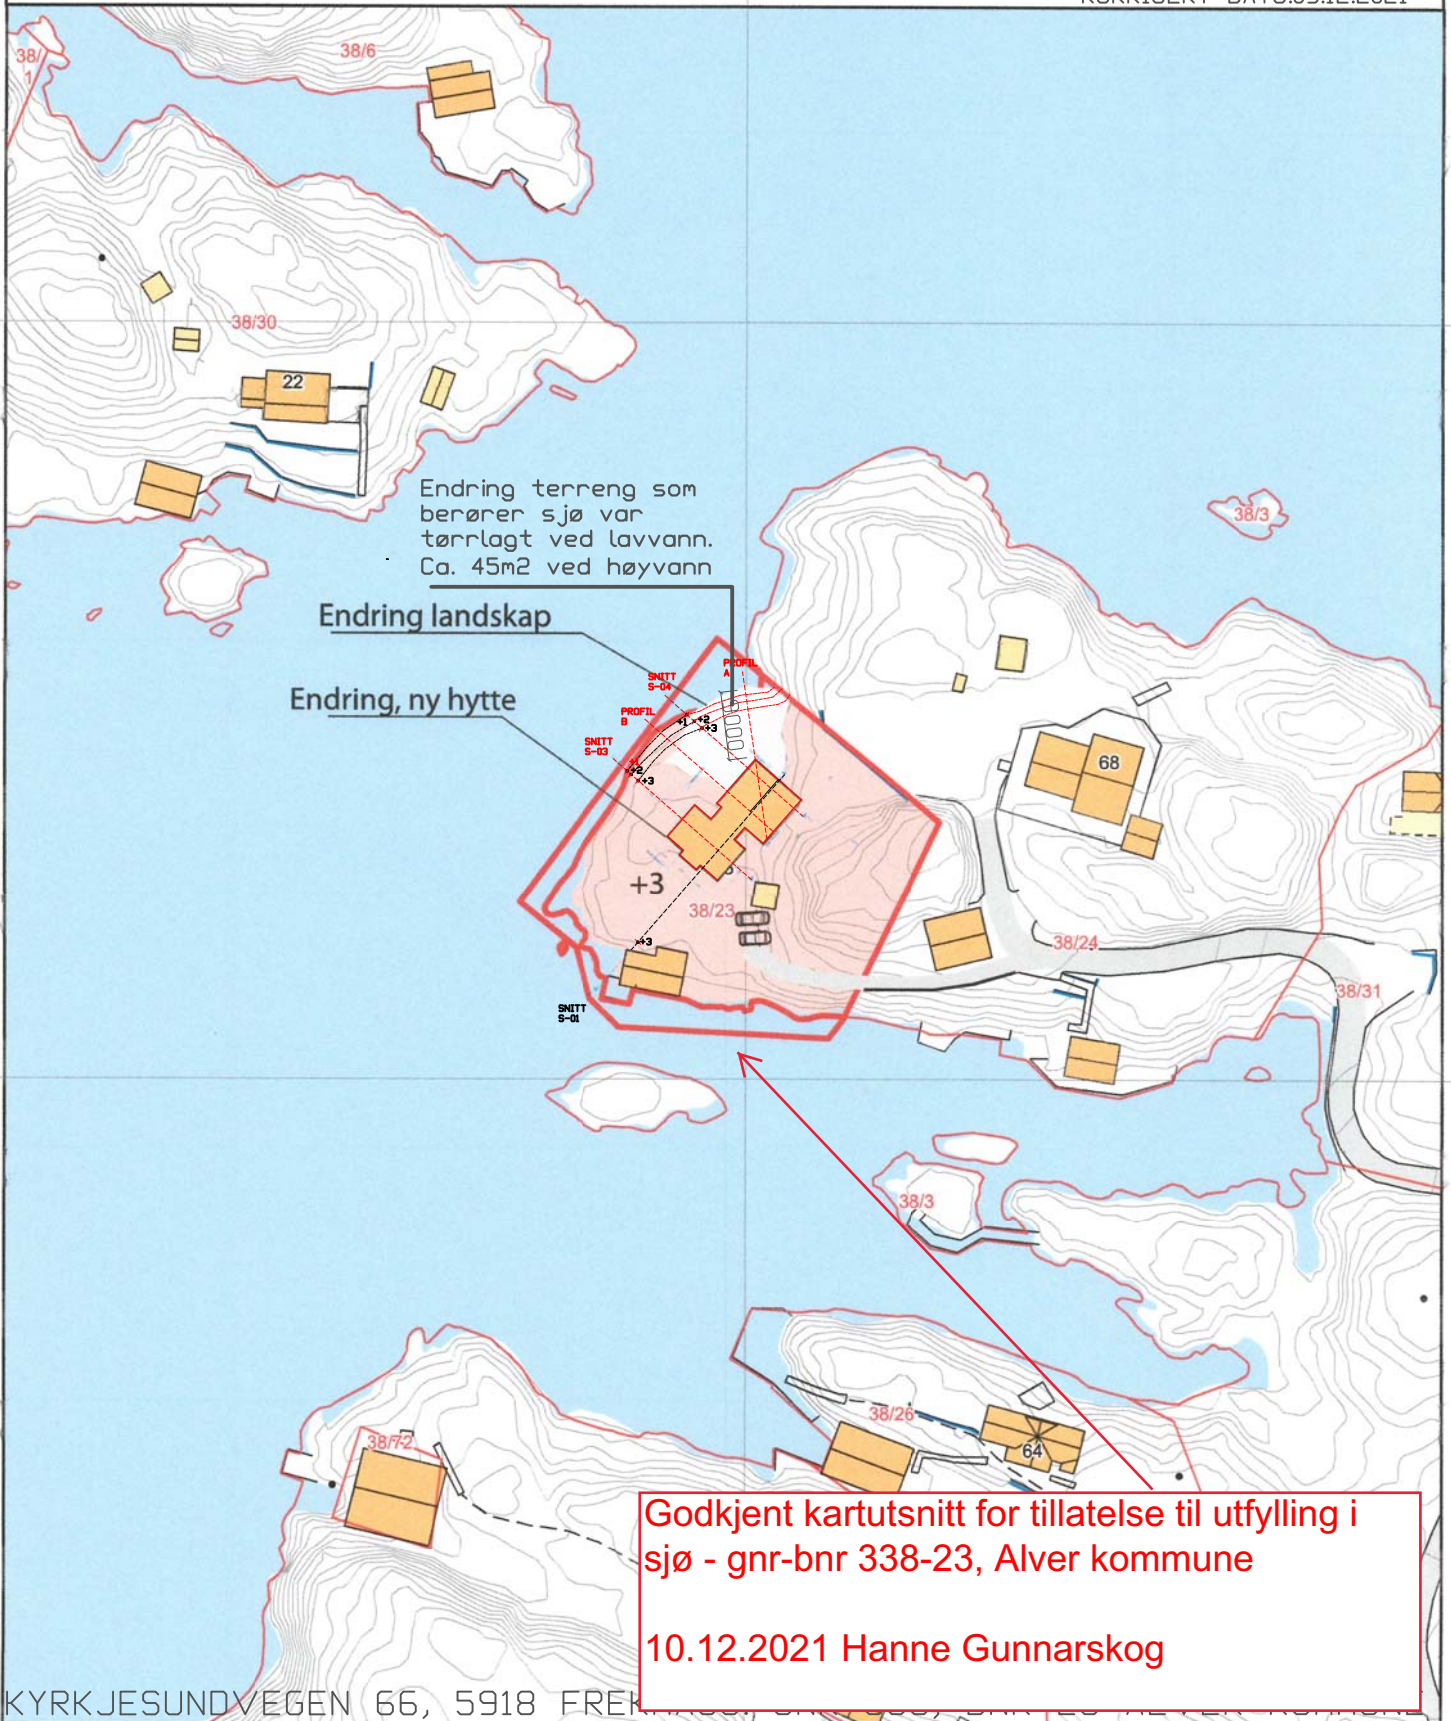

KYRKJESUNDSVEGEN 65, 5918 FREK

0 25 50 m