


Gnr 134 bnr 478, avløpsledning

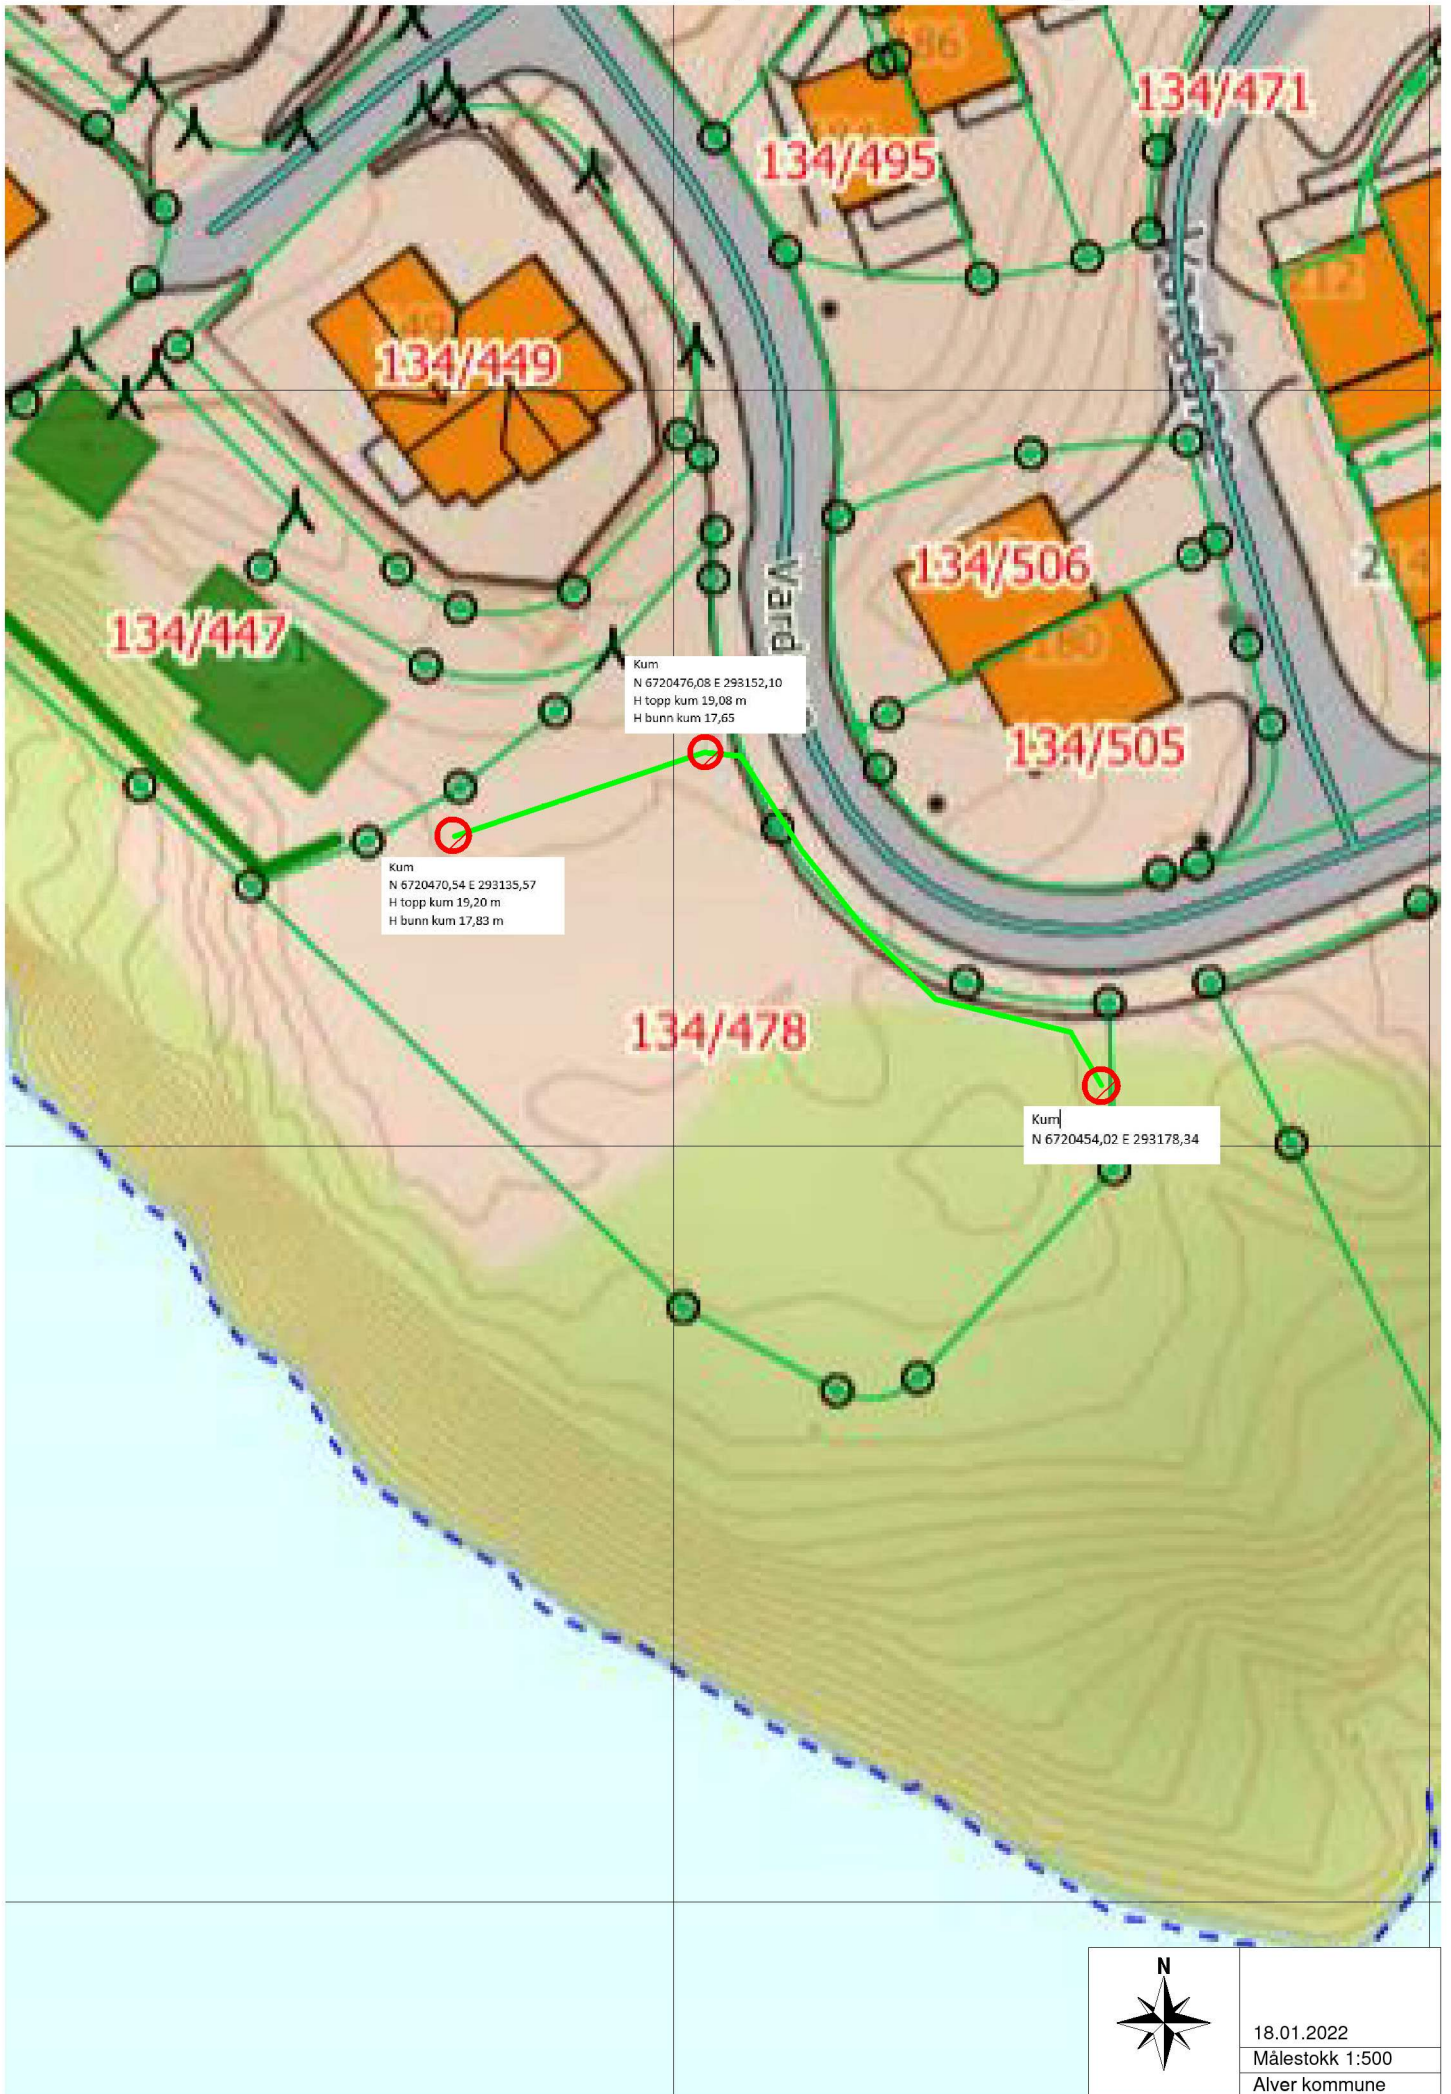

18.01.2022
Målestokk 1:500
Alver kommune