



Perspektiv Vest




Perspektiv Sør

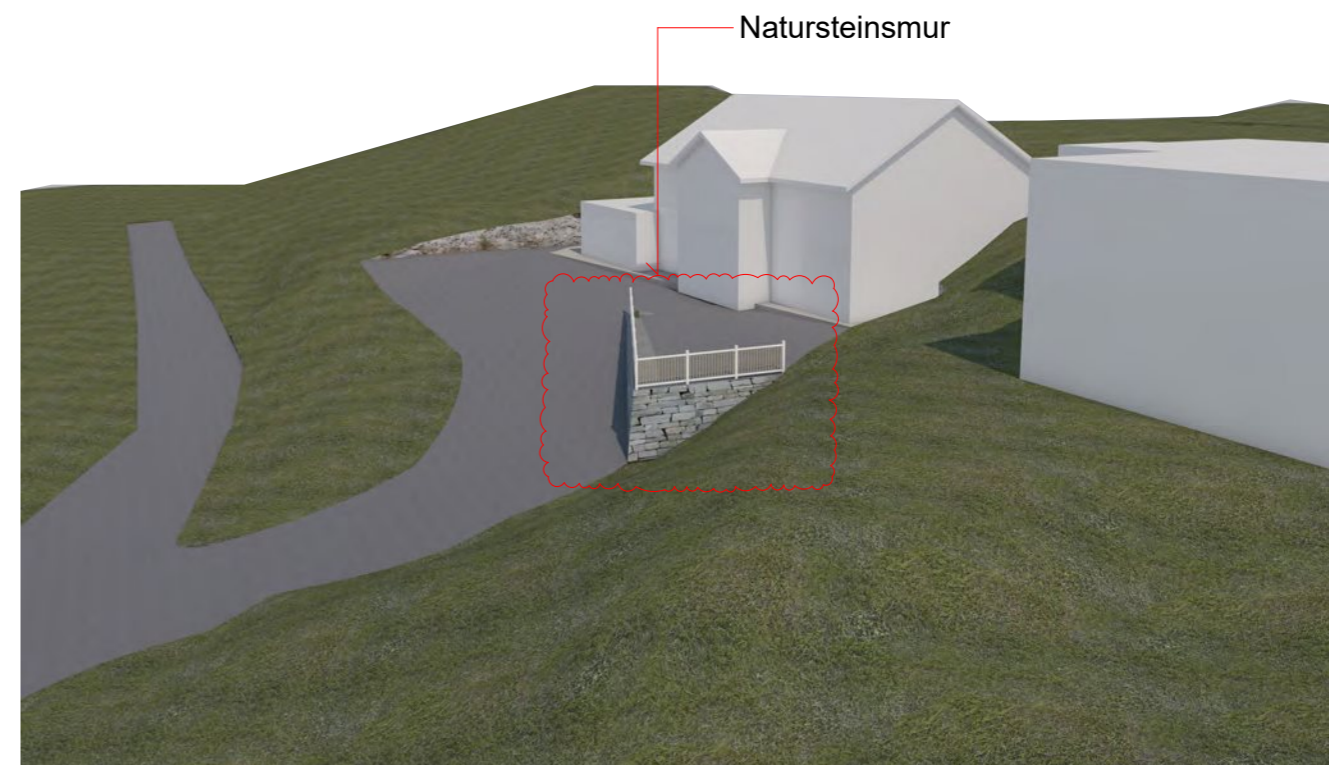


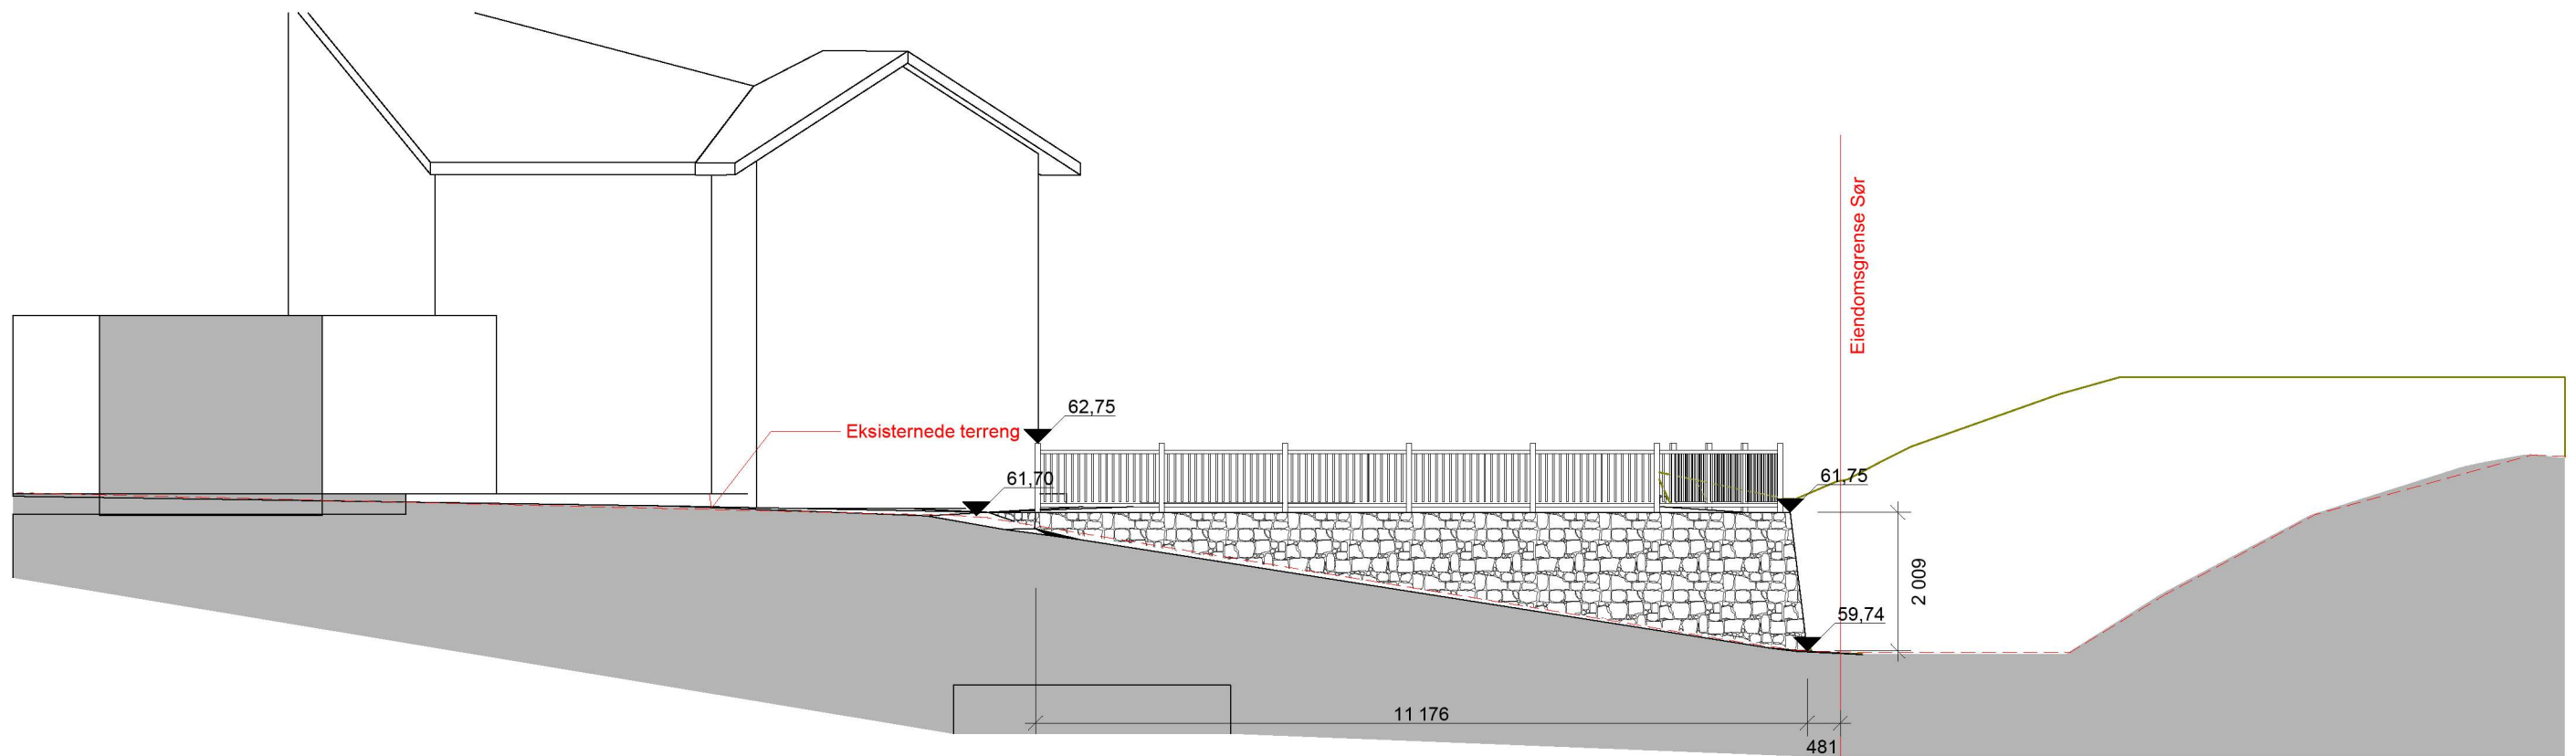

1:100 Snitt A

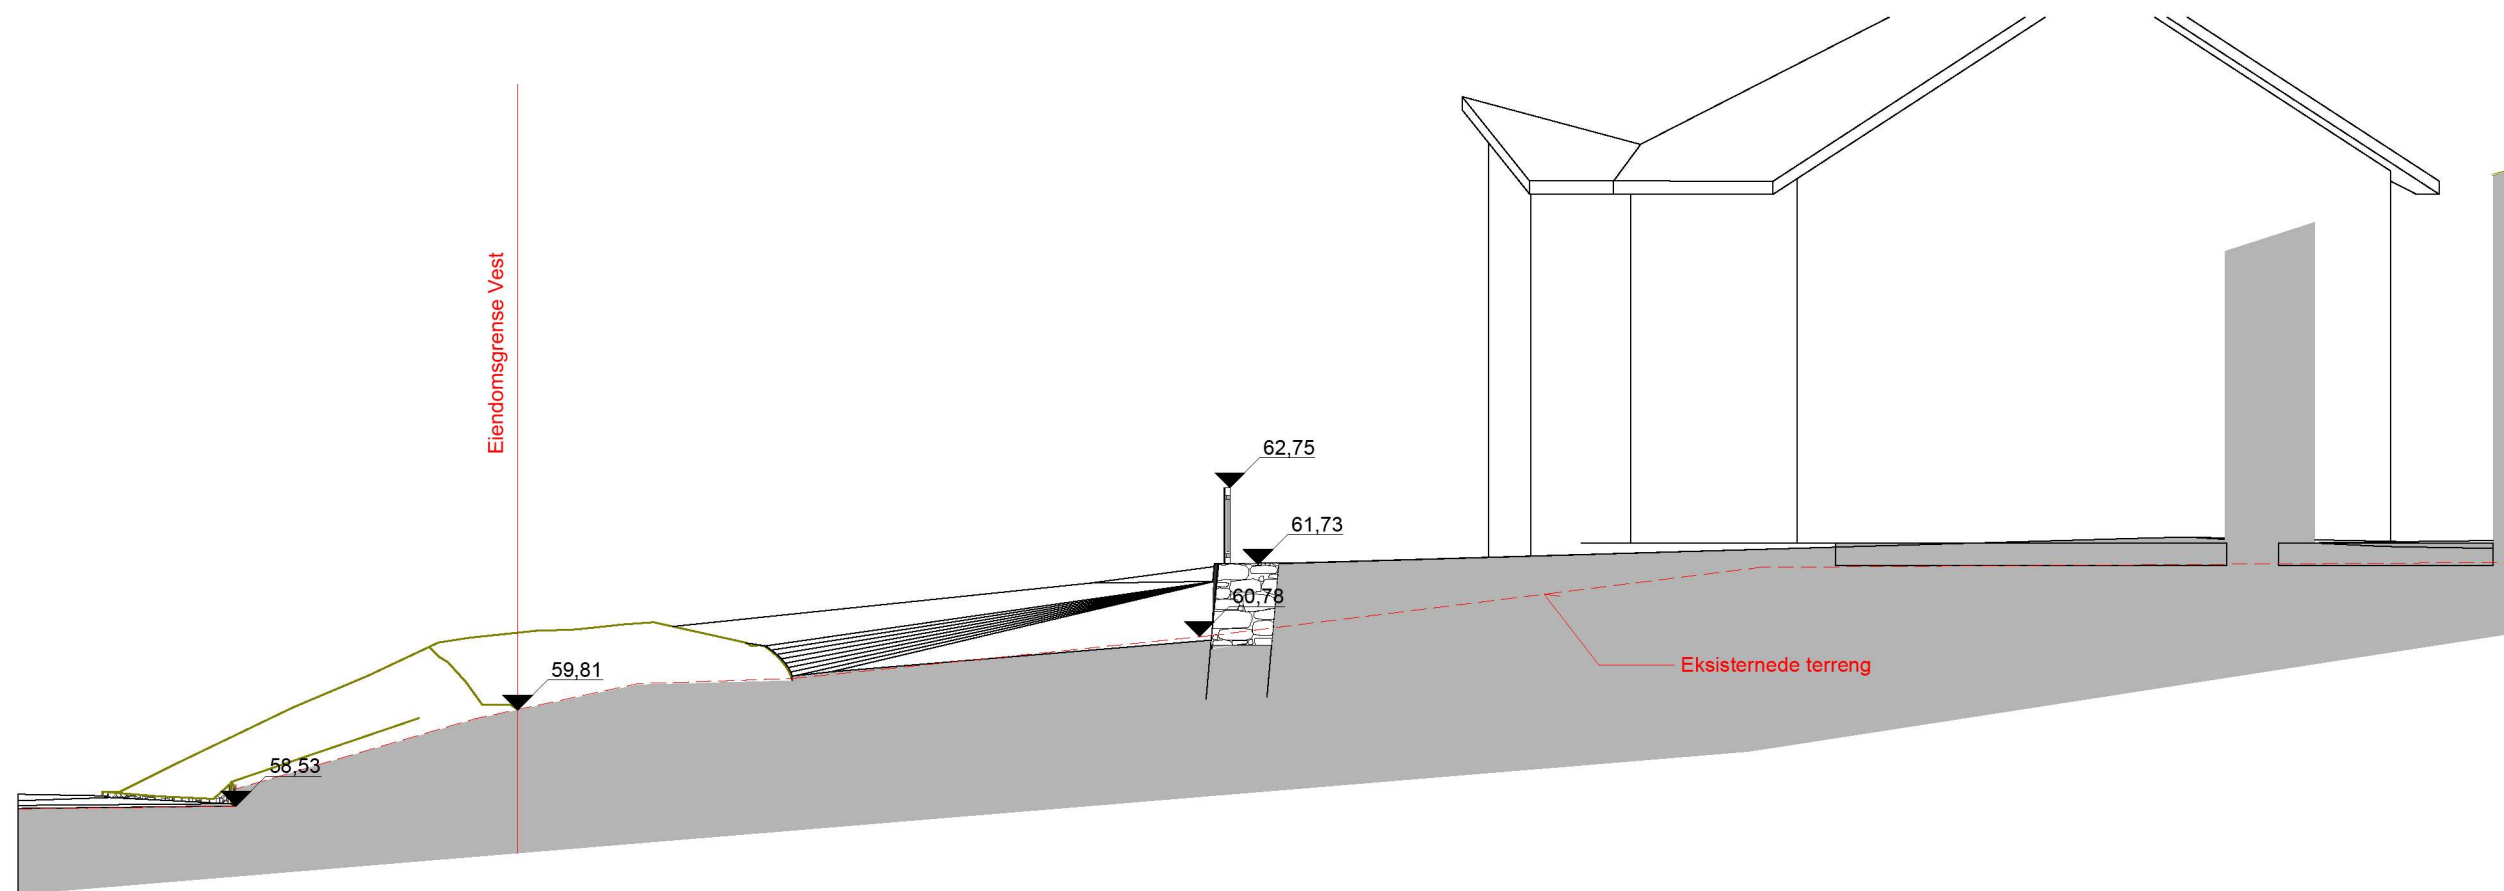

1:100 Snitt B

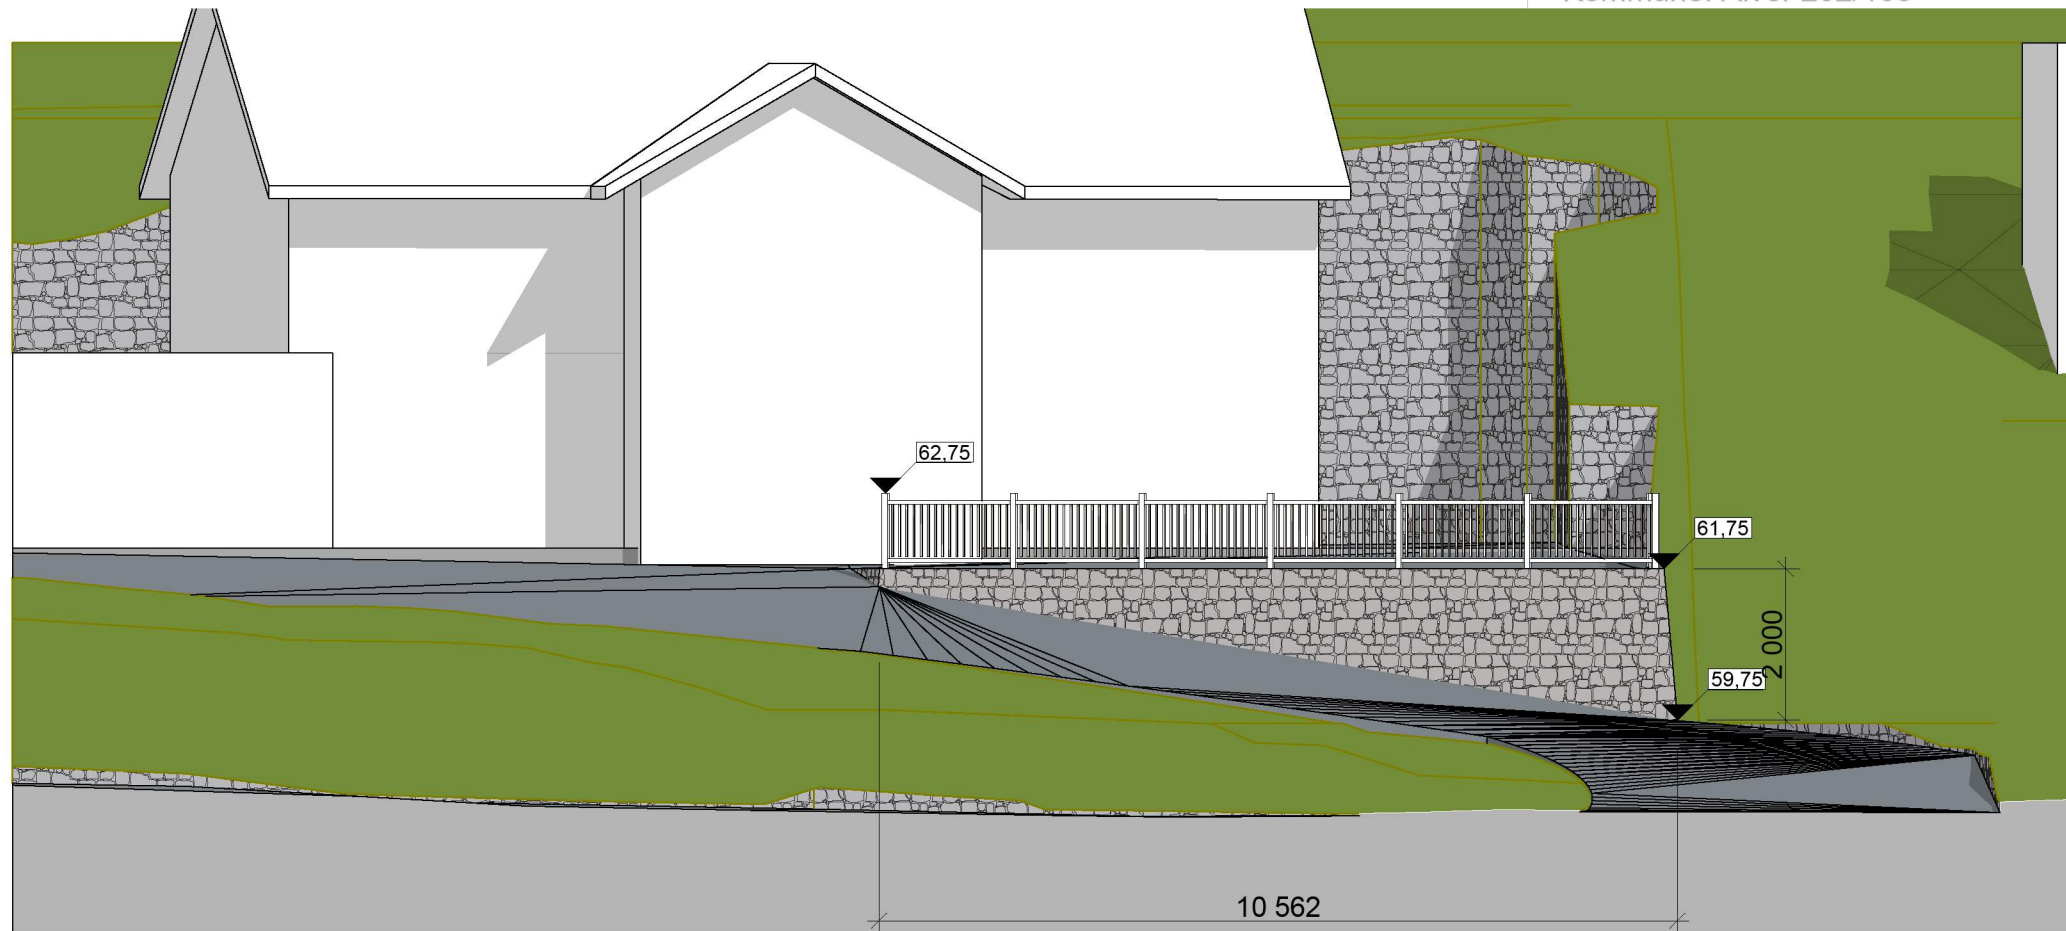

1:100 Fasade Vest

