


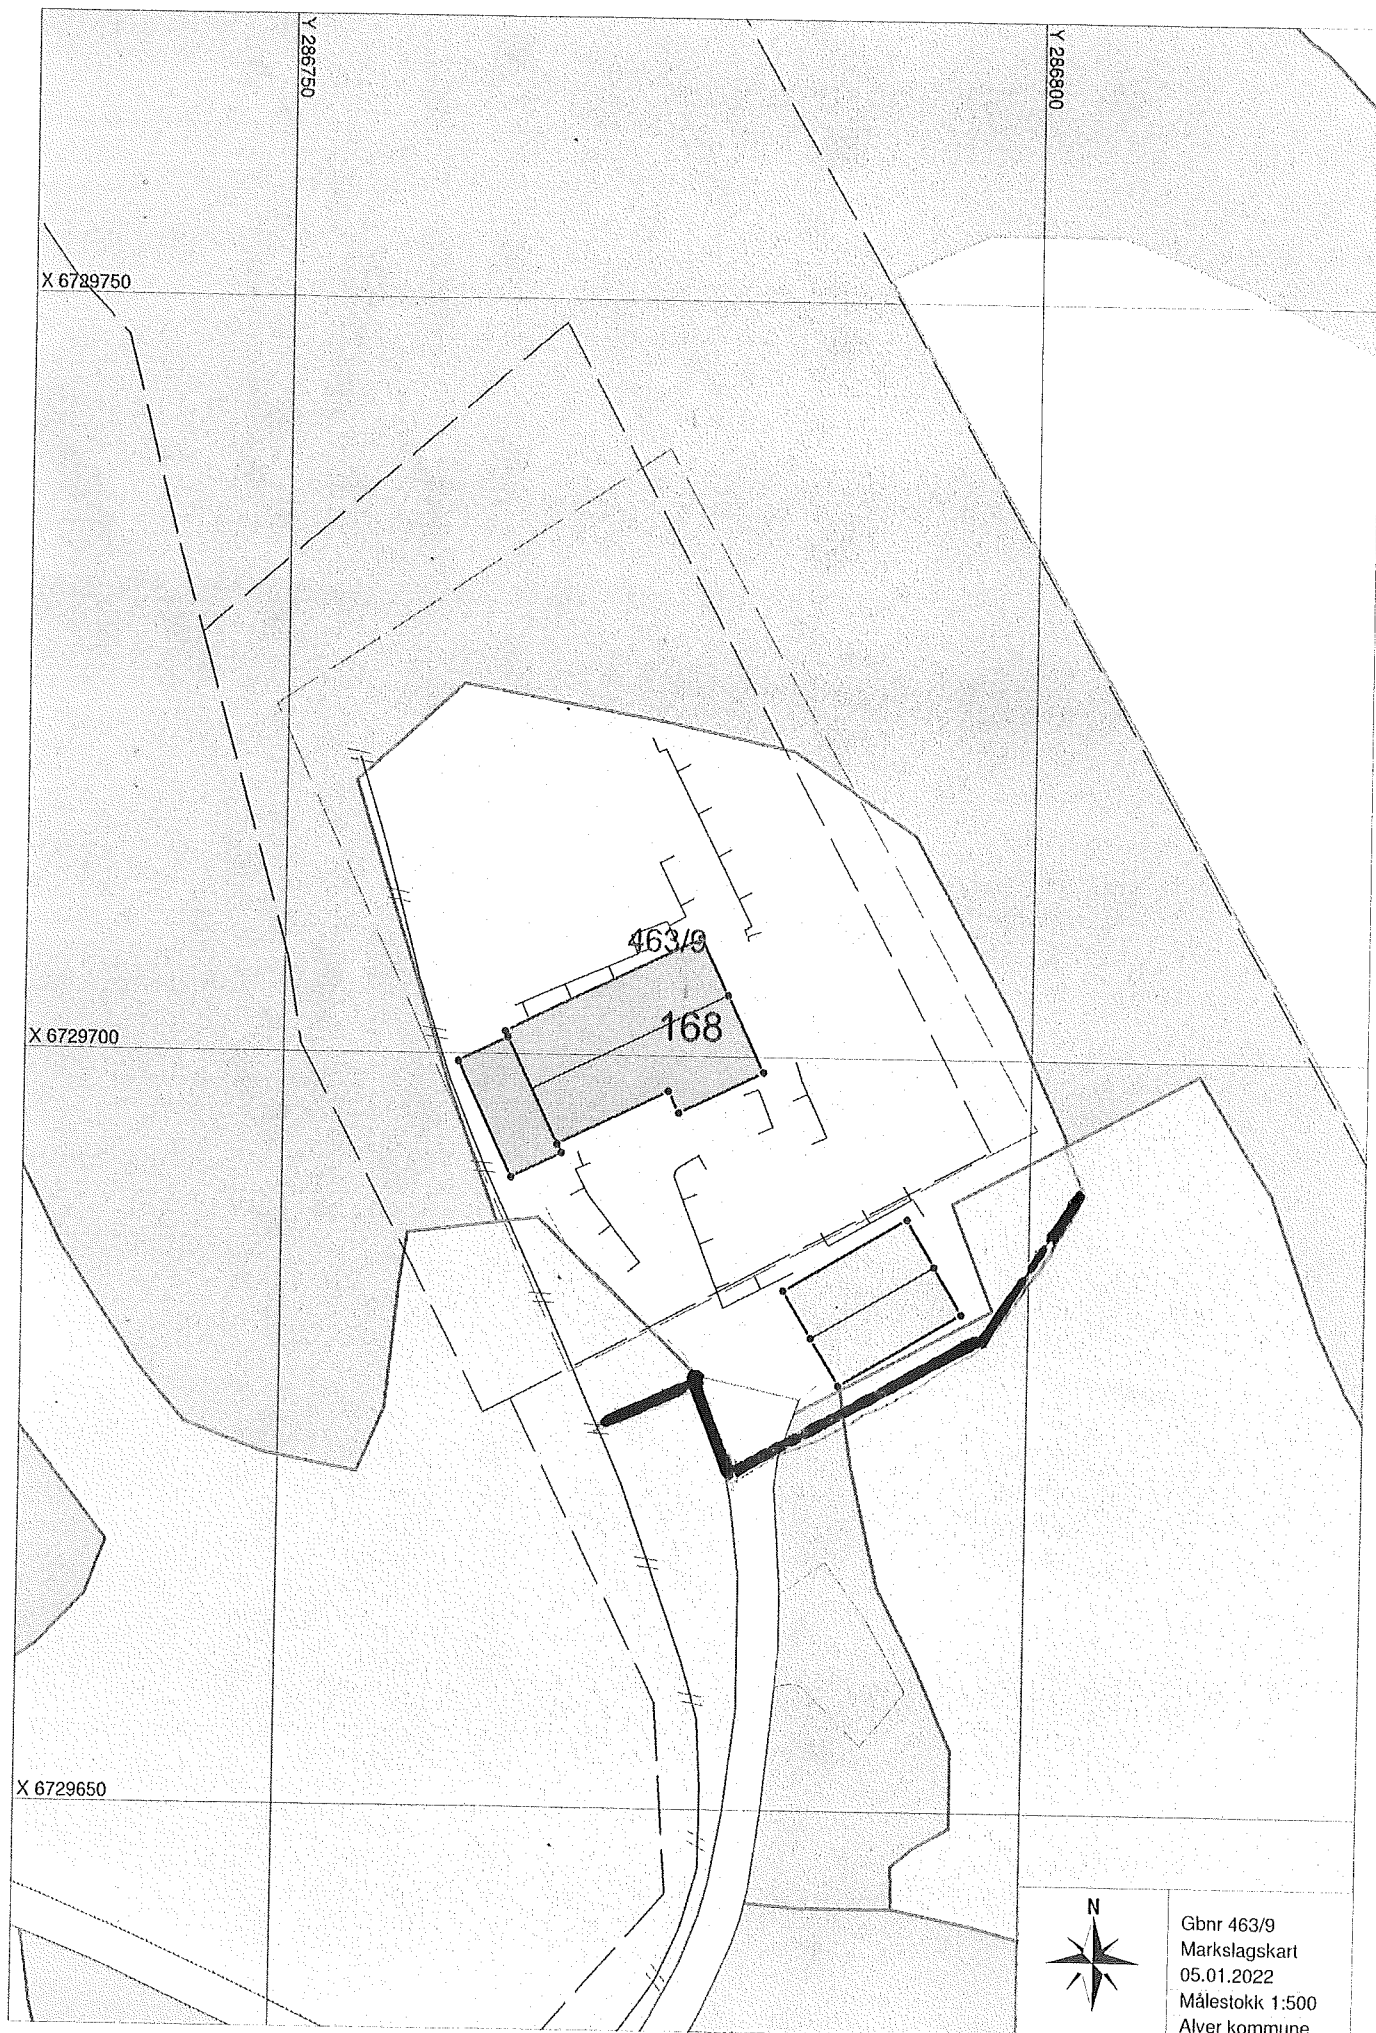

Gbnr 463/9
Markslagskart
05.01.2022
Målestokk 1:500
Alver kommune