


E1

ORIGINAL TEIKNING 13.04.95 M 1:100  
STEINAR SAGEN ALS - DIKHAUGEN-VADAN  
GBNR 137/532  
UTVIDING AV TERRASSE - ETABL. CARPORT OTTO.22  
INGTAUKE ALS - RADDVEGEN 1400, 5936 MÅNØER

TILTAKSSTAVER  
RUNAR HAUGEN

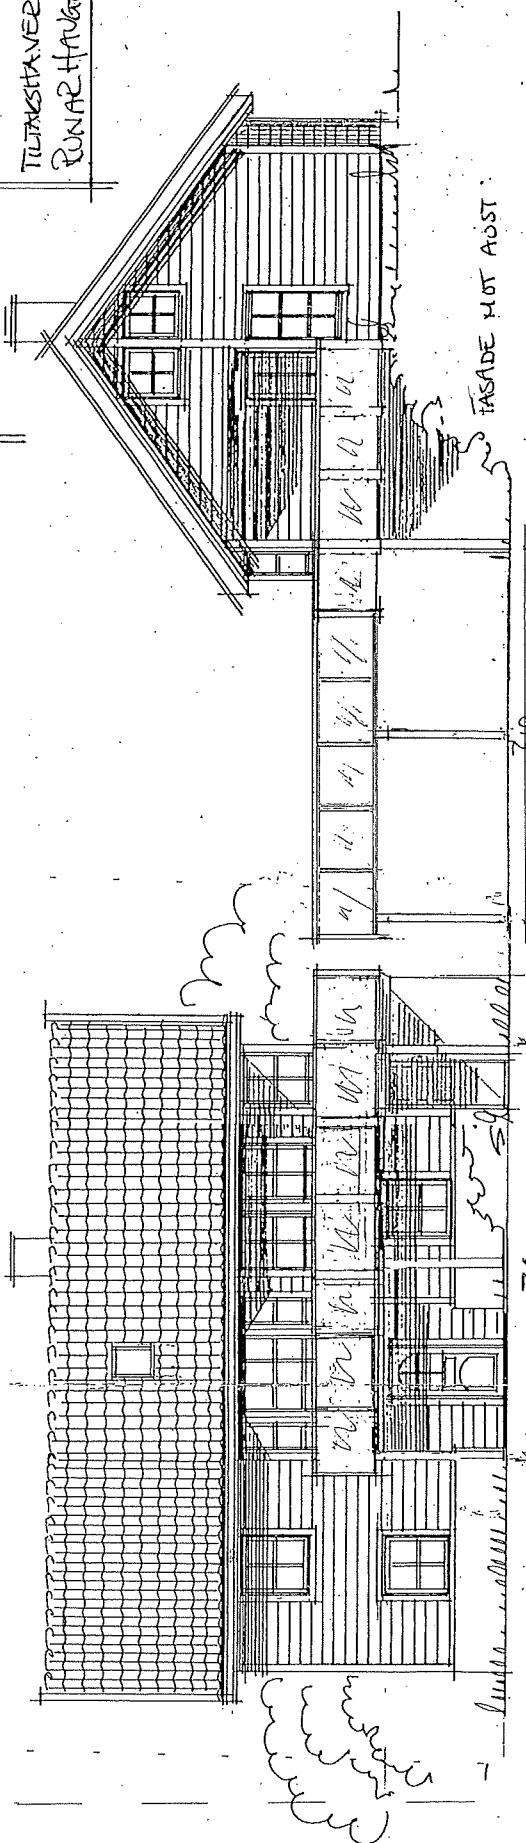


FASADE MOT ØST

**TAULE**  
ING. TAULE AS  
TEL 99 85 85 85 - Mobil 908 66 010  
11-22


7.0

7.0

FASADE MOT SØR

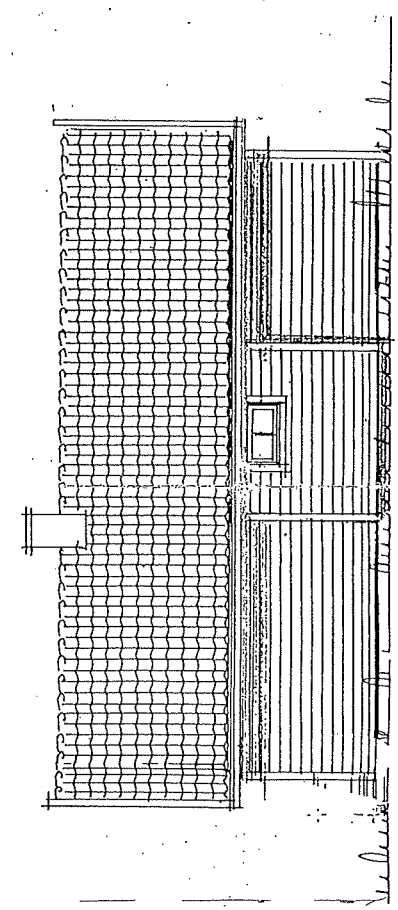


FASADE MOT SØR

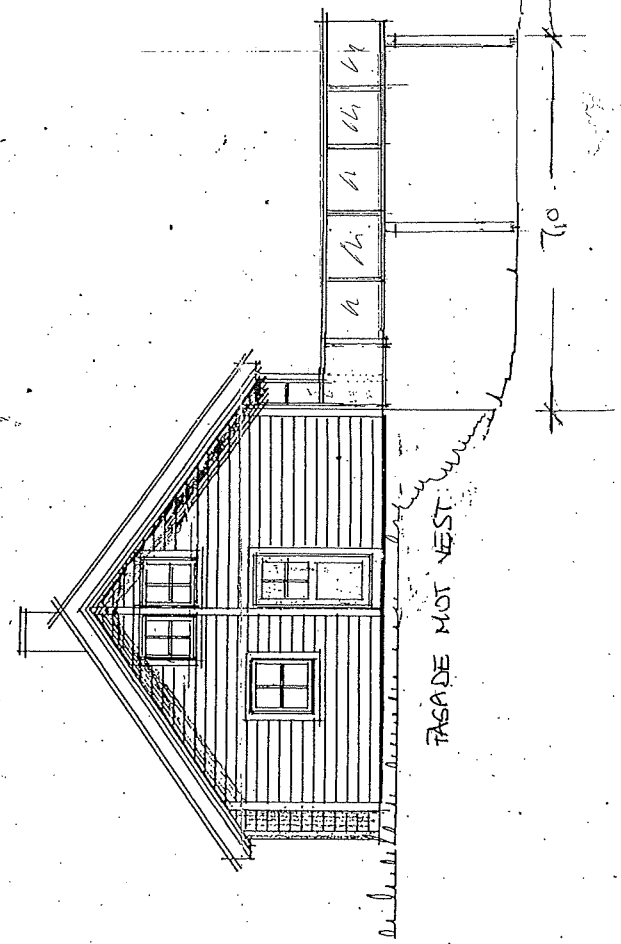


FASADE MOT VEST

7.0

E2

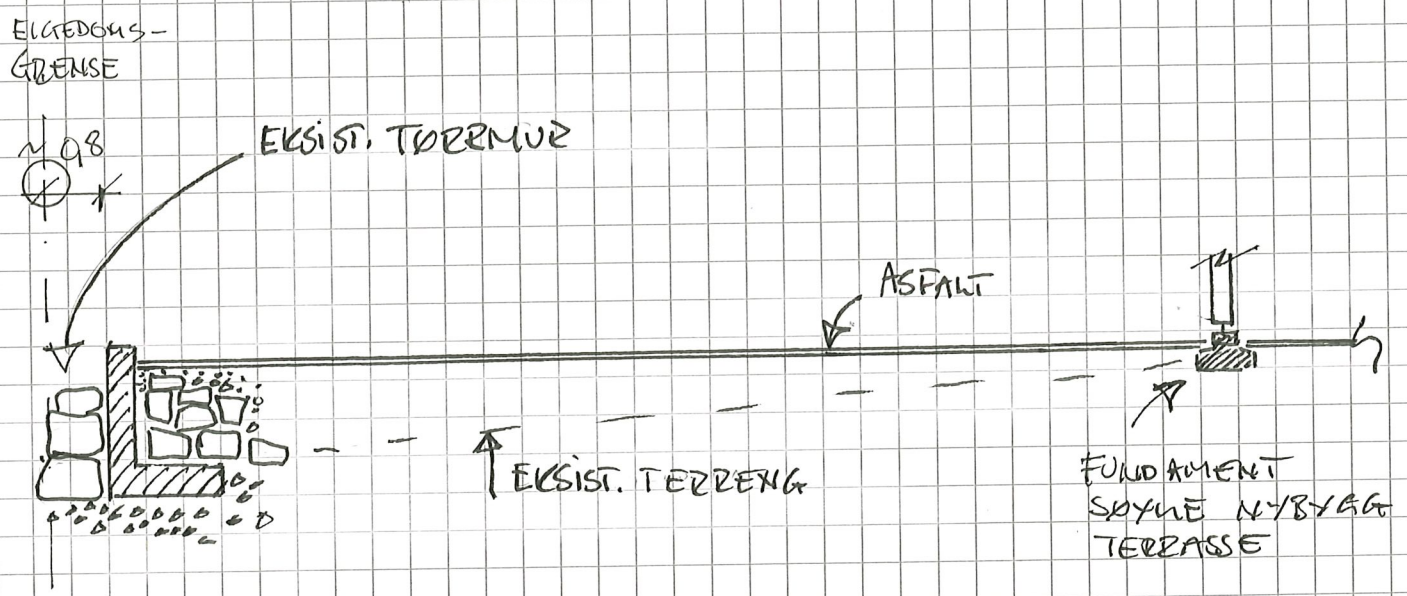

SKITT A-A OG  
TYPISK SKITT BETONGMUR  
M. 1850  
GBNR. 137/532  
KUBBALEITET 26  
5916 - ISDALSTØ  
TILTAKESTAVEN & RUNAR HAUGEN

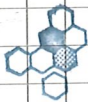 **TAULE**  
ING. TAULE AS  
Tlf. 56 35 85 55 - Mob. 908 66 010  
TA 711-22