




Radøy, gnr 85 bnr 40,
Data på innmålt grunnmur

08.06.2017

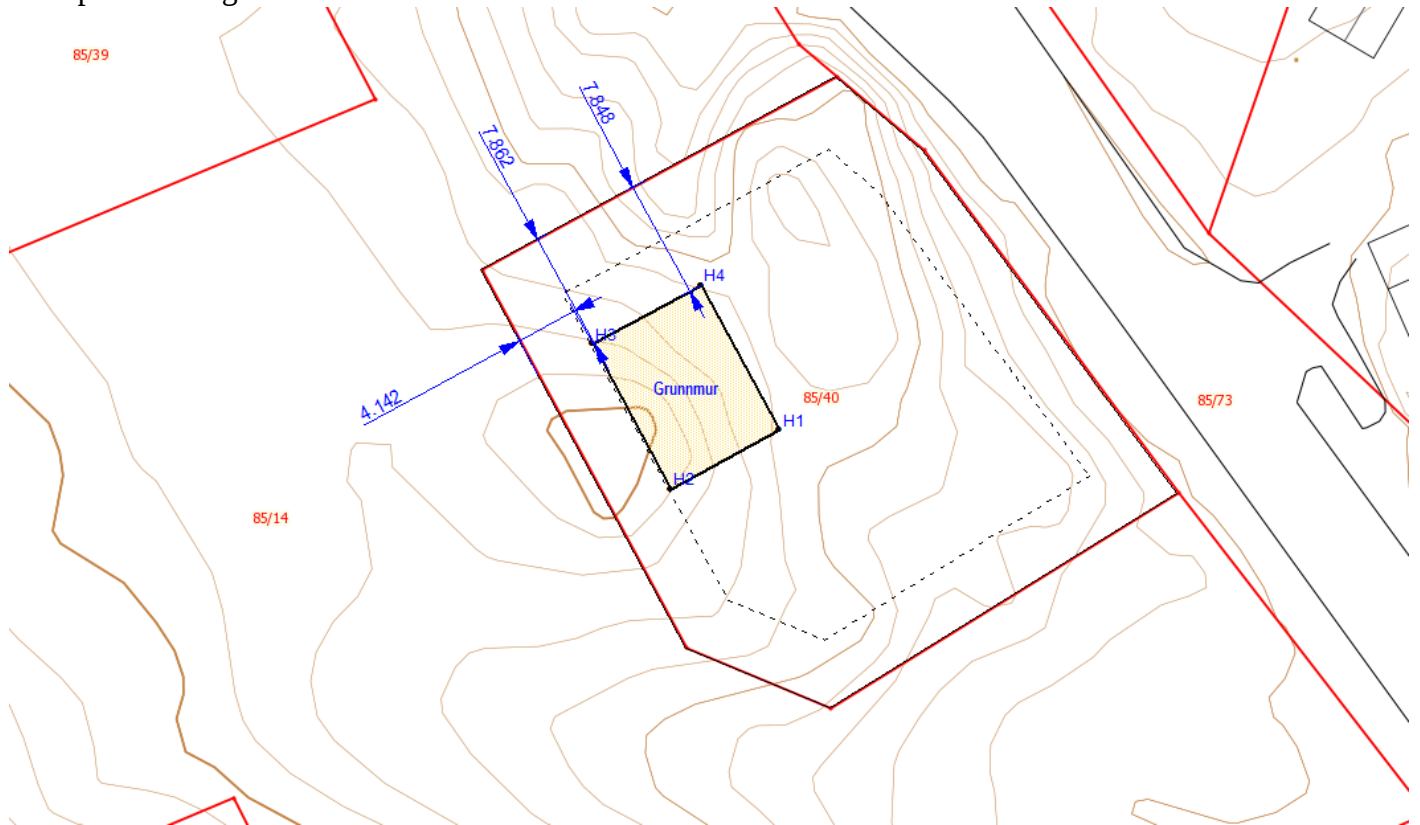

PunktID	N-koord.	Ø-koord.	Høyde
H1	6724433,05	291869,10	45,40
H2	6724429,12	291861,88	45,40
H3	6724438,70	291856,69	45,43
H4	6724442,64	291863,90	45,42