


Snitt 1
1:50

Takmene 3400
Innertak 2400
Gavl vegg 2050
Etg 1 0




Snitt 1 (med skanning)
1:50

Takmene 3400
Innertak 2400
Gavl vegg 2050
Etg 1 0

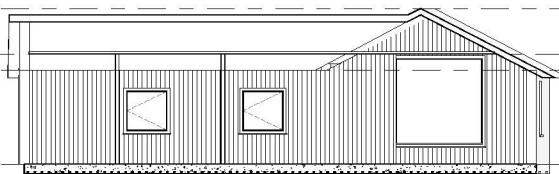


Snitt 2
1:50

Takmene 3400
Innertak 2400
Gavl vegg 2050
Etg 1 0

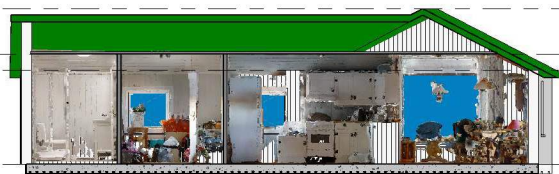


Snitt 2 (med skanning)
1:50

Takmene 3400
Innertak 2400
Gavl vegg 2050
Etg 1 0

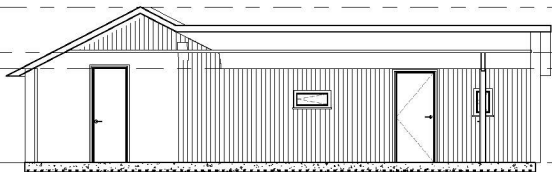


Snitt 3
1:50

Takmene 3400
Innertak 2400
Gavl vegg 2050
Etg 1 0

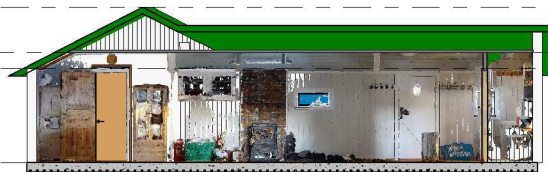

Snitt 3 (med skanning)
1:50

Takmene 3400
Innertak 2400
Gavl vegg 2050
Etg 1 0

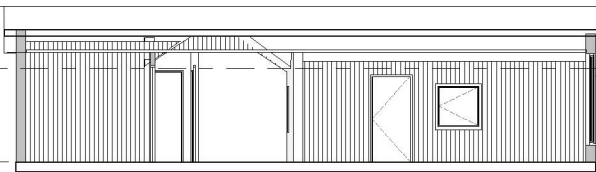

Snitt 4
1:50

Takmene 3400
Innertak 2400
Gavl vegg 2050
Etg 1 0



Snitt 4 (med skanning)
1:50

Takmene 3400
Innertak 2400
Gavl vegg 2050
Etg 1 0

Tiltakshaver:
Inge Fyllingsnes
Holding AS

Rev	Description	Date

CODE	SUITABILITY DESCRIPTION
STATUS	PURPOSE OF ISSUE

AUTODESK
www.autodesk.com/revit

PROJECT
Litlevaagsbrotet 26
G.nr 214 B.nr 44

TITLE
Snitt

CLIENT
Inge Fyllingsnes

DRAWN BY Author	CHECKED BY Checker	DATE 12/16/21
SCALE (@ A1) 1:50	PROJECT NUMBER Project Number	
DRAWING NUMBER A103	REV	