
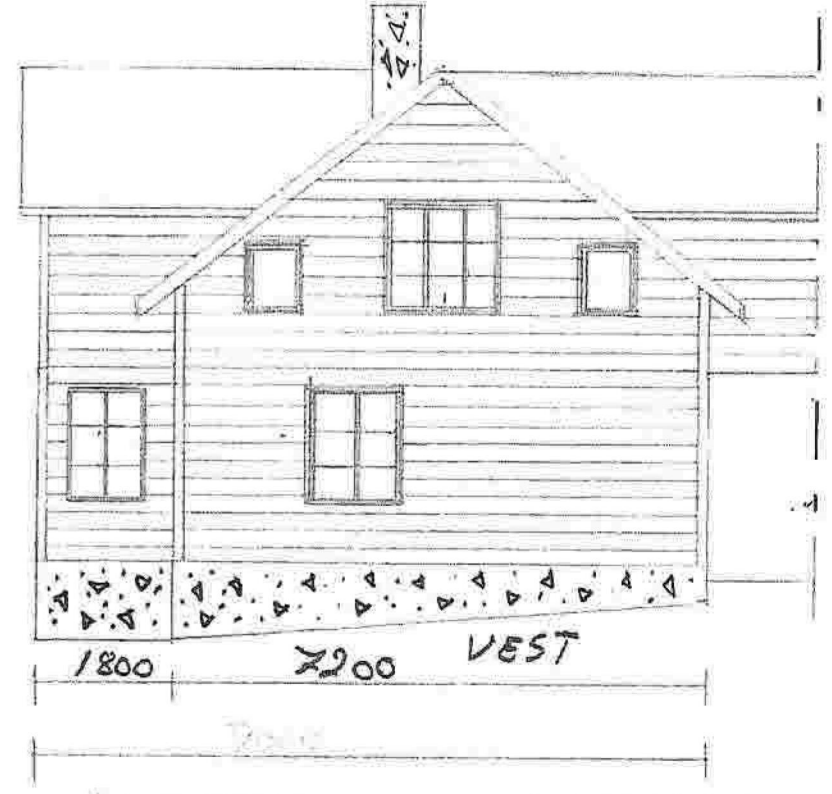


M.	11100
...	05.02.202
...	...
...	...

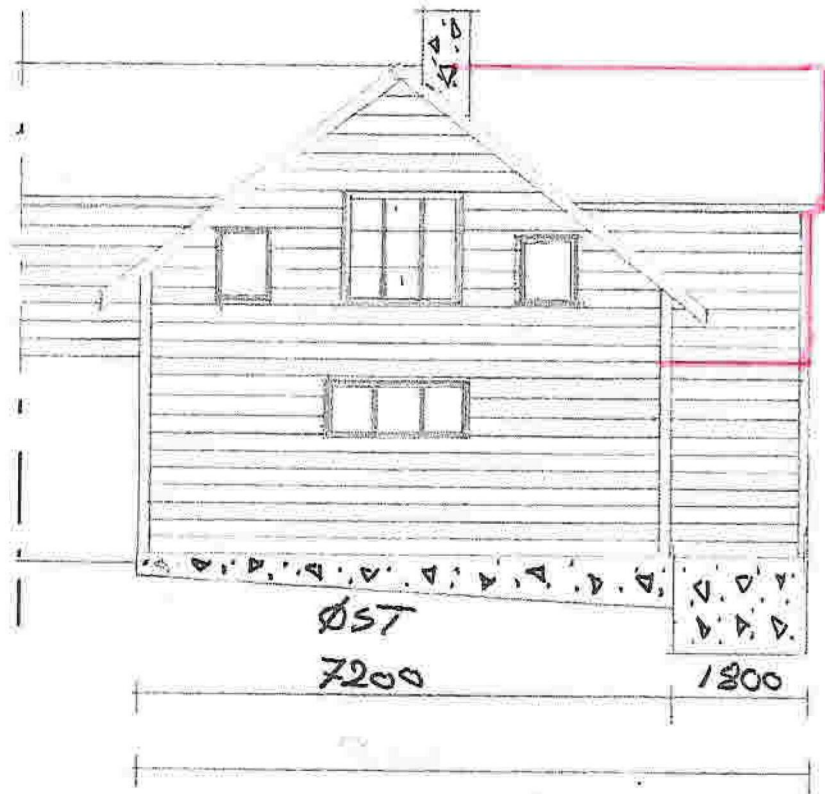

	1:100
DATO	07.02.2022
FASADE TEGNING	ØST / VEST
VEINUNG SE 1 M	