


Målestokk: 1:500
 Dato: 18-01-2022

Nhdigi.no

Situasjonskart - T:bygg store +
 Car-port for
 Ole Nils Husebo og
 Gisle Gunnar Husebo
 gnr. 309 bnr. 204/129
 Fnrh: 02, 02, 22 22

Tilbak 1092

309/2

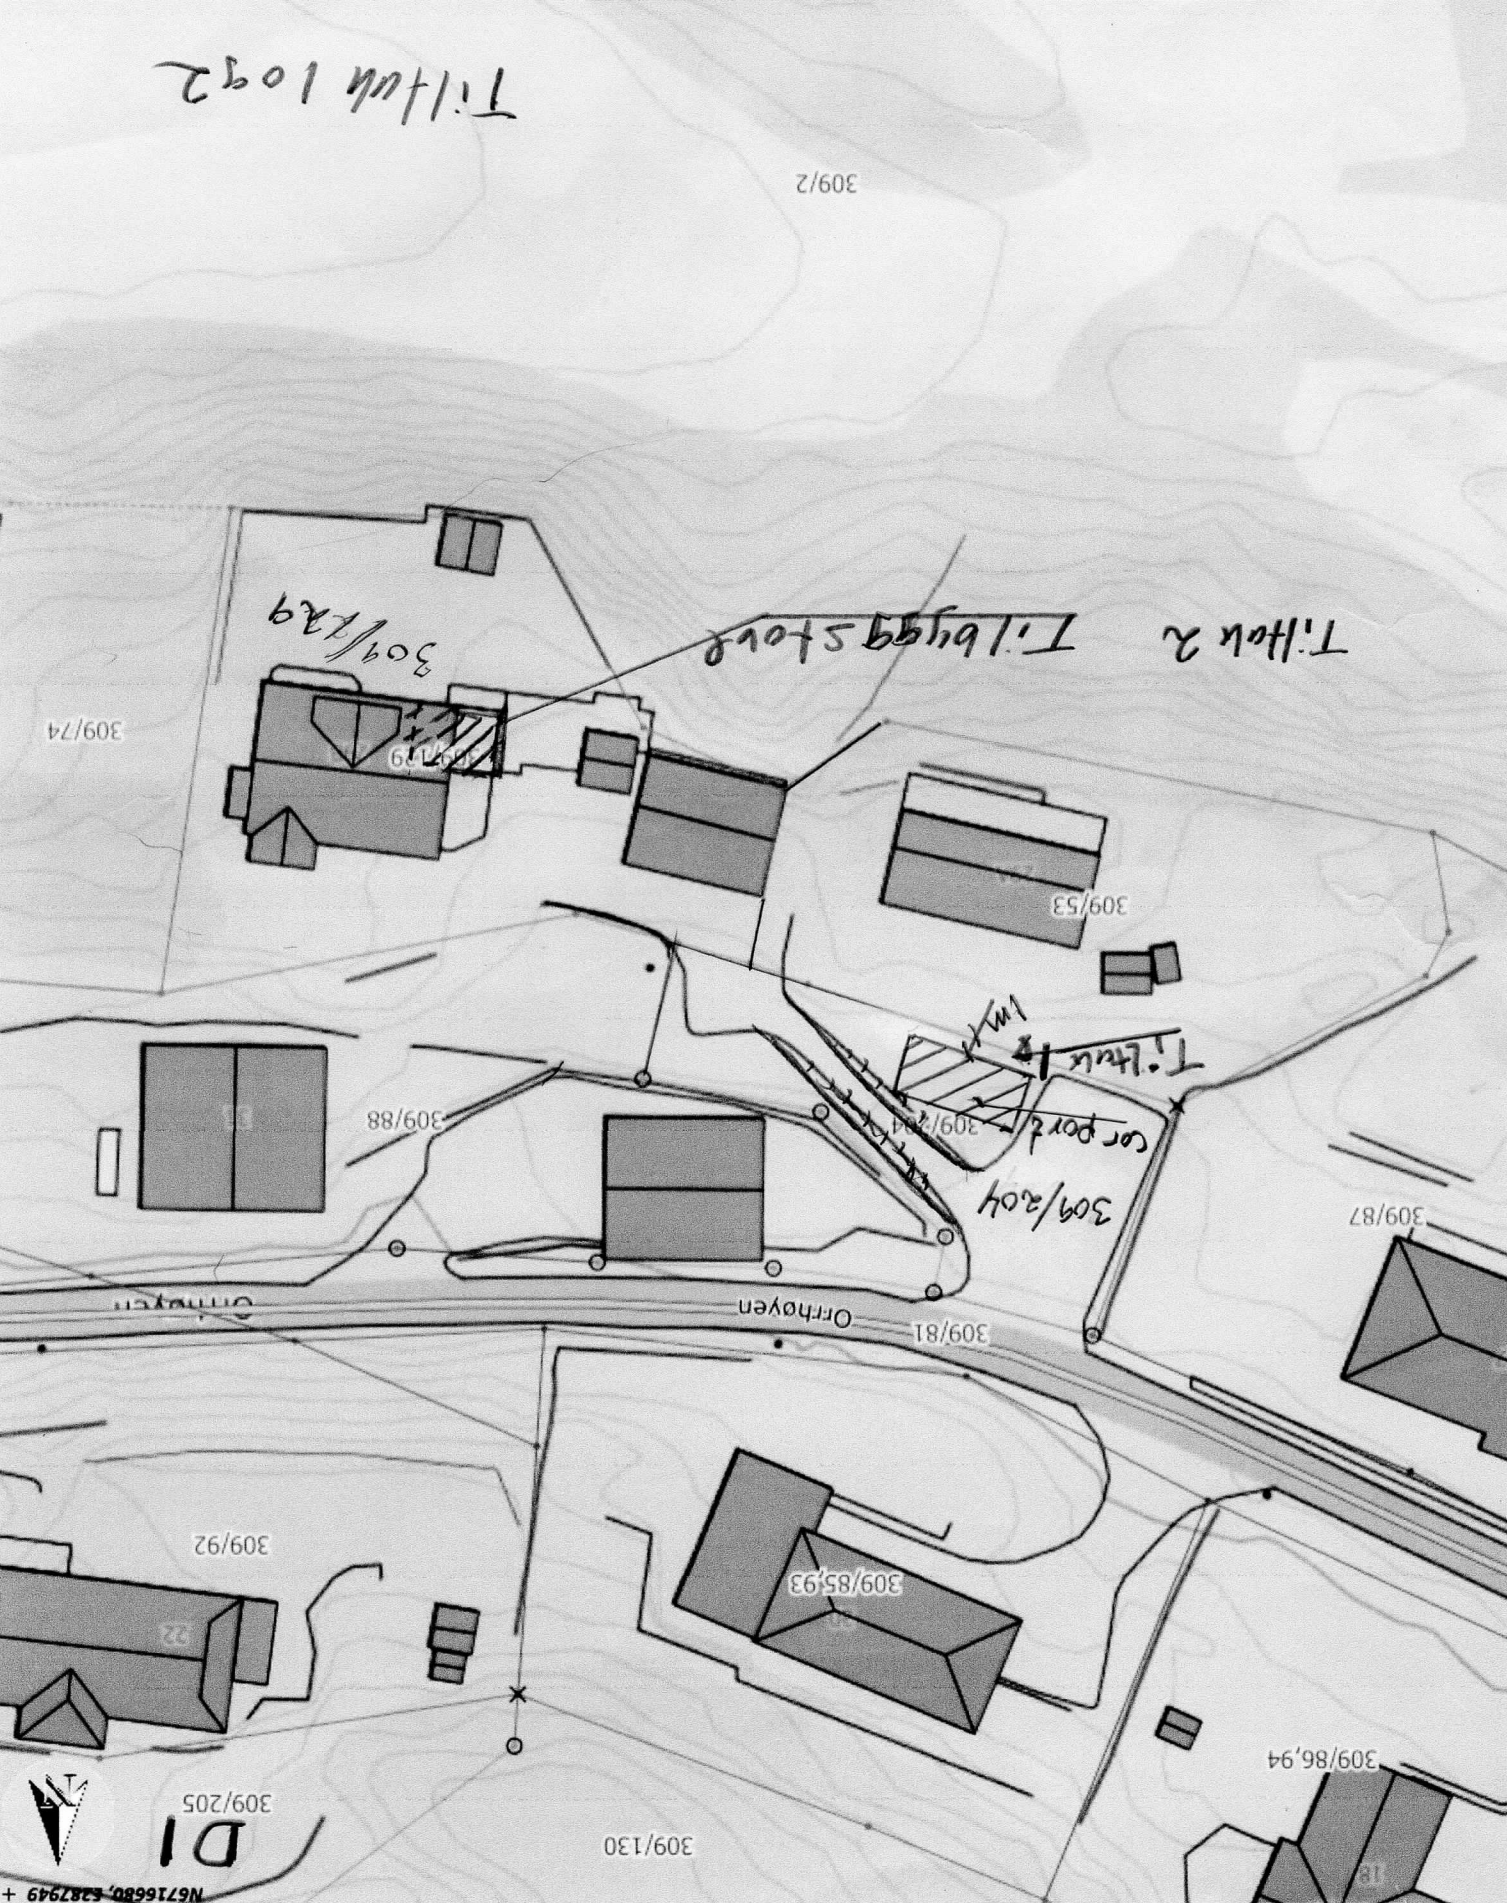

309/74

309/229

Tilbak 2 T:bygg store

309/53

Tilbak 18

Car port

309/204

309/88

309/87

Orhøyen

309/81

309/85,93

309/92

309/86,94

D1 309/205

309/130

