


FASADE SUR.

3 GE VIGLET NYHAMMETER

KORRIGERT 24.1.17  
KORRIGERT 6.12.21

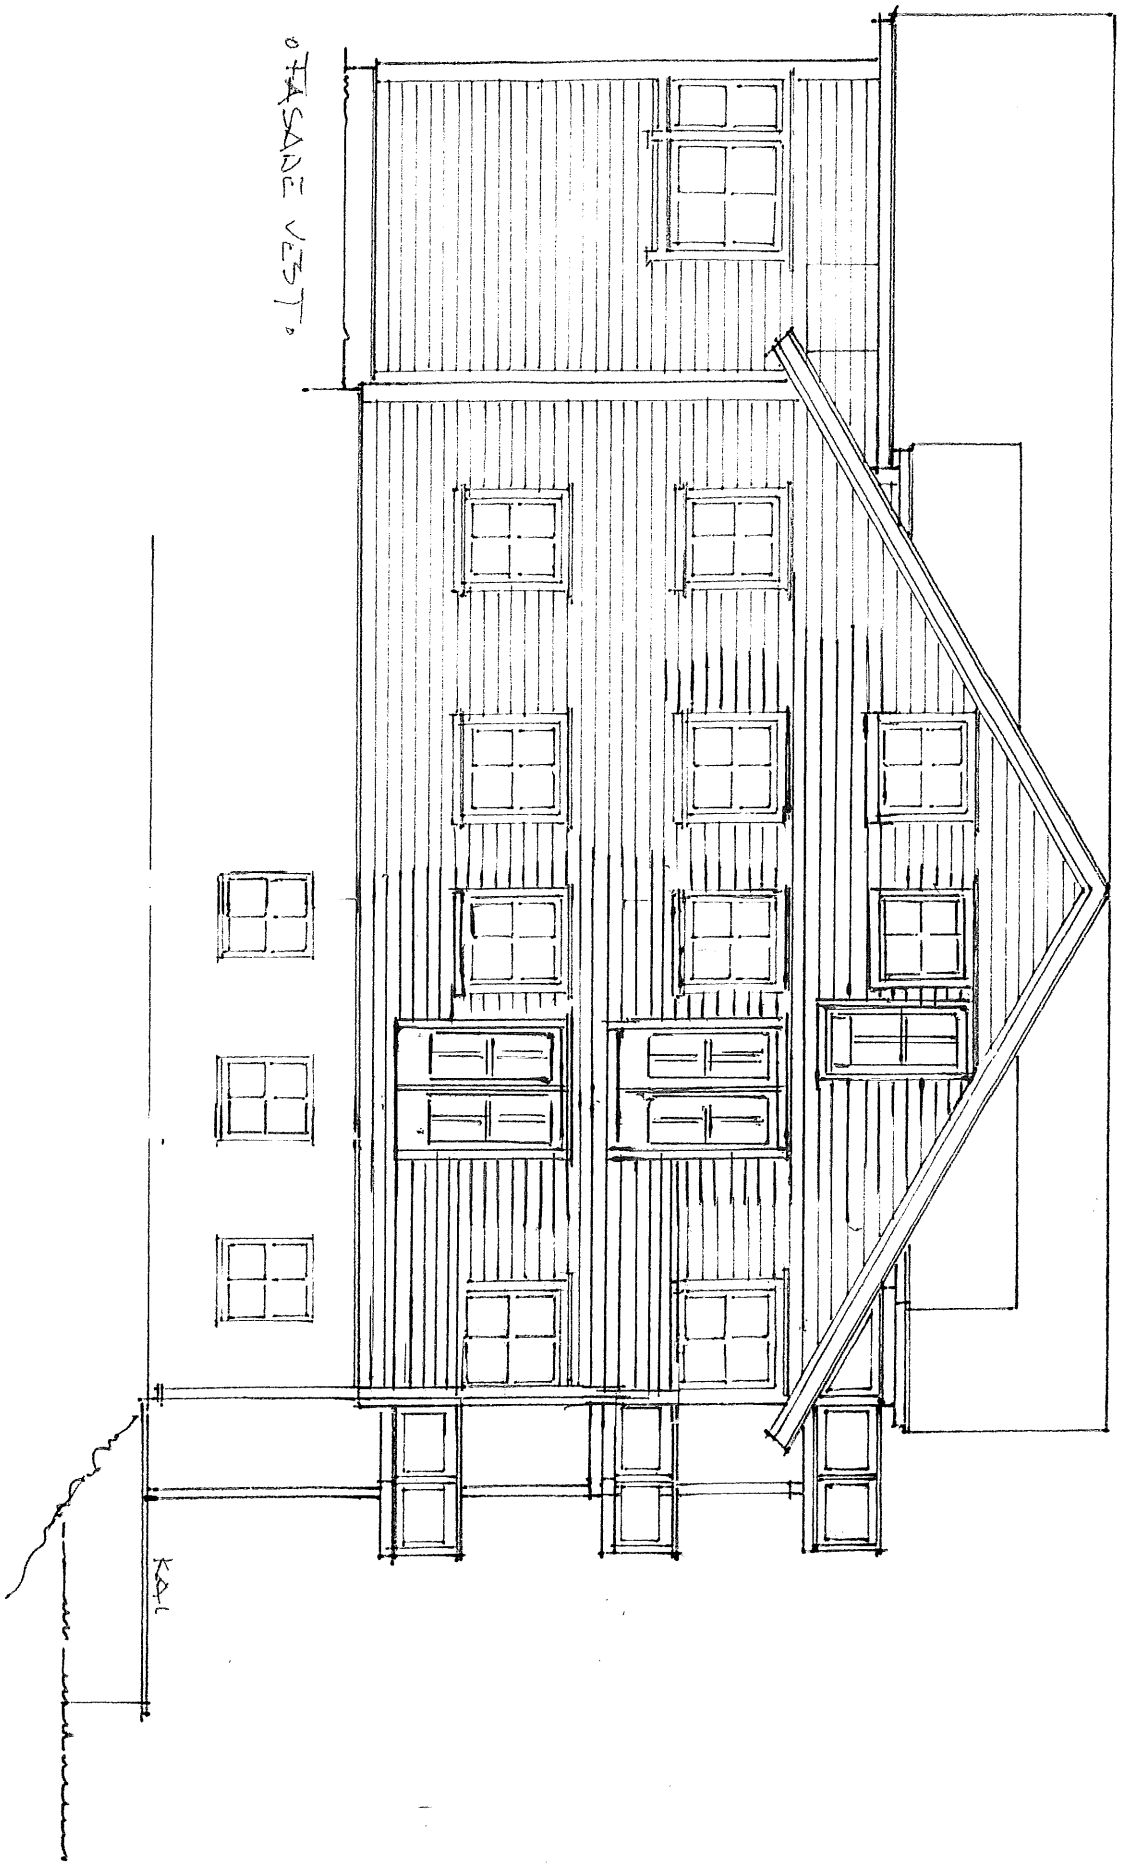



ORGE VIKLETA NYHÅLLER

KAL

KORRIKORT 24.9.17  
KORRIKORT 6.12.21

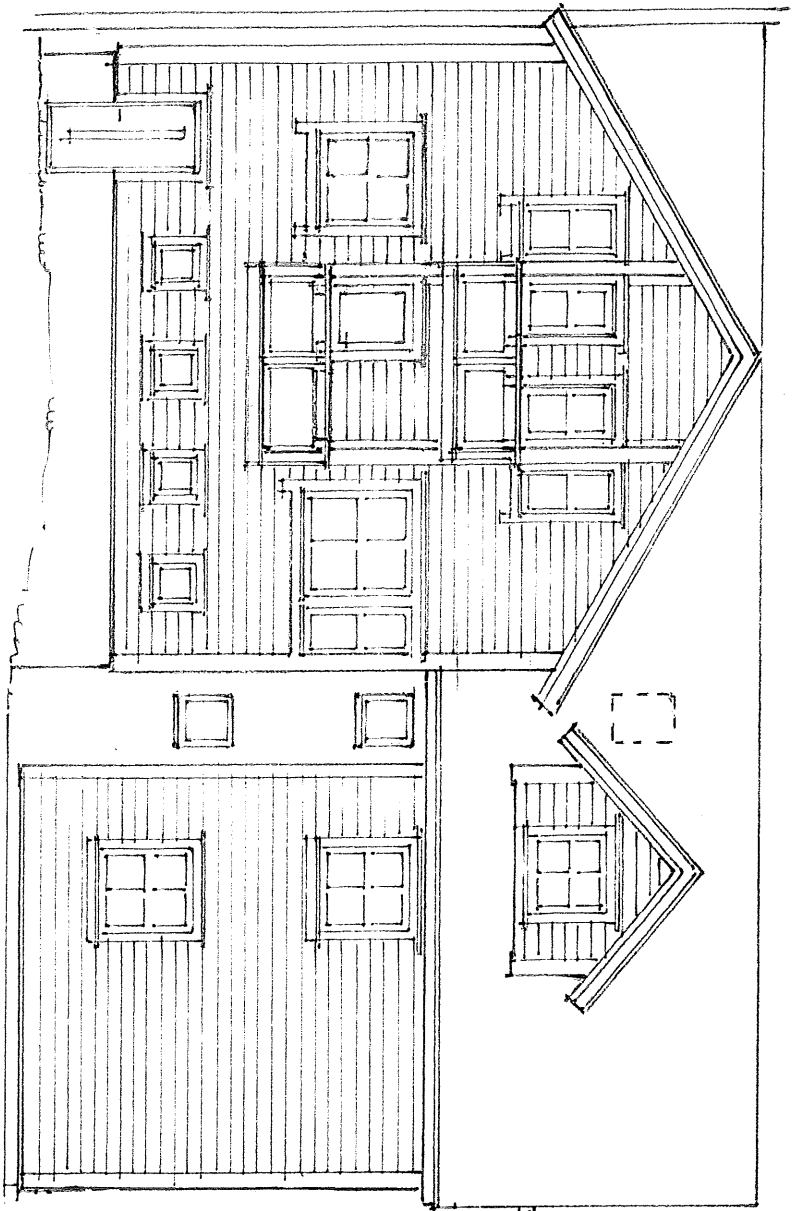


2 FASADE NORD

REG MALEK WAXLER

KORREKTUR 24.9.17  
KORREKTUR 6.12.21


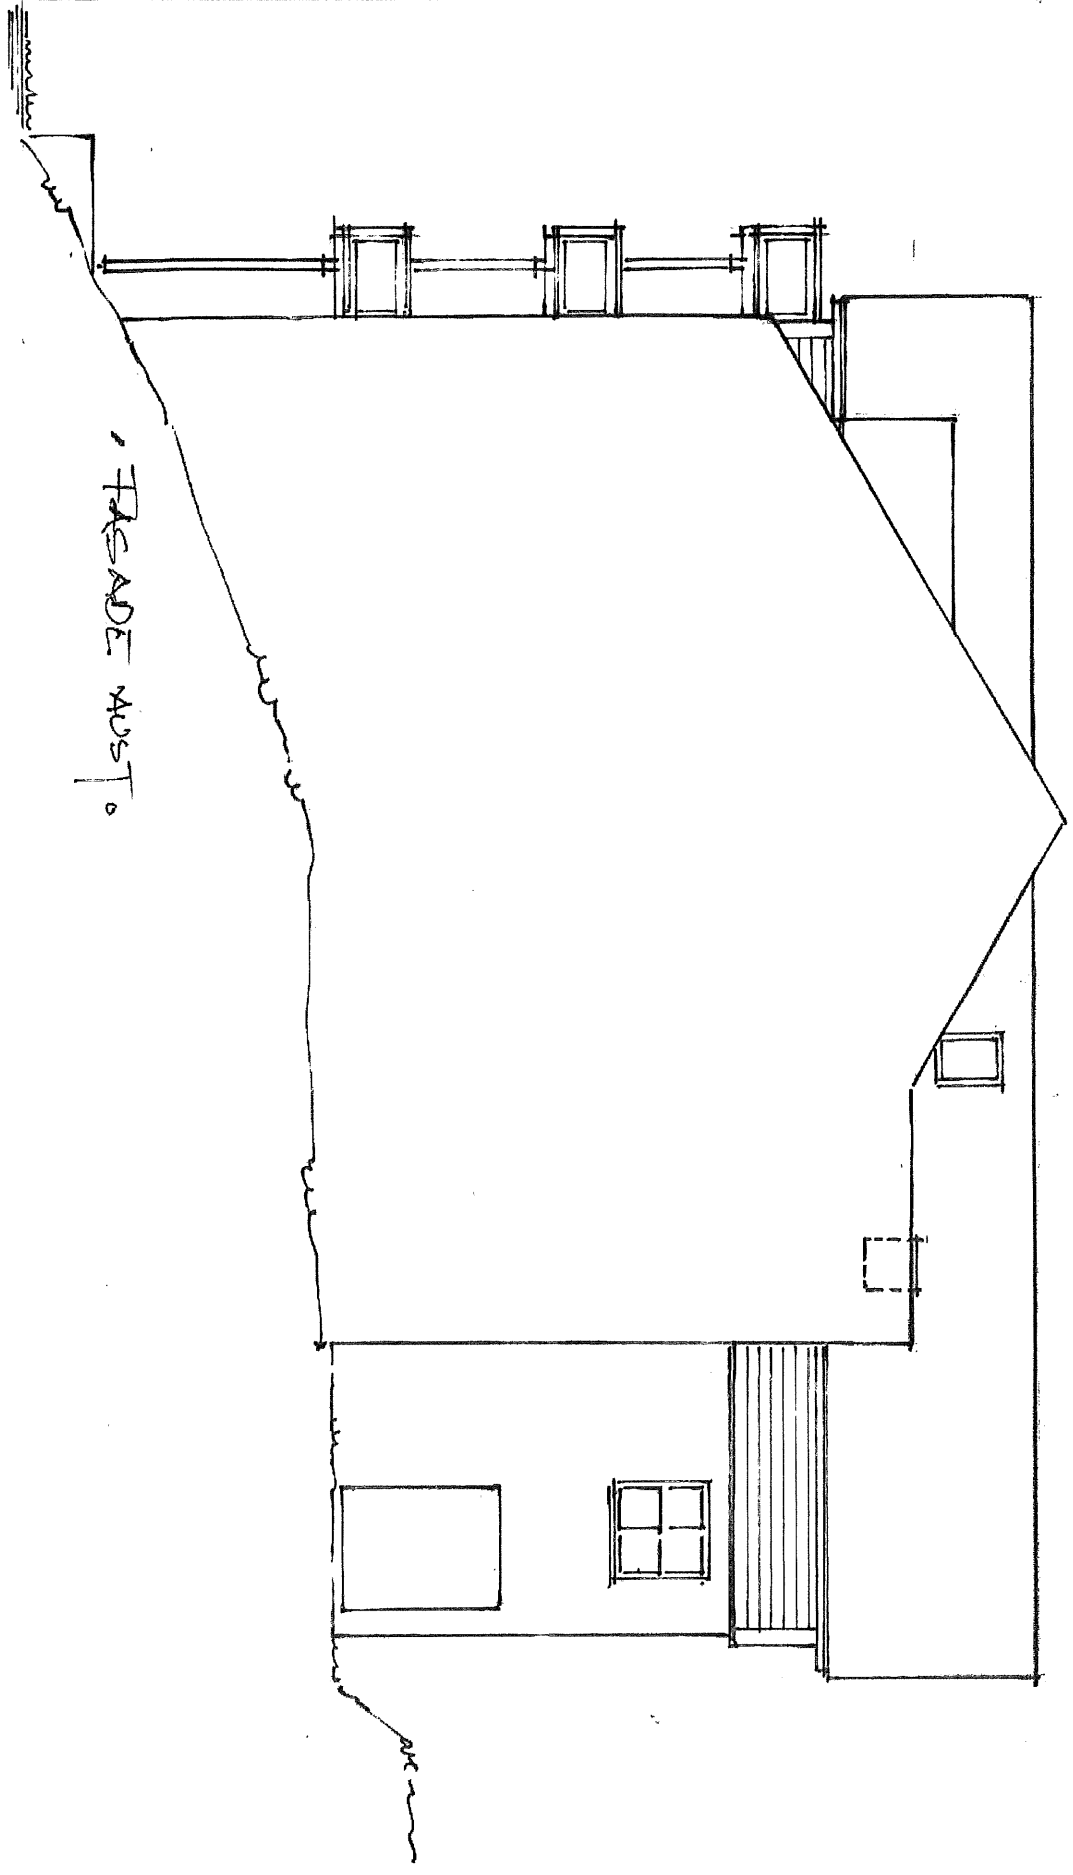

AGE VIGLEIK NYHAMMER

RDV. 13.8.-19