




315/7

Høyveggen 315/27

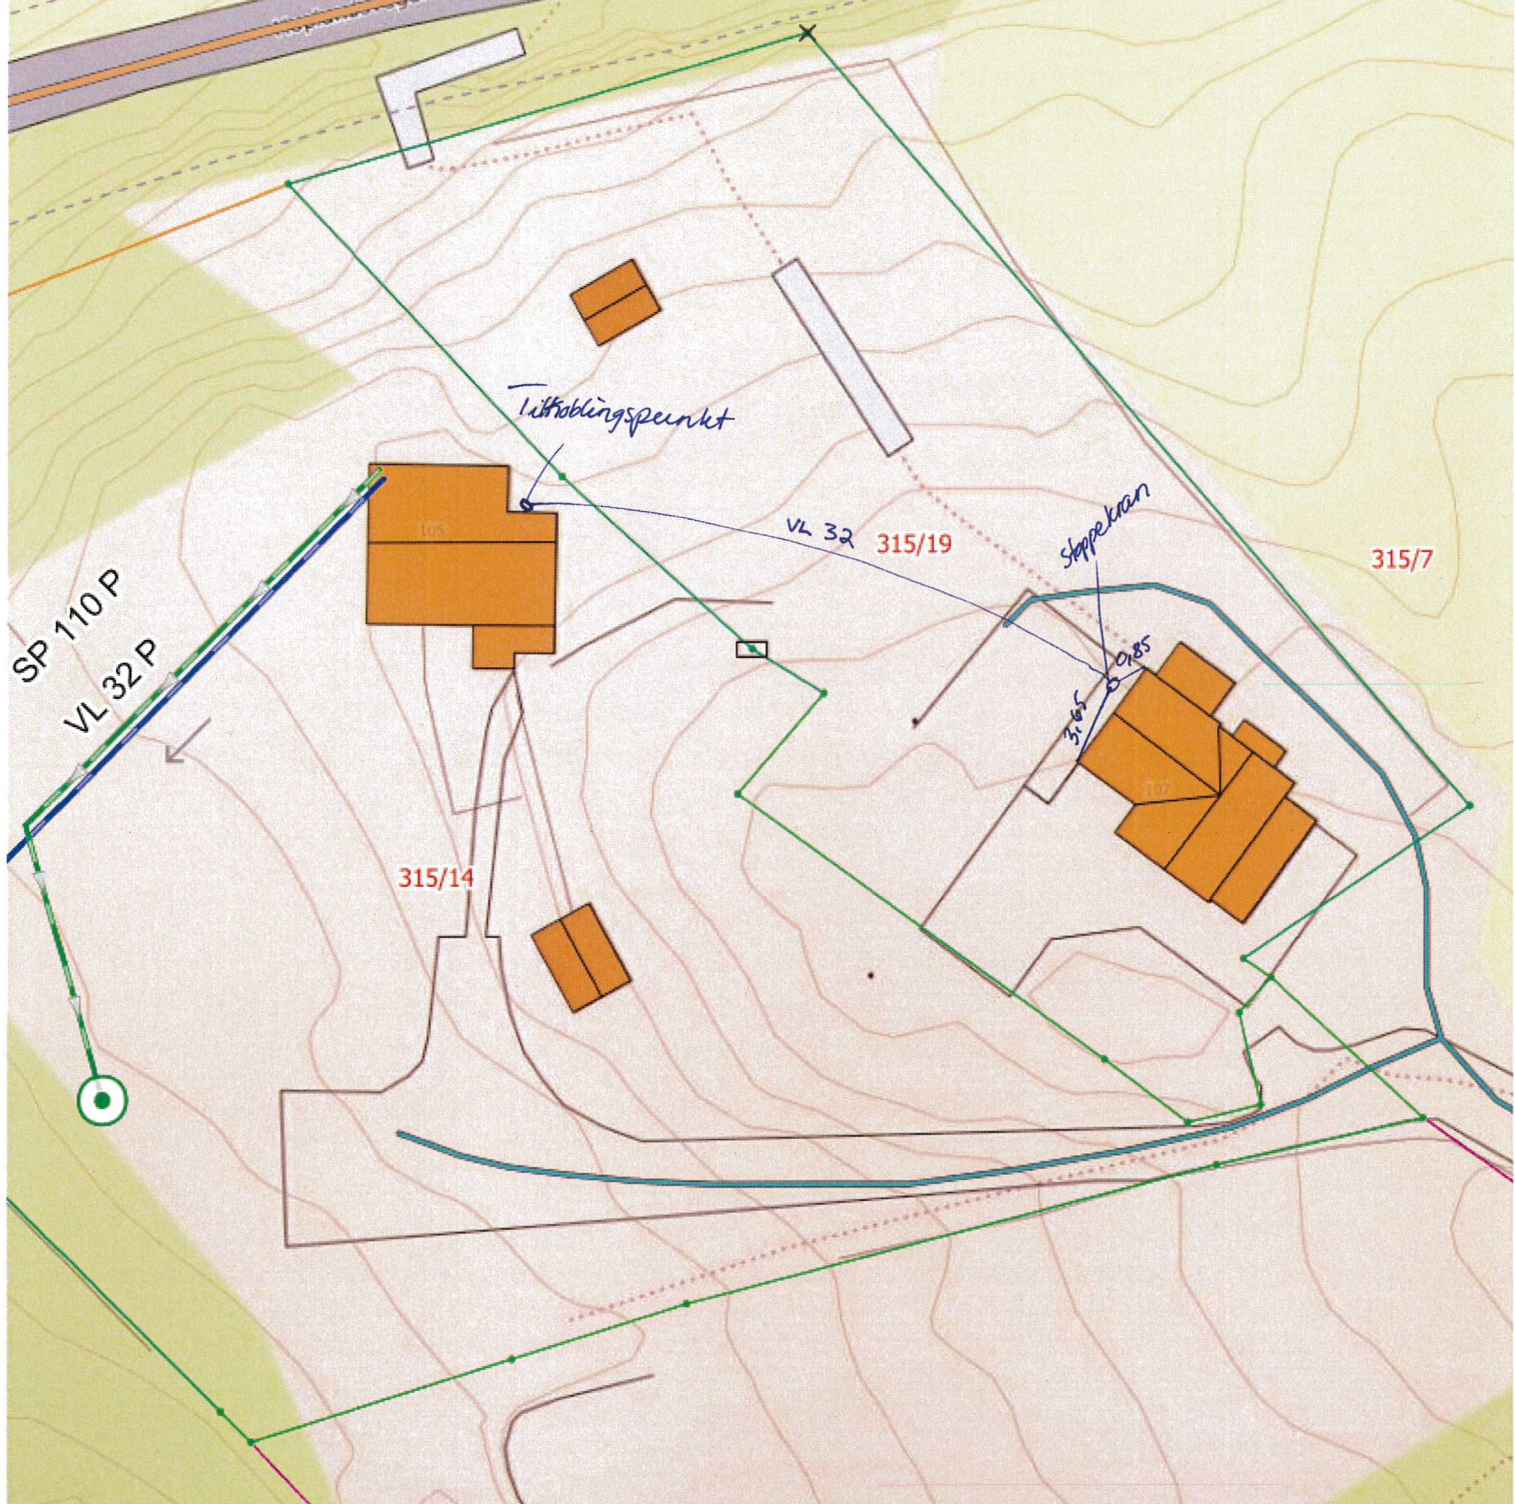

SP 110 P  
VL 32 P

Tilkoblingspunkt

VL 32 315/19

Steppekan

315/7

315/14

315/19

315/11 12

Situasjonskart -  
315/19

315/9

Dato: 09-03-2022



Målestokk: 1:350

