


EDLEGG No. 1

Austreholmen


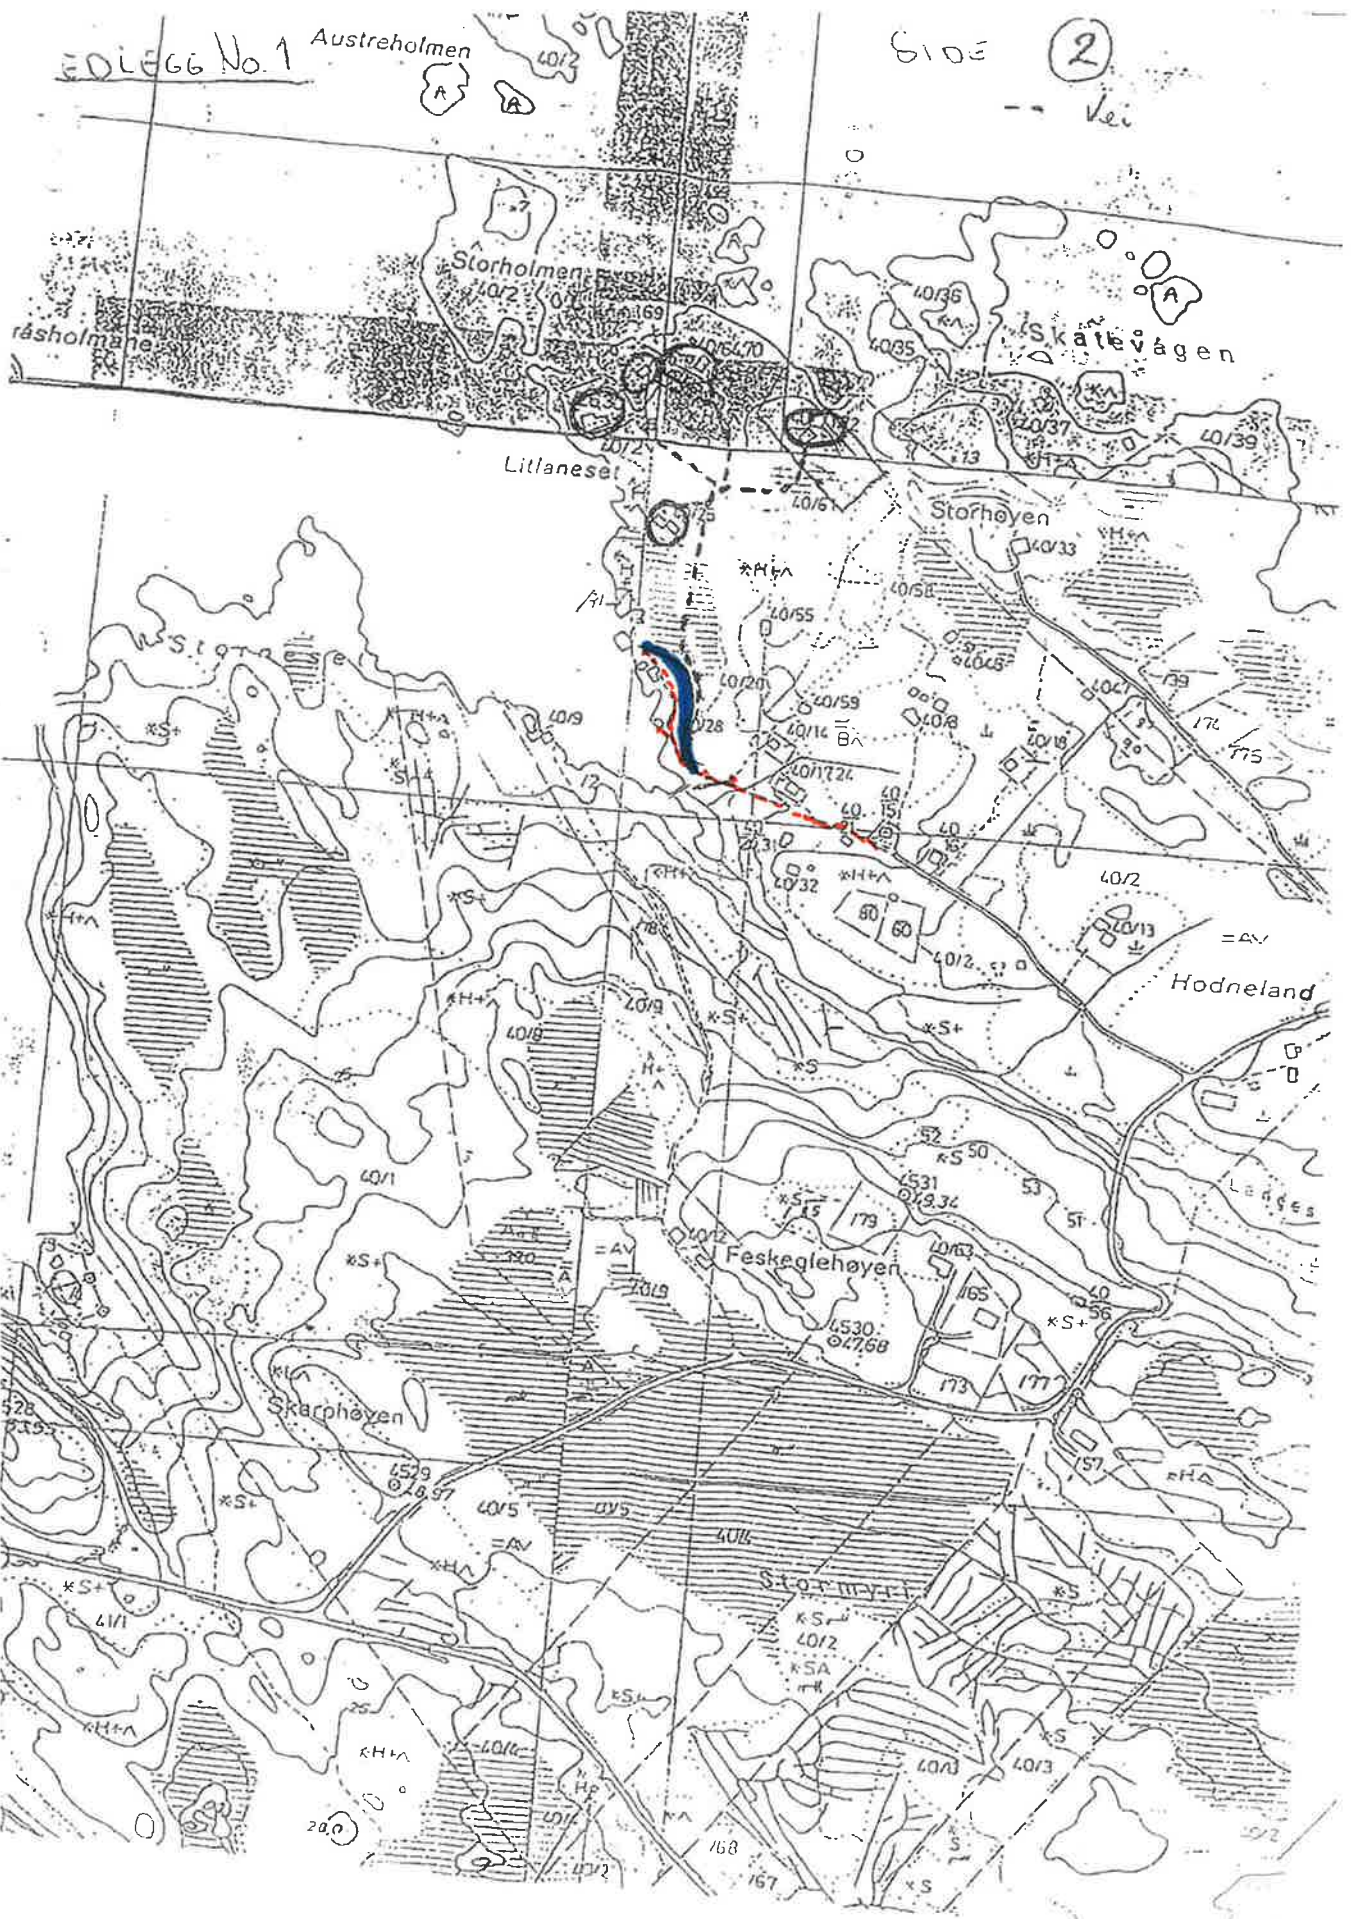

- VEI NR. 10
 - veg bygget i 1994

(2)