


N6718176, Ø289016 +

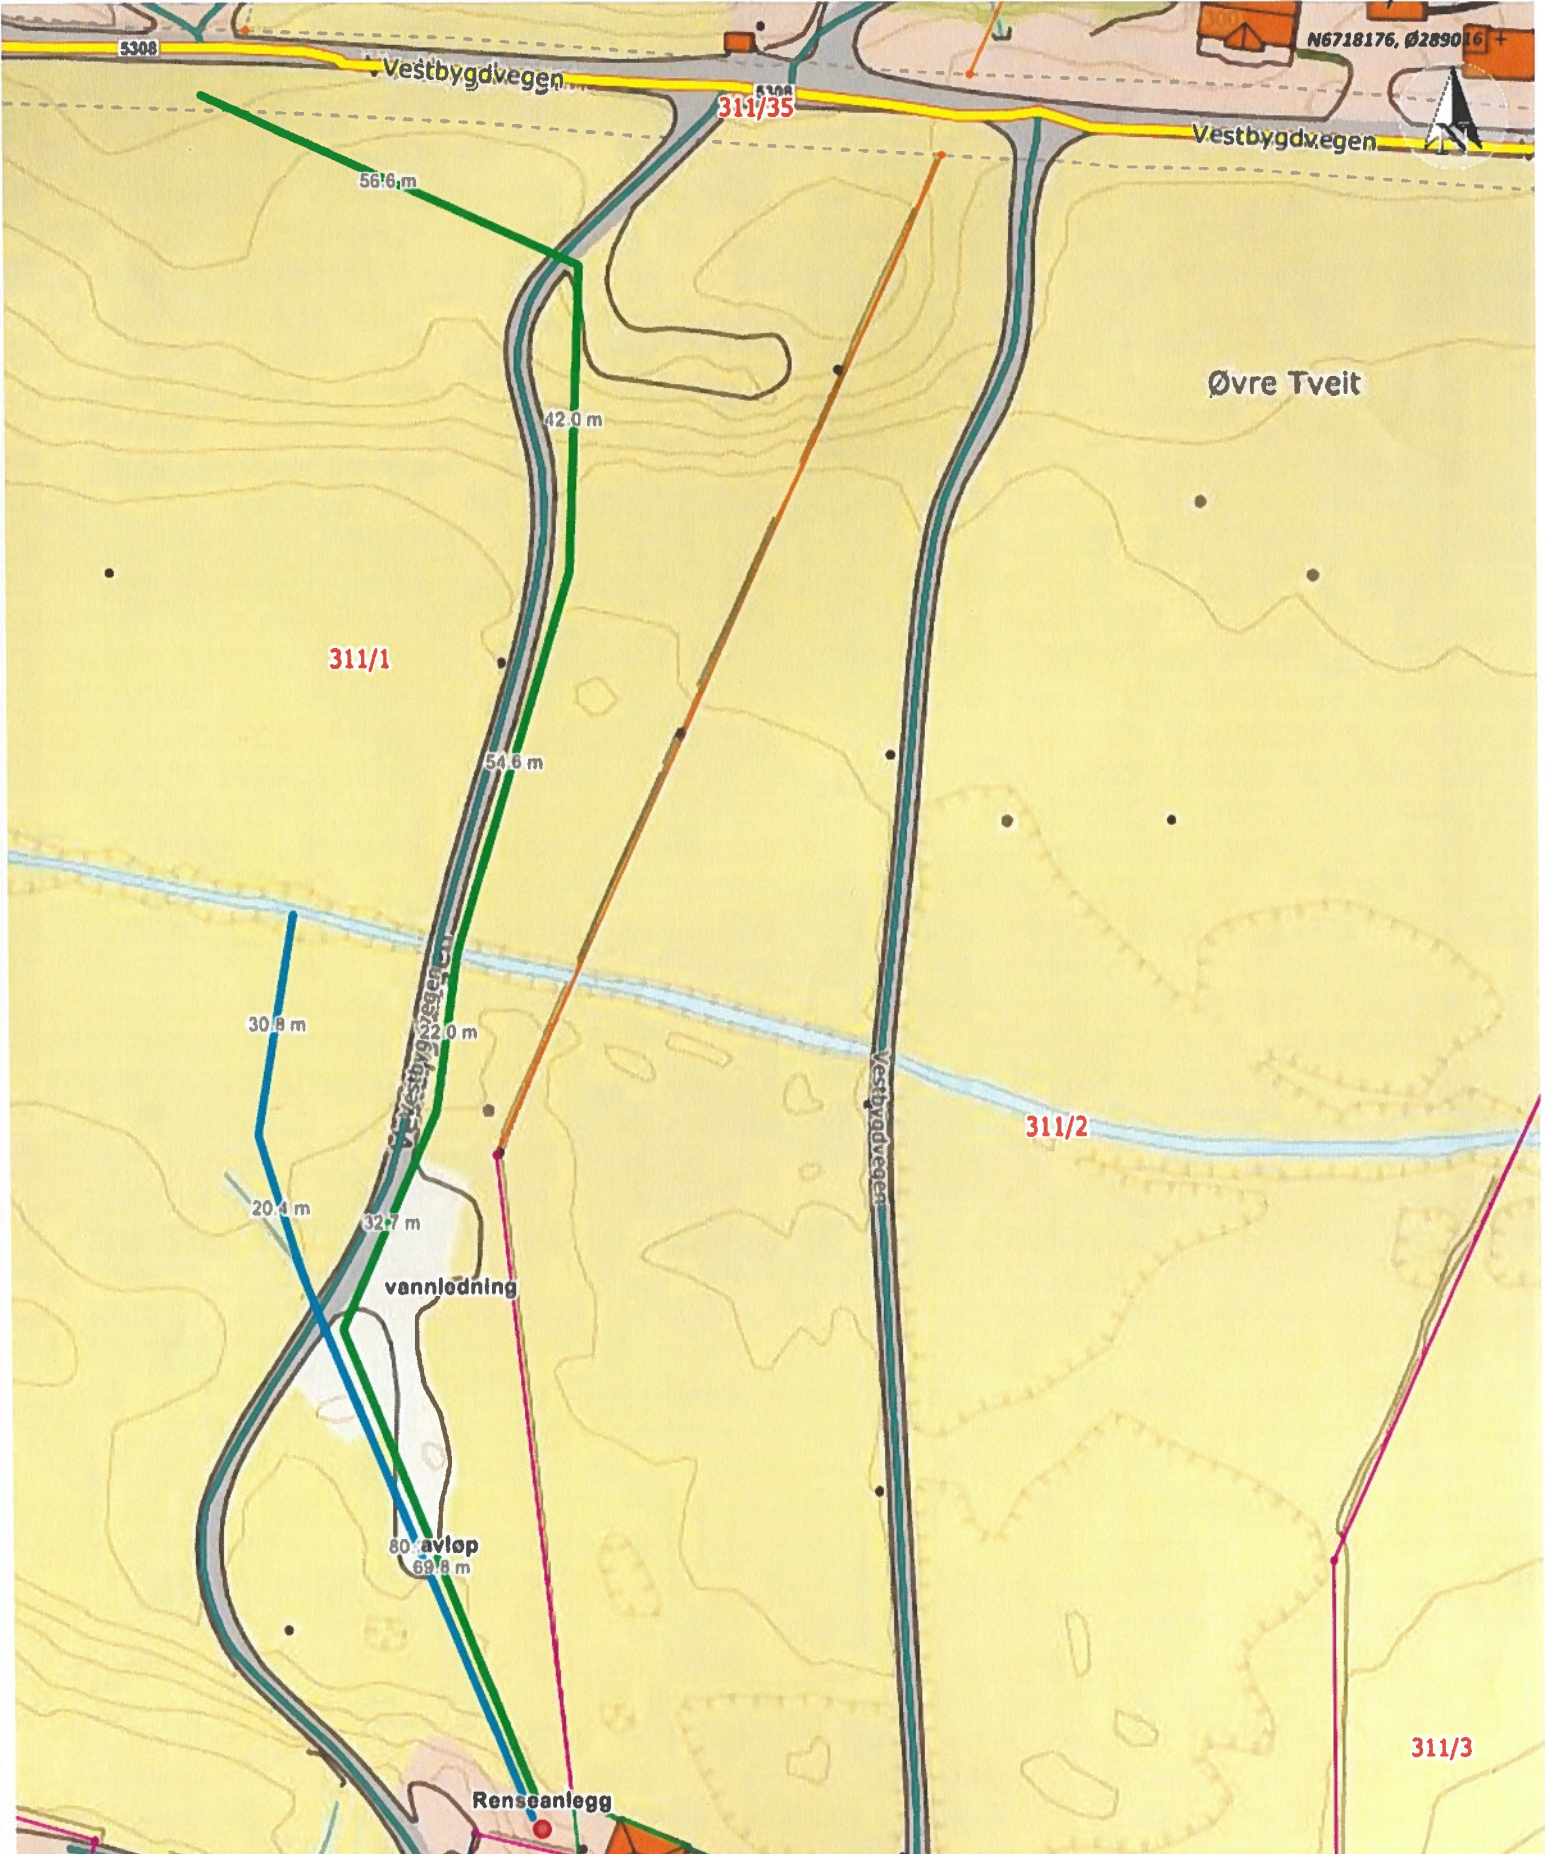

Situasjonskart -
 Gbnr. 311/10
 Vestbygdvegen 289, 5918 Frekhaug
 - Bjørnar Onstad



Dato: 08-02-2022

Målestokk: 1:1 000

