


147/3/0

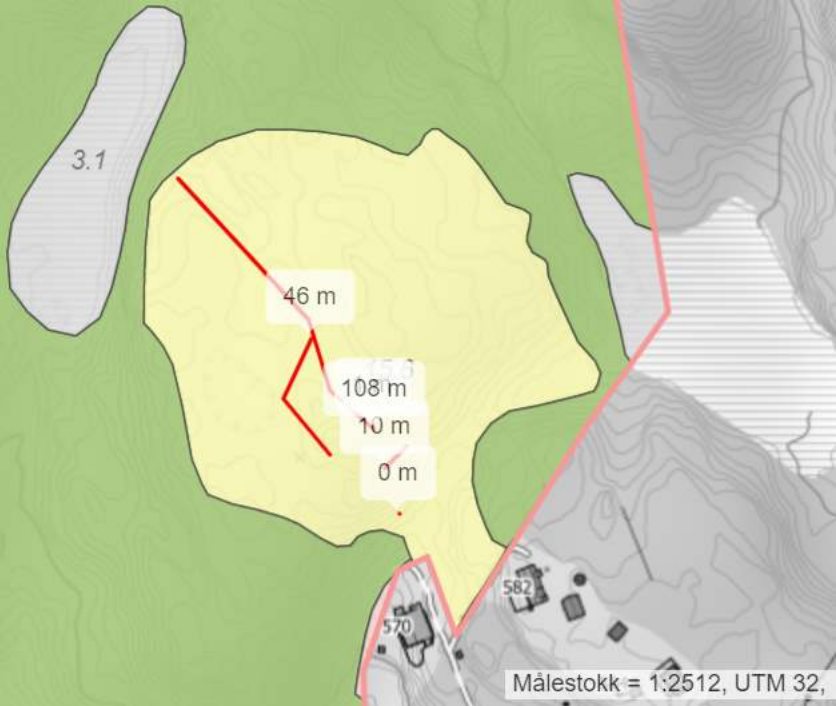

Målestokk = 1:2512, UTM 32,