

1 Vest
1 : 100



Arkitekt Jameson AS

No.	Description	Date
1	Ny Altan. 10,4 m * 2,5 m	21.03.2022
2	Ny dør, erstatter eksisterende vindu	21.03.2022



Sigve Haugsdal
Orrestein 15 C
4631-185/327

Ny Fasade Vest

Project number	0001
Date	21.03.2022
Drawn by	Jameson
Checked by	Checker

AA1101

Scale 1:100

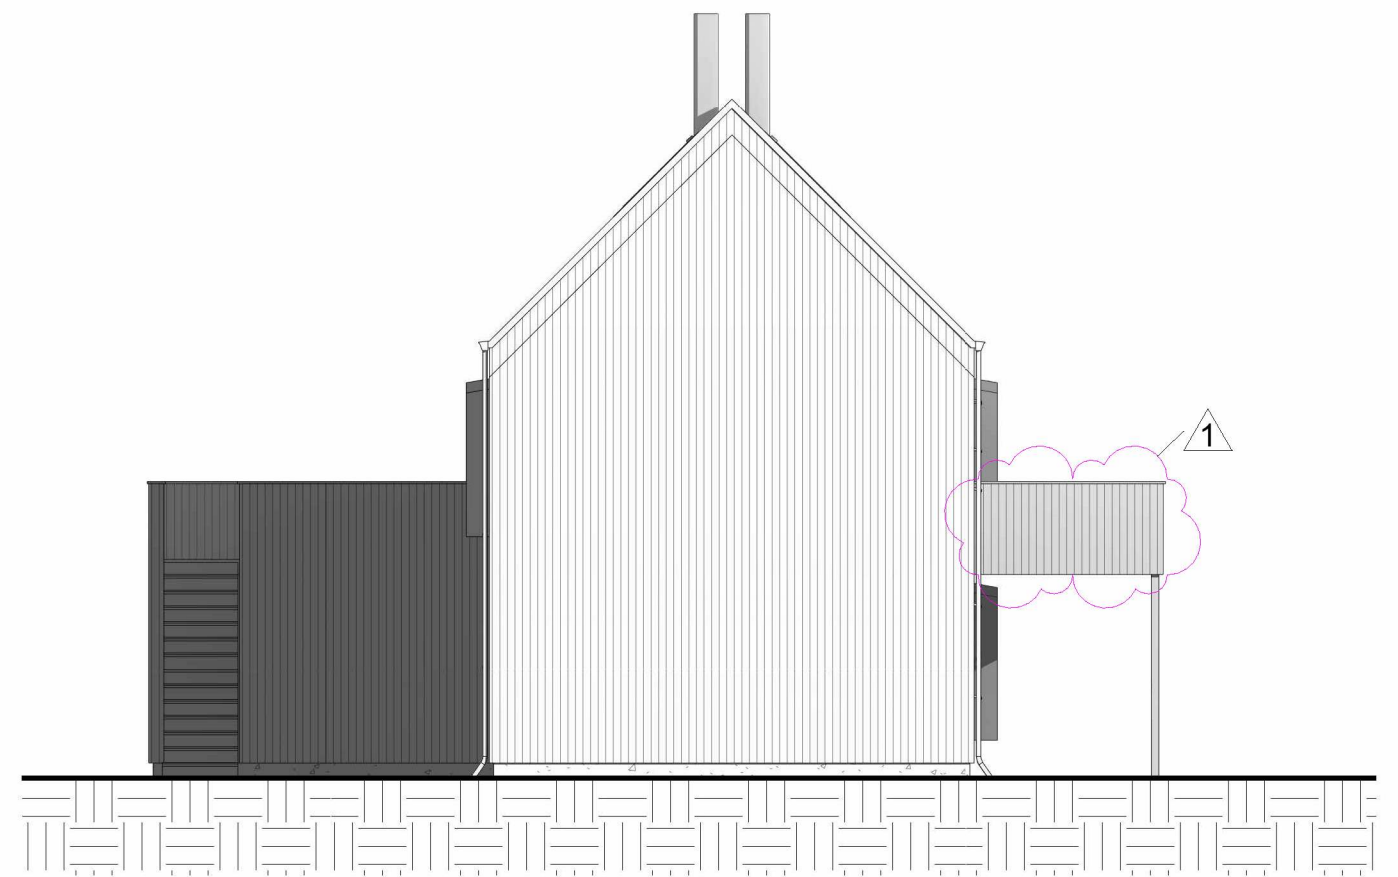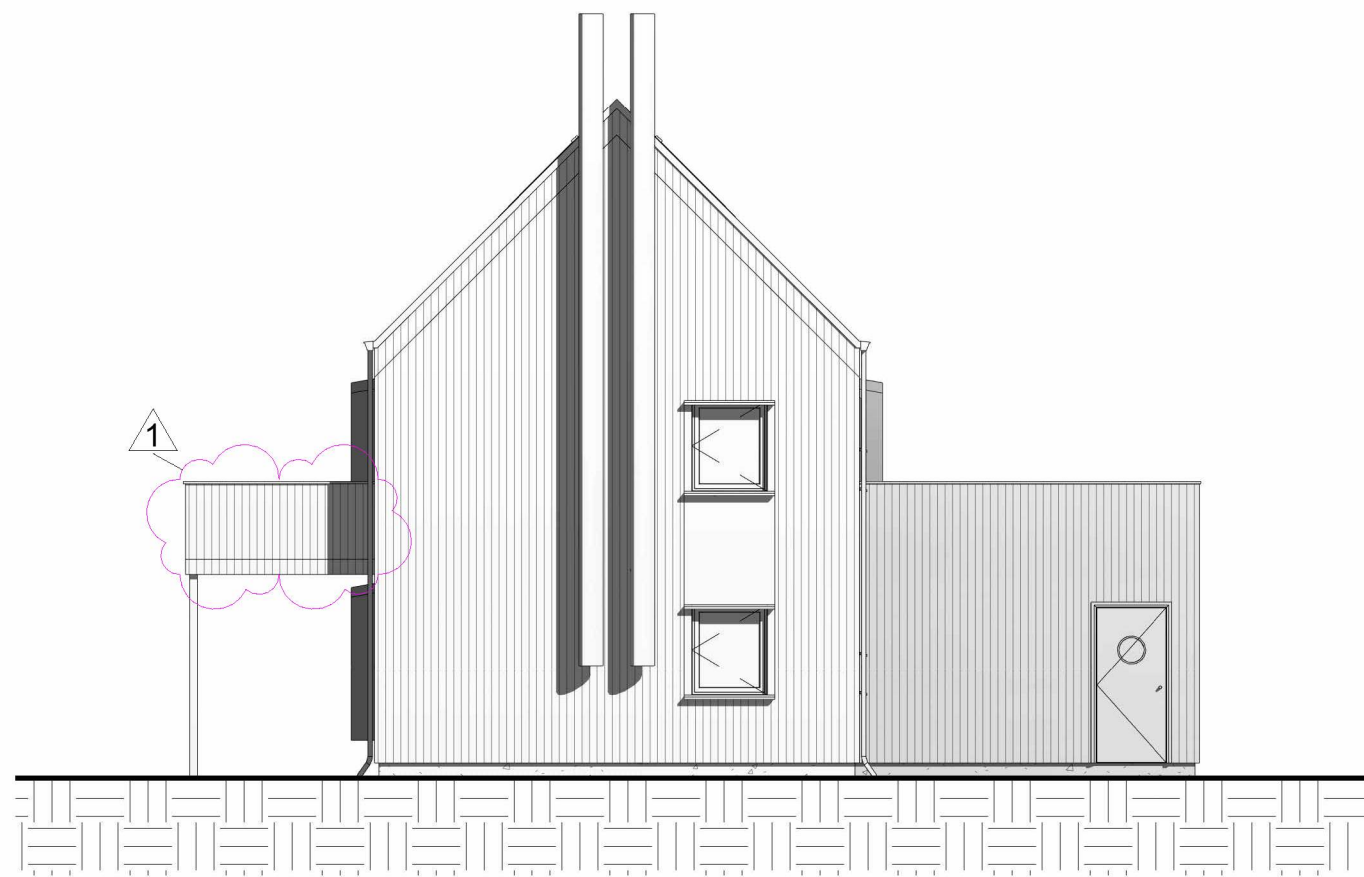

1 Sør
1 : 100

2 Nord
1 : 100



Arkitekt Jameson AS

No.	Description	Date
1	Ny Altan. 10,4 m * 2,5 m	21.03.2022


Sigve Haugsdal
Orresteinen 15 C
4631-185/327

Ny Fasade Nord & Sør

Project number	0001
Date	21.03.2022
Drawn by	Jameson
Checked by	Checker

AA1102

Scale 1:100

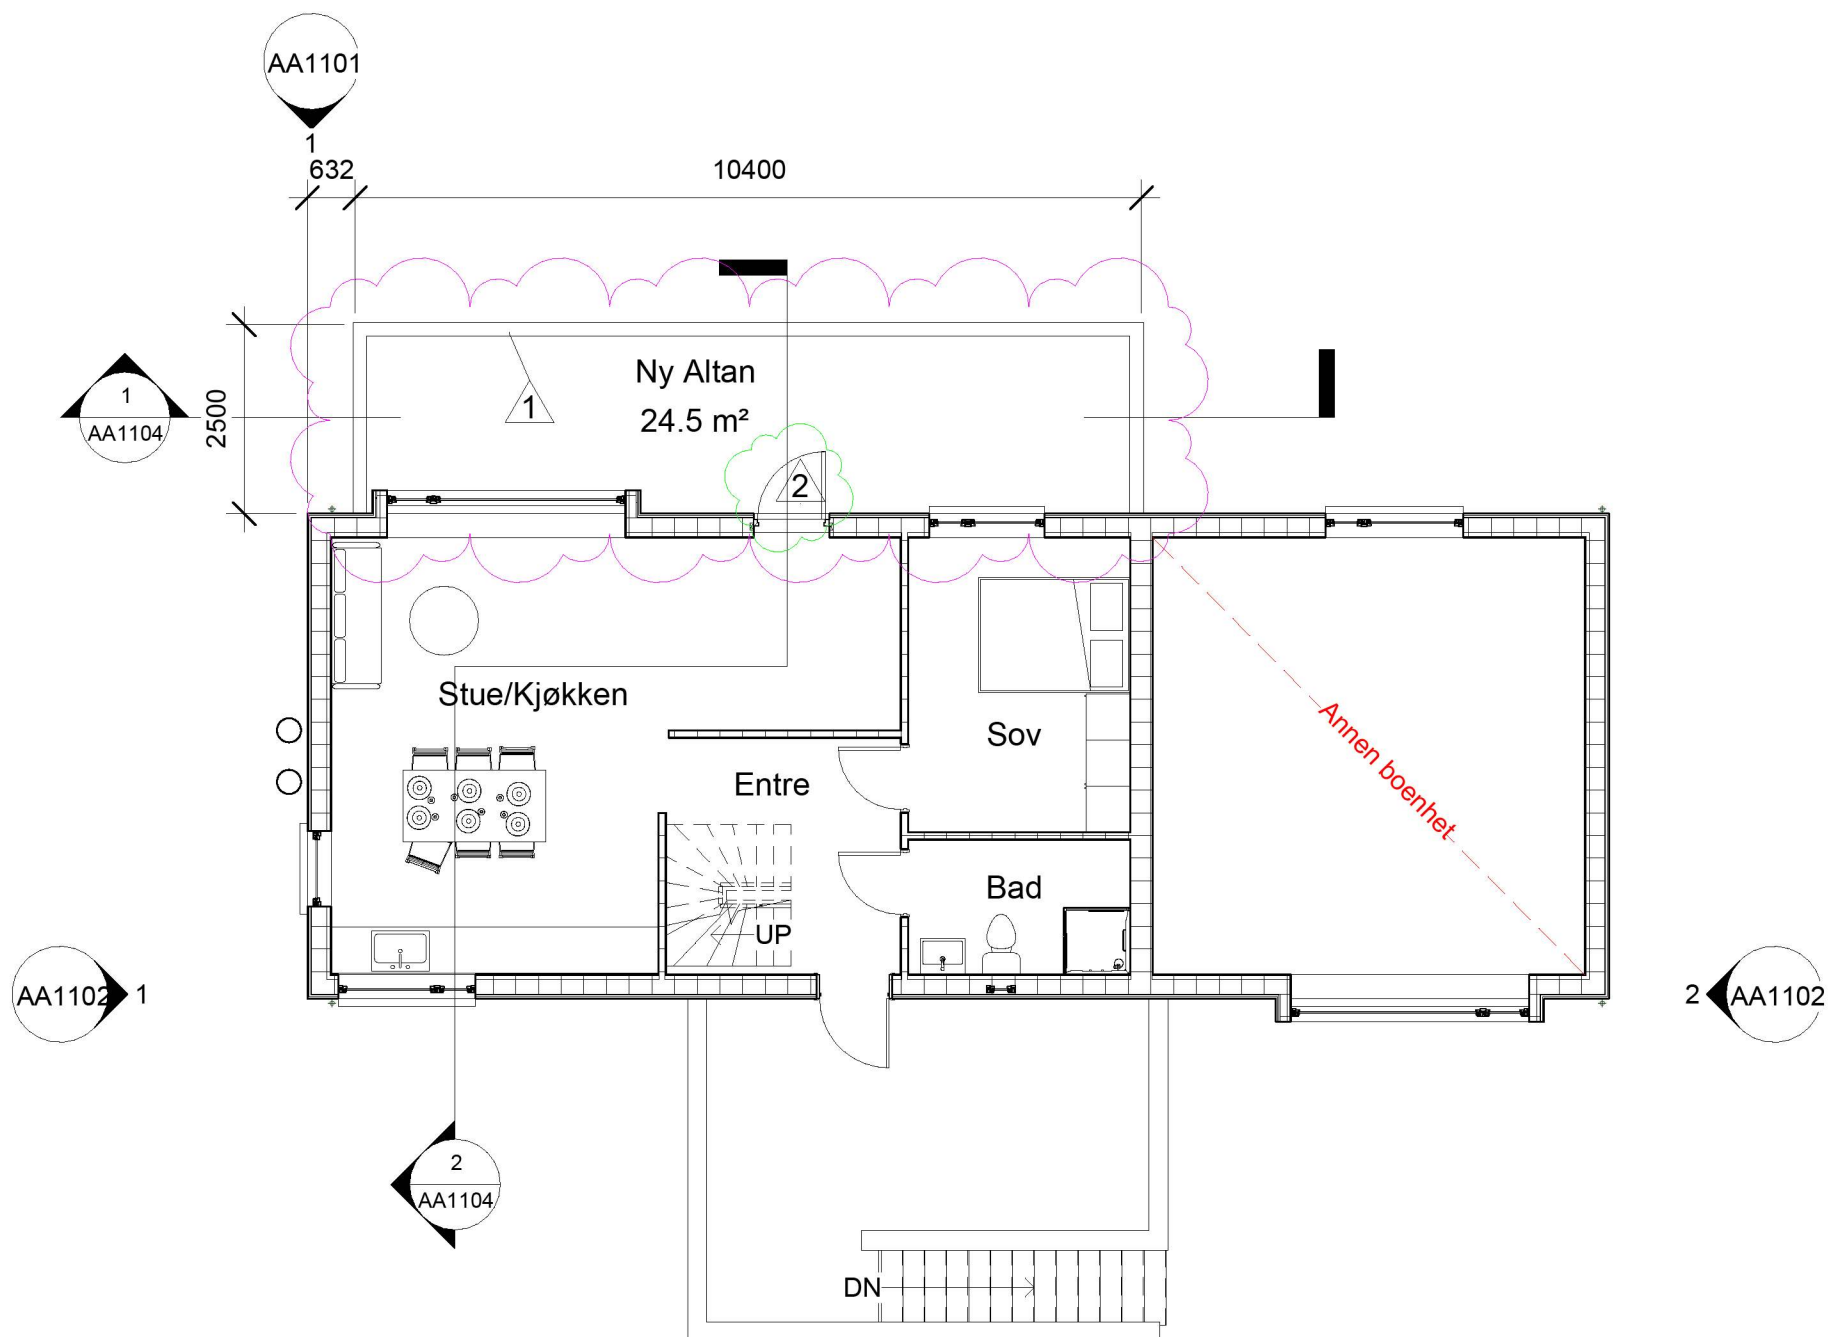

1 1.etg
1 : 100

Arealer og mål er hentet fra tegningsgrunnlag og kan avvike fra stedlige forhold



Arkitekt Jameson AS

No.	Description	Date
1	Ny Altan. 10,4 m * 2,5 m	21.03.2022
2	Ny dør, erstatter eksisterende vindu	21.03.2022


Sigve Haugsdal
Orrestein 15 C
4631-185/327

Ny Plantegning 1.etg

Project number	0001
Date	21.03.2022
Drawn by	Jameson
Checked by	Checker


AA1103

Scale 1:100

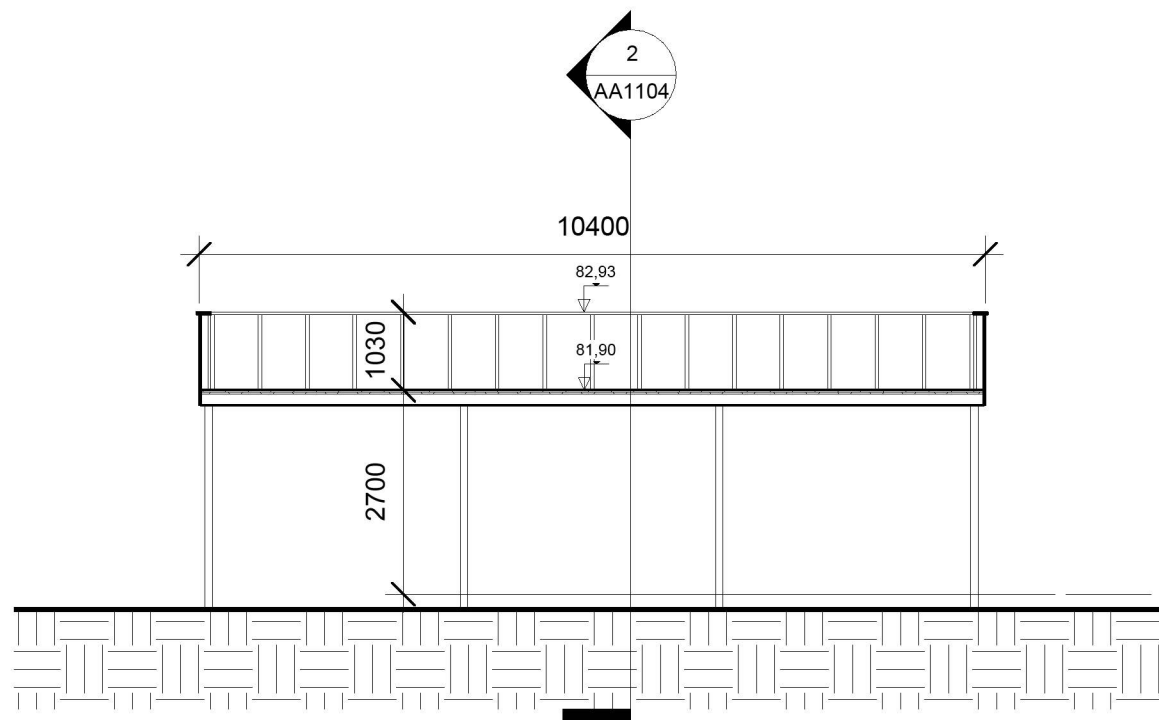

1 Snitt 1
1 : 100

0.etg
0

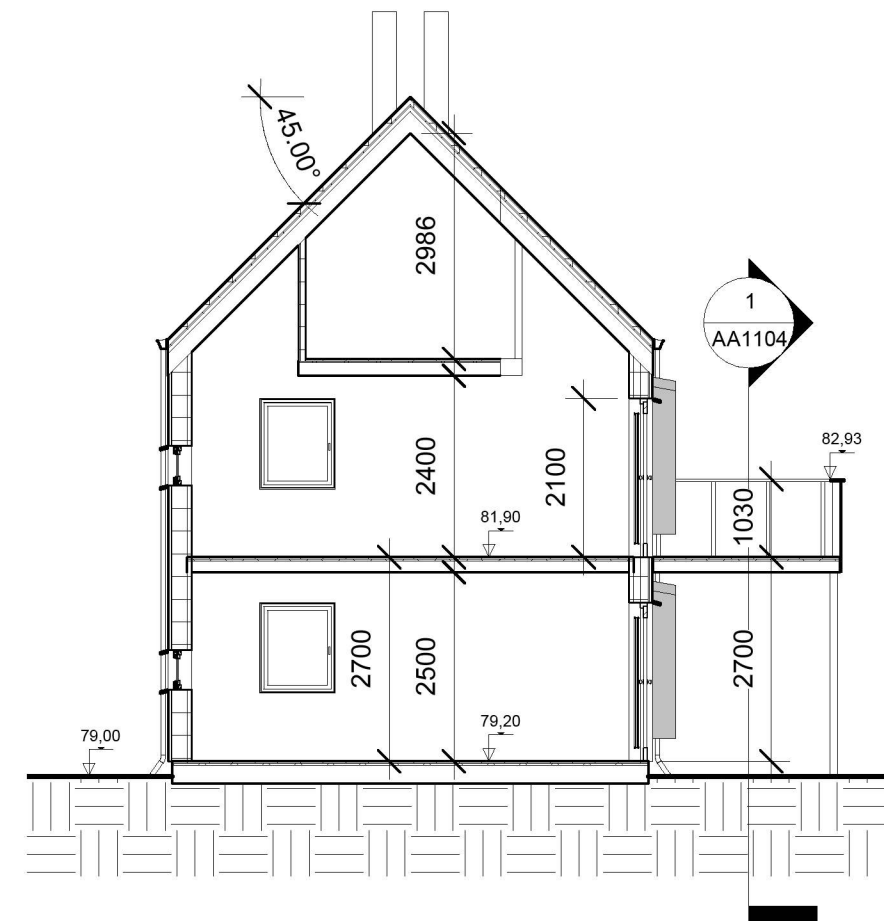

2 Snitt 2
1 : 100



Arkitekt Jameson AS

No.	Description	Date

Sigve Haugsdal
Orrestein 15 C
4631-185/327

Snitt 1 & 2

Project number	0001
Date	21.03.2022
Drawn by	Jameson
Checked by	Checker

AA1104

Scale 1:100