


KAFIFRONT KLES MED  
120 x 28 mm TRYKKIMP  
e/e 200 mm (VERTIKALT)

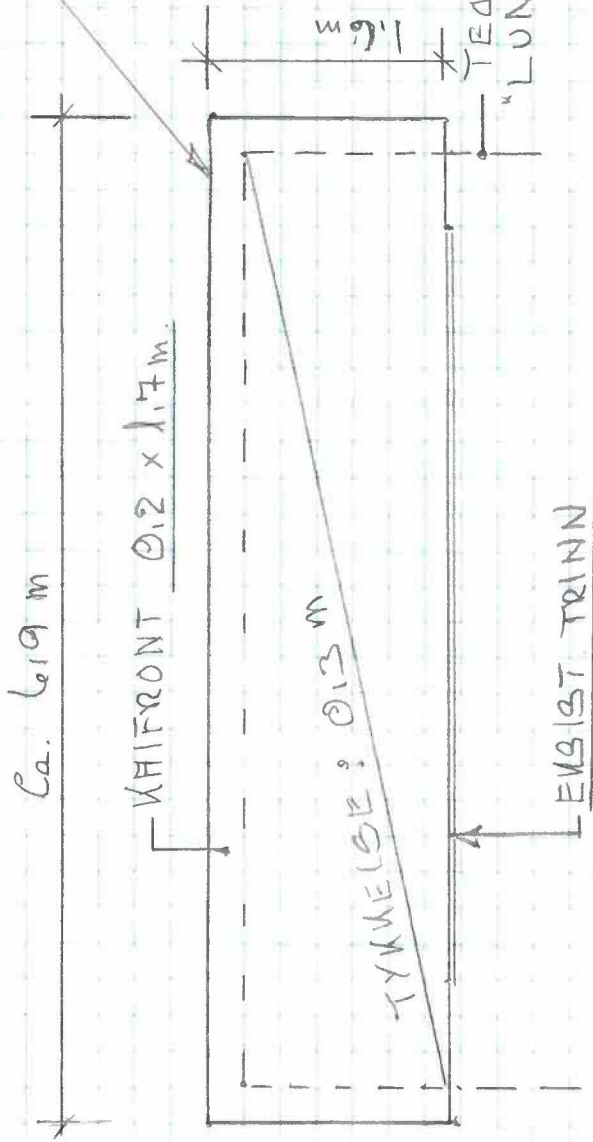

BETONG B 45  
FRIMERING KAFIST 12mm.  
RUTER 250 mm  
FORÅNRES I KAFIFRONT/LONNER

KAFIFRONT NÅST TOSMA

6/Bar 43/101

BETONG ARBEID

Tosma. 03.09.21, rev. 14.02.22.

Terje Binkland