


HELLA

2019 = 2011

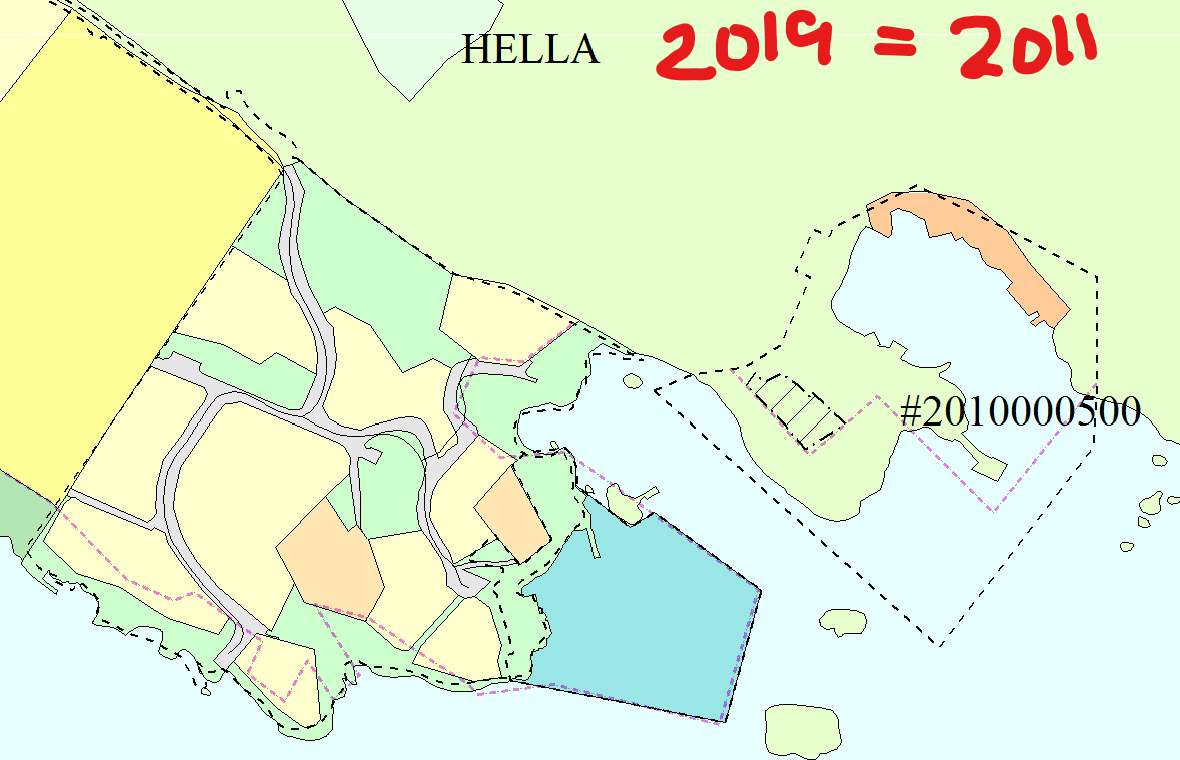

#2010000500

#2000000300