


Situasjonskart -
Pål Børslid
172/66

Nhdigi.no

Målestokk: 1:350

Dato: 09-05-2022

9m

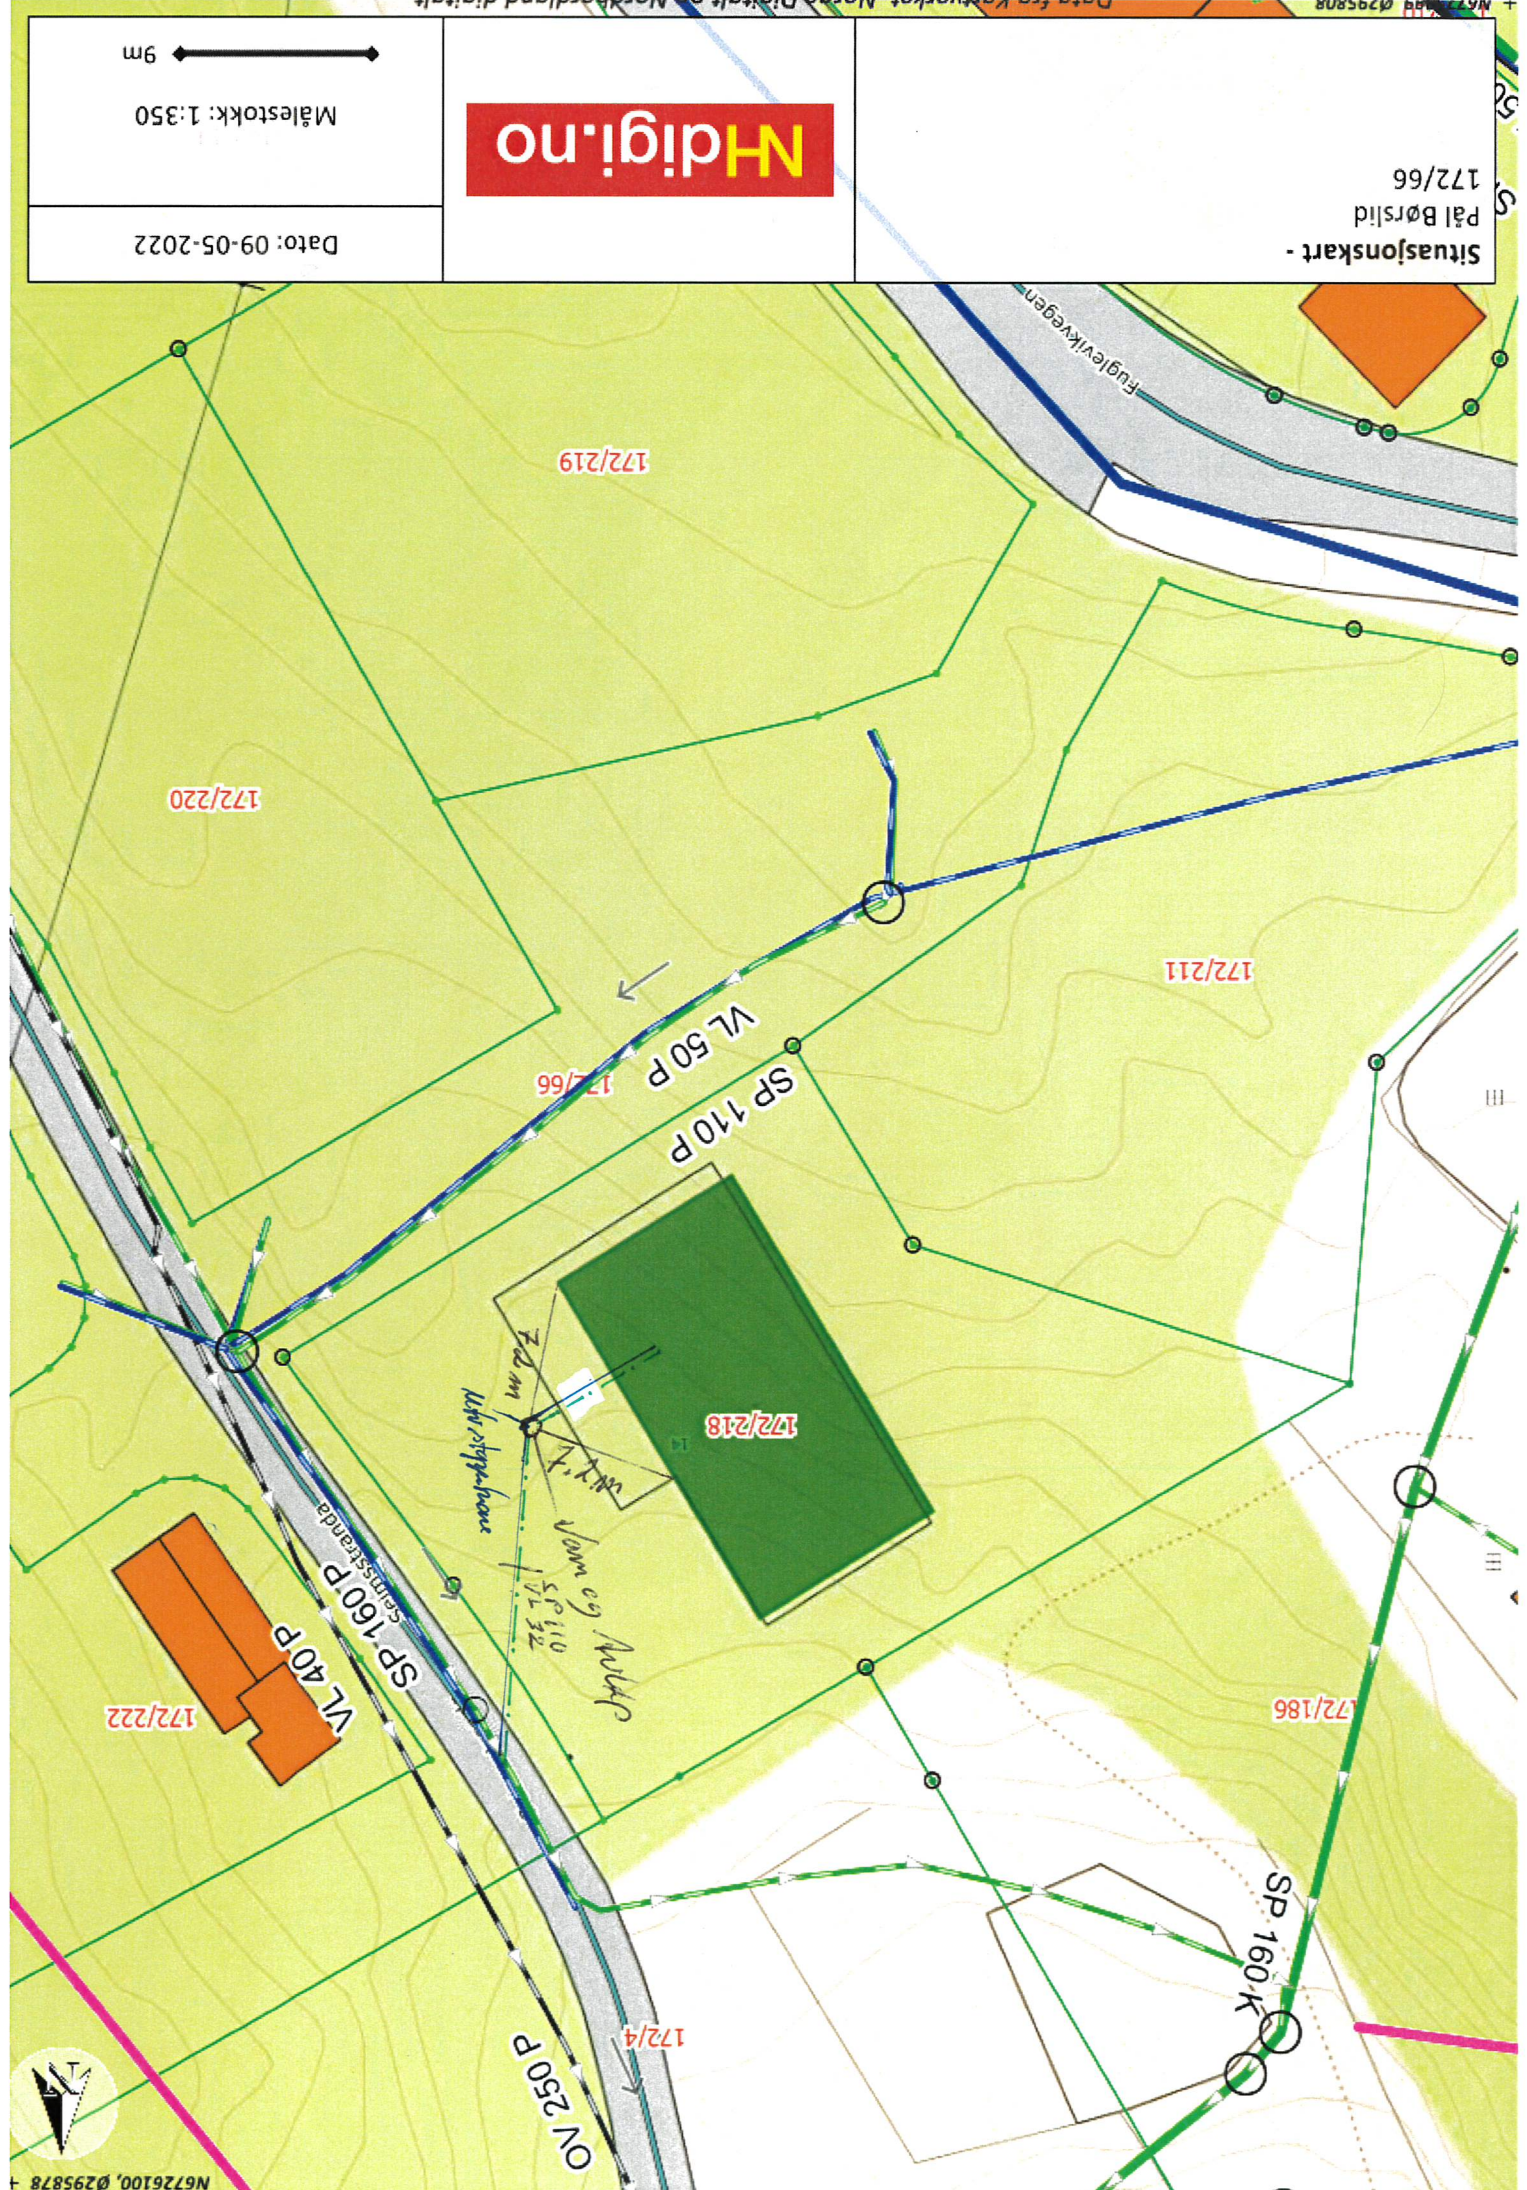

N6726100, Ø295878