

INNMALINGSTJENESTER AS



Organisasjonsnr. 979 927 703
Bankgiro: 3624 07 79751

Vår ref:
Knut Henanger
Frekhaug Bolig as

Deres ref:

Dato: 13.05.22.

**Innmålingsdata for Gnr.202 Bnr.177, Helleåsen, Alver
Kommune.**

Målt topp grunnmur

HUSET

<u>PUNKT</u>	<u>TEMA</u>	<u>X</u>	<u>Y</u>	<u>H</u>
05 1	5000	6722785.537	300551.476	59.286
05 2	5000	6722781.113	300543.199	62.057
05 3	5000	6722771.302	300548.589	62.060
05 4	5000	6722775.239	300555.757	59.303
05 5	5000	6722781.796	300552.155	59.301
05 6	5000	6722782.394	300553.218	59.308

TOMTEN

05 8	4011	6722757.020	300545.220	
05 9	4011	6722763.600	300528.220	
05 10	4011	6722780.560	300534.670	
05 11	4011	6722806.880	300562.560	
05 12	4011	6722778.210	300583.740	
05 13	4011	6722758.320	300547.150	

Med vennlig hilsen
Innmålingstjenester as

Kjersti K. Madsen



Kontoradresse:
Telefon
Kjersti K. Madsen
Johnny Sandvik

Helgeplassen 144
55 59 02 77 (76)
Mob.tlf. 90 78 72 08
Mob.tlf. 40 40 23 23


5148 Fyllingsdalen
E.Post: innmal@innmal.no

X 6722850

Y 300550

Skisse for Gnr.202 Bnr.177 Helleåsen, Alver Kommune.

X 6722800

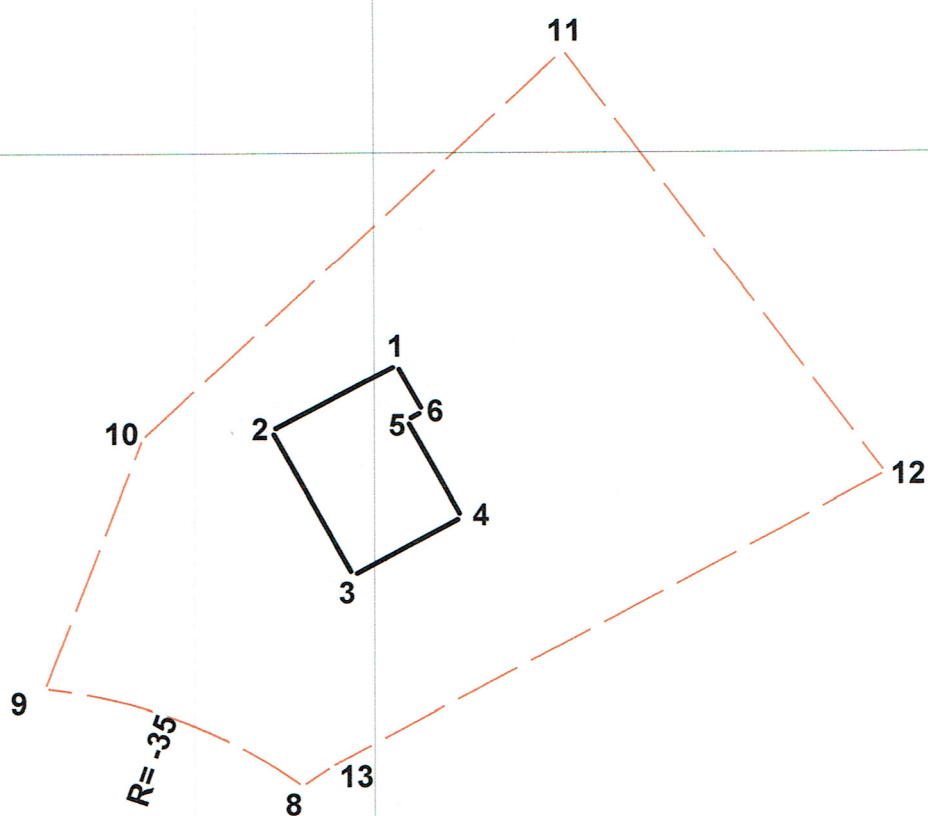

X 6722750



Skisse for Gnr.202 Bnr.177
Helleåsen, Alver Kommune.
Frekhaug Bolig as
Dato: 13/05/22

Målestokk 1:500

Innmålingstjenester as

Gerard K. Madsen