


5

Search for content in selected sources

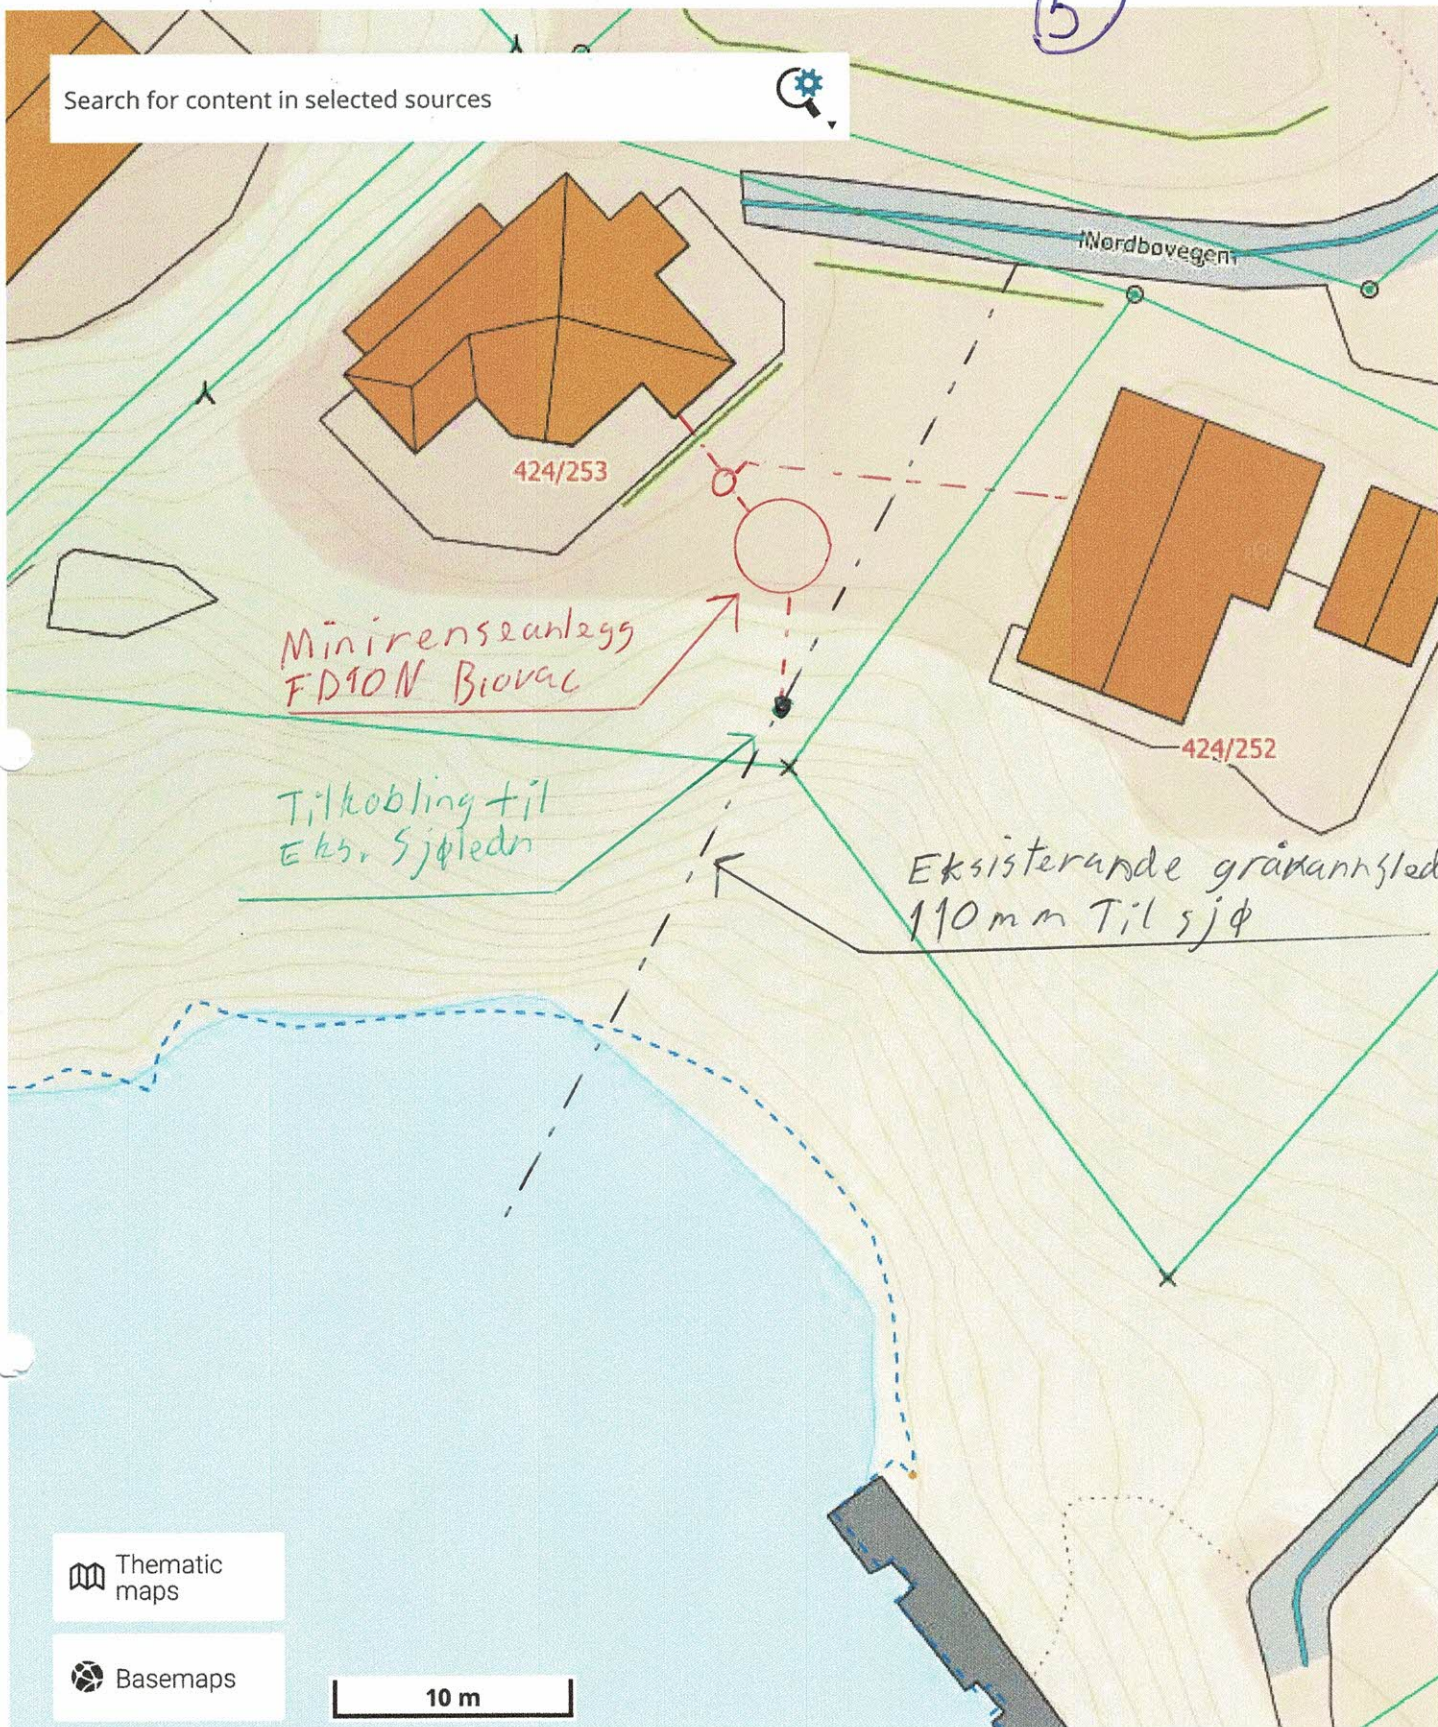

- Thematic maps
- Basemaps

10 m

EPSG:32632 N: 6737022 E: 277406

Scale 1 : 312