


3

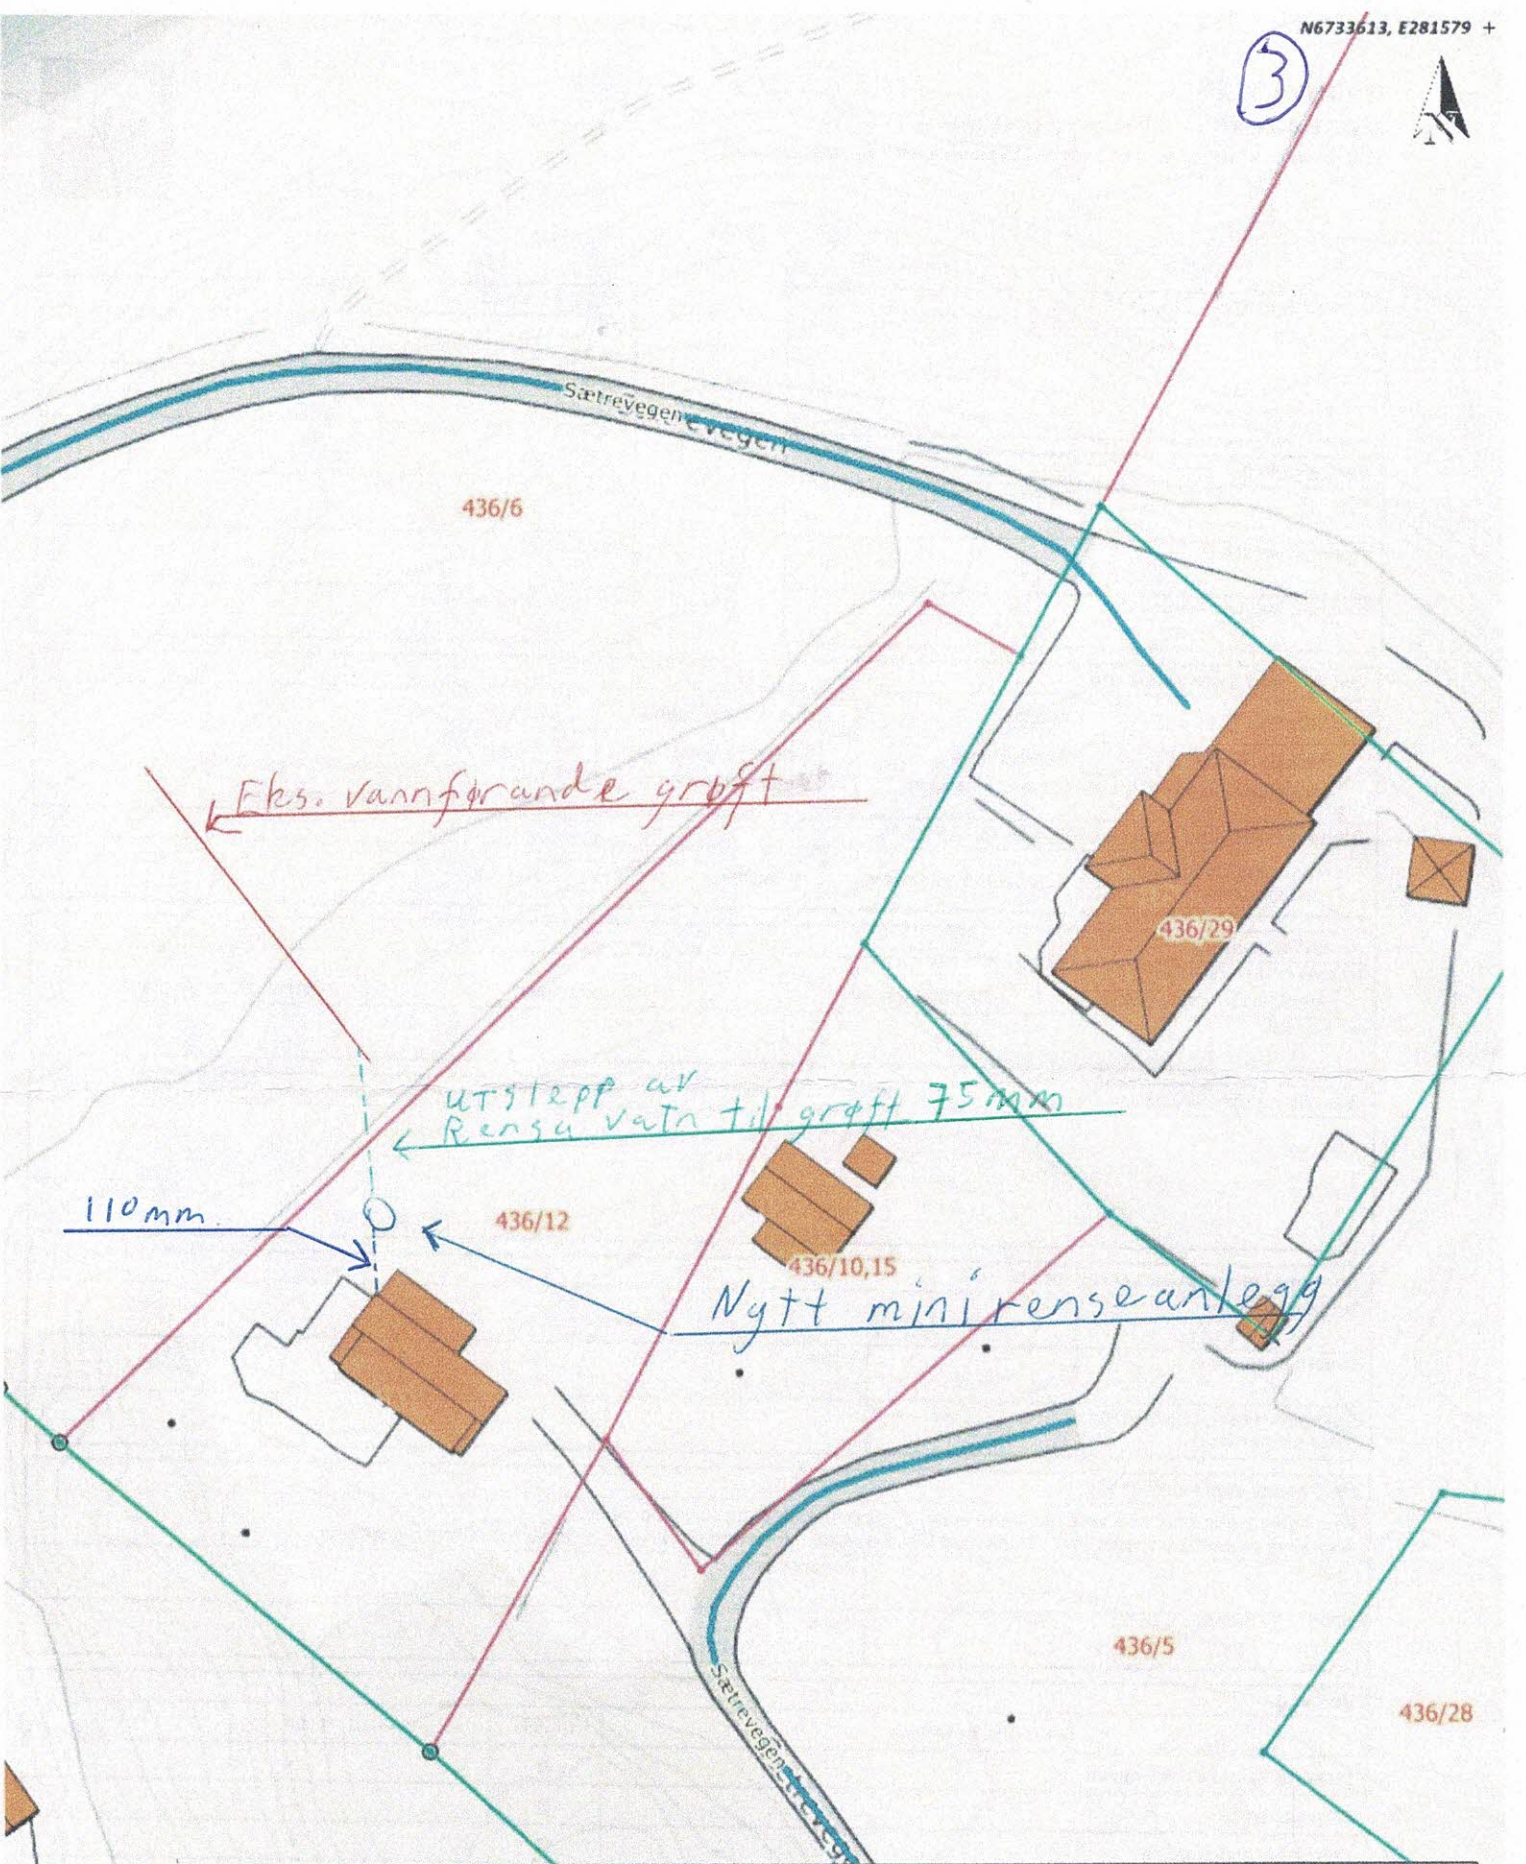

Situasjonskart -

Dato: 11-05-2022



Målestokk: 1:500

