




Ny hytte

Ny terrasse

Enr 418 Bnr 19


Ny hytte m/terasse

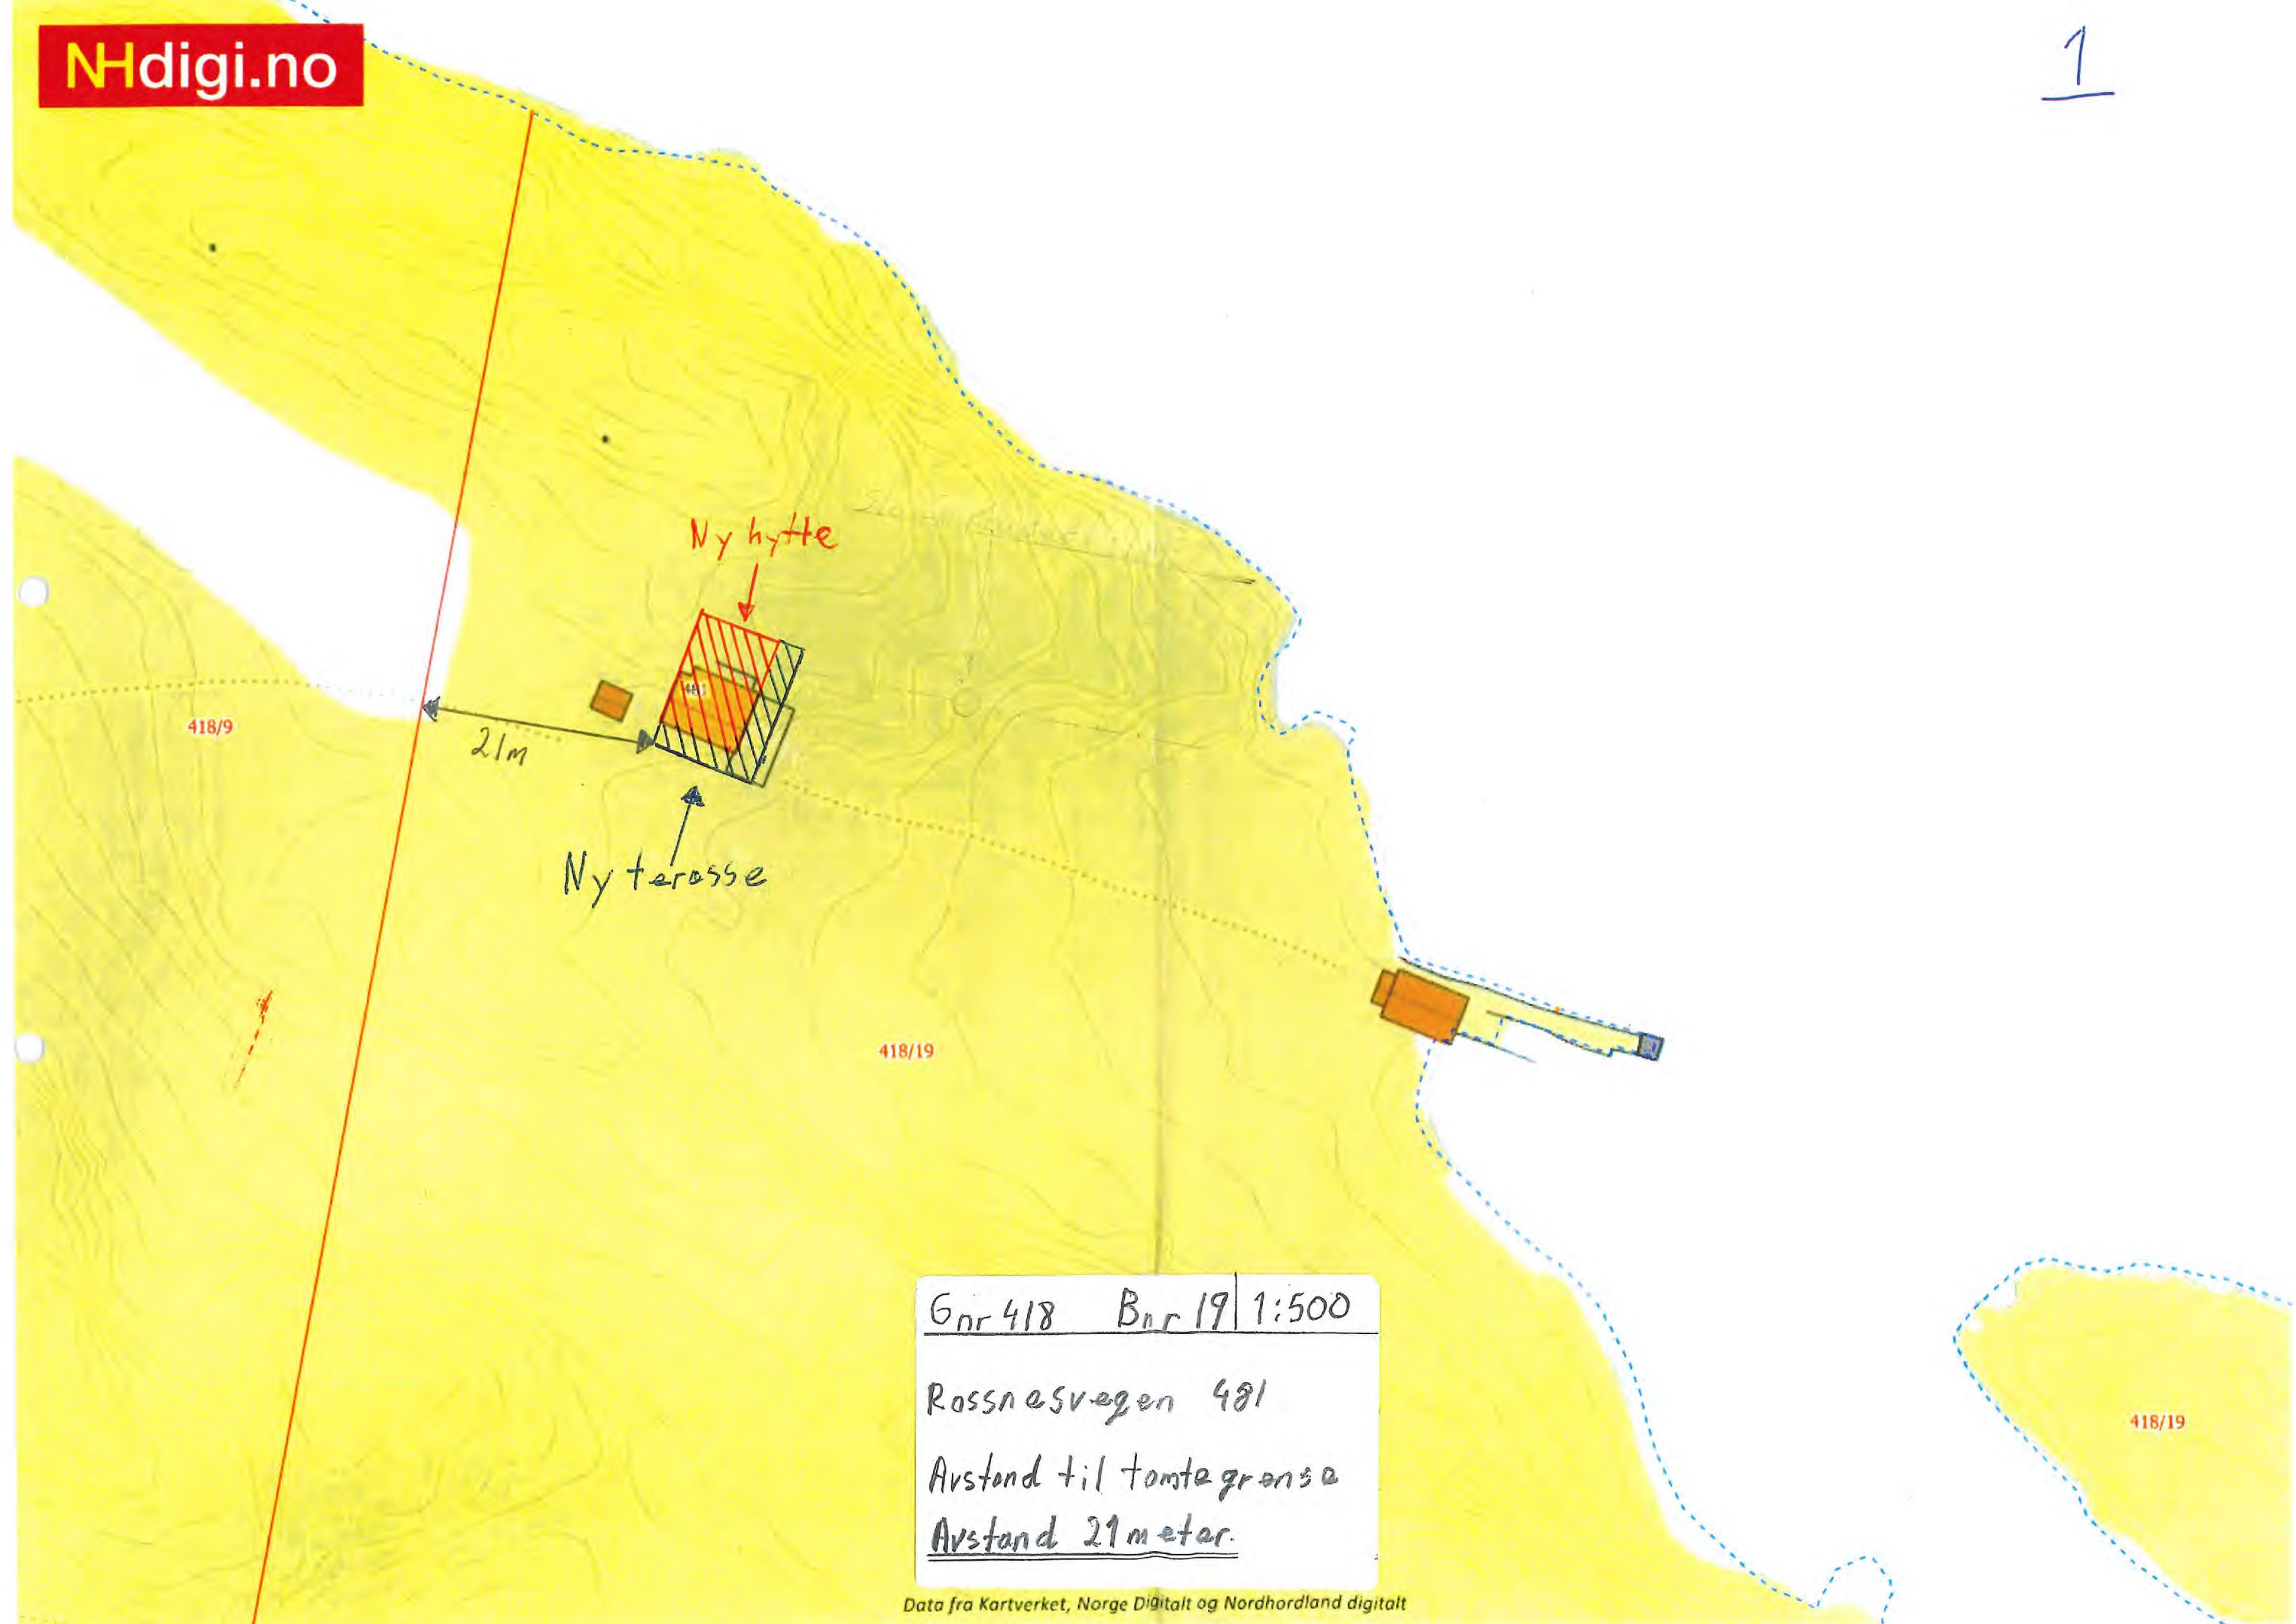

Gnr 418 Bnr 19 | 1:500
Rossnesvegen 481
Avstand til tomtegrense
Avstand 21 meter.