


↑ 3 m til muret


4,16 m

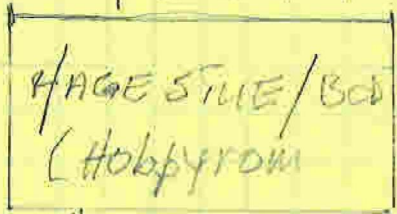

BRA
 INNV. areal 21,4 m²
 UTV. BRA 23,7 m²

5,12 m
 3 m ↓


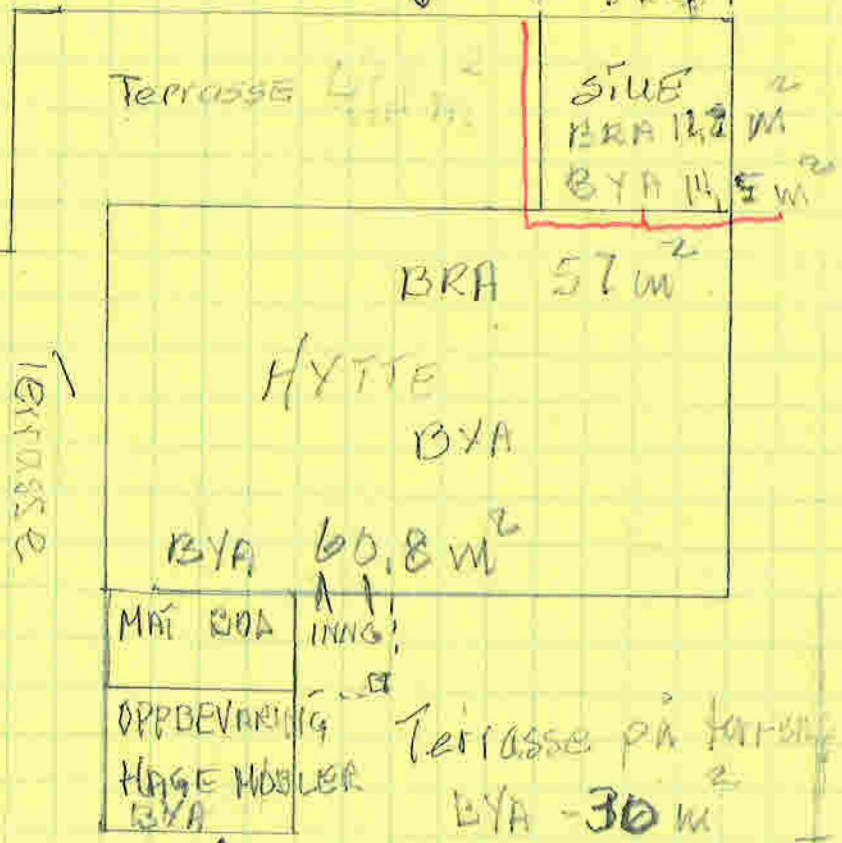

Terrasse

BRA 57 m²

HYTTE
BYA


BYA 60,8 m²

MÅL BOD

OPPBEVARTING
HAGE HØSLER
BYA

BYA - 30 m²

↑ 1 m
↓

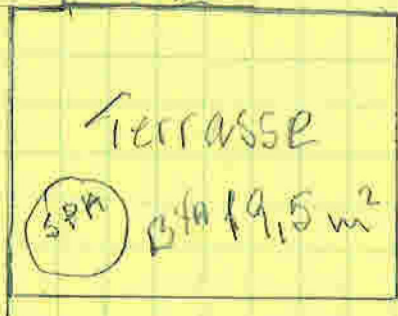

Terrasse

SPA

BYA 19,5 m²

på terrasse

Terrering



SNEKKE BOD

VED BOD

BYA 37 m²

Belag 10

