


KART  
 over  
 Indmarten tilhørende Gaarden  
**VIKEBO**

Gaards-nr. 102 i Herlvs Herred,  
 Søndre Bergenhus Amt.

Optaget Aar 1903  
 af  
 V. Winterthun.

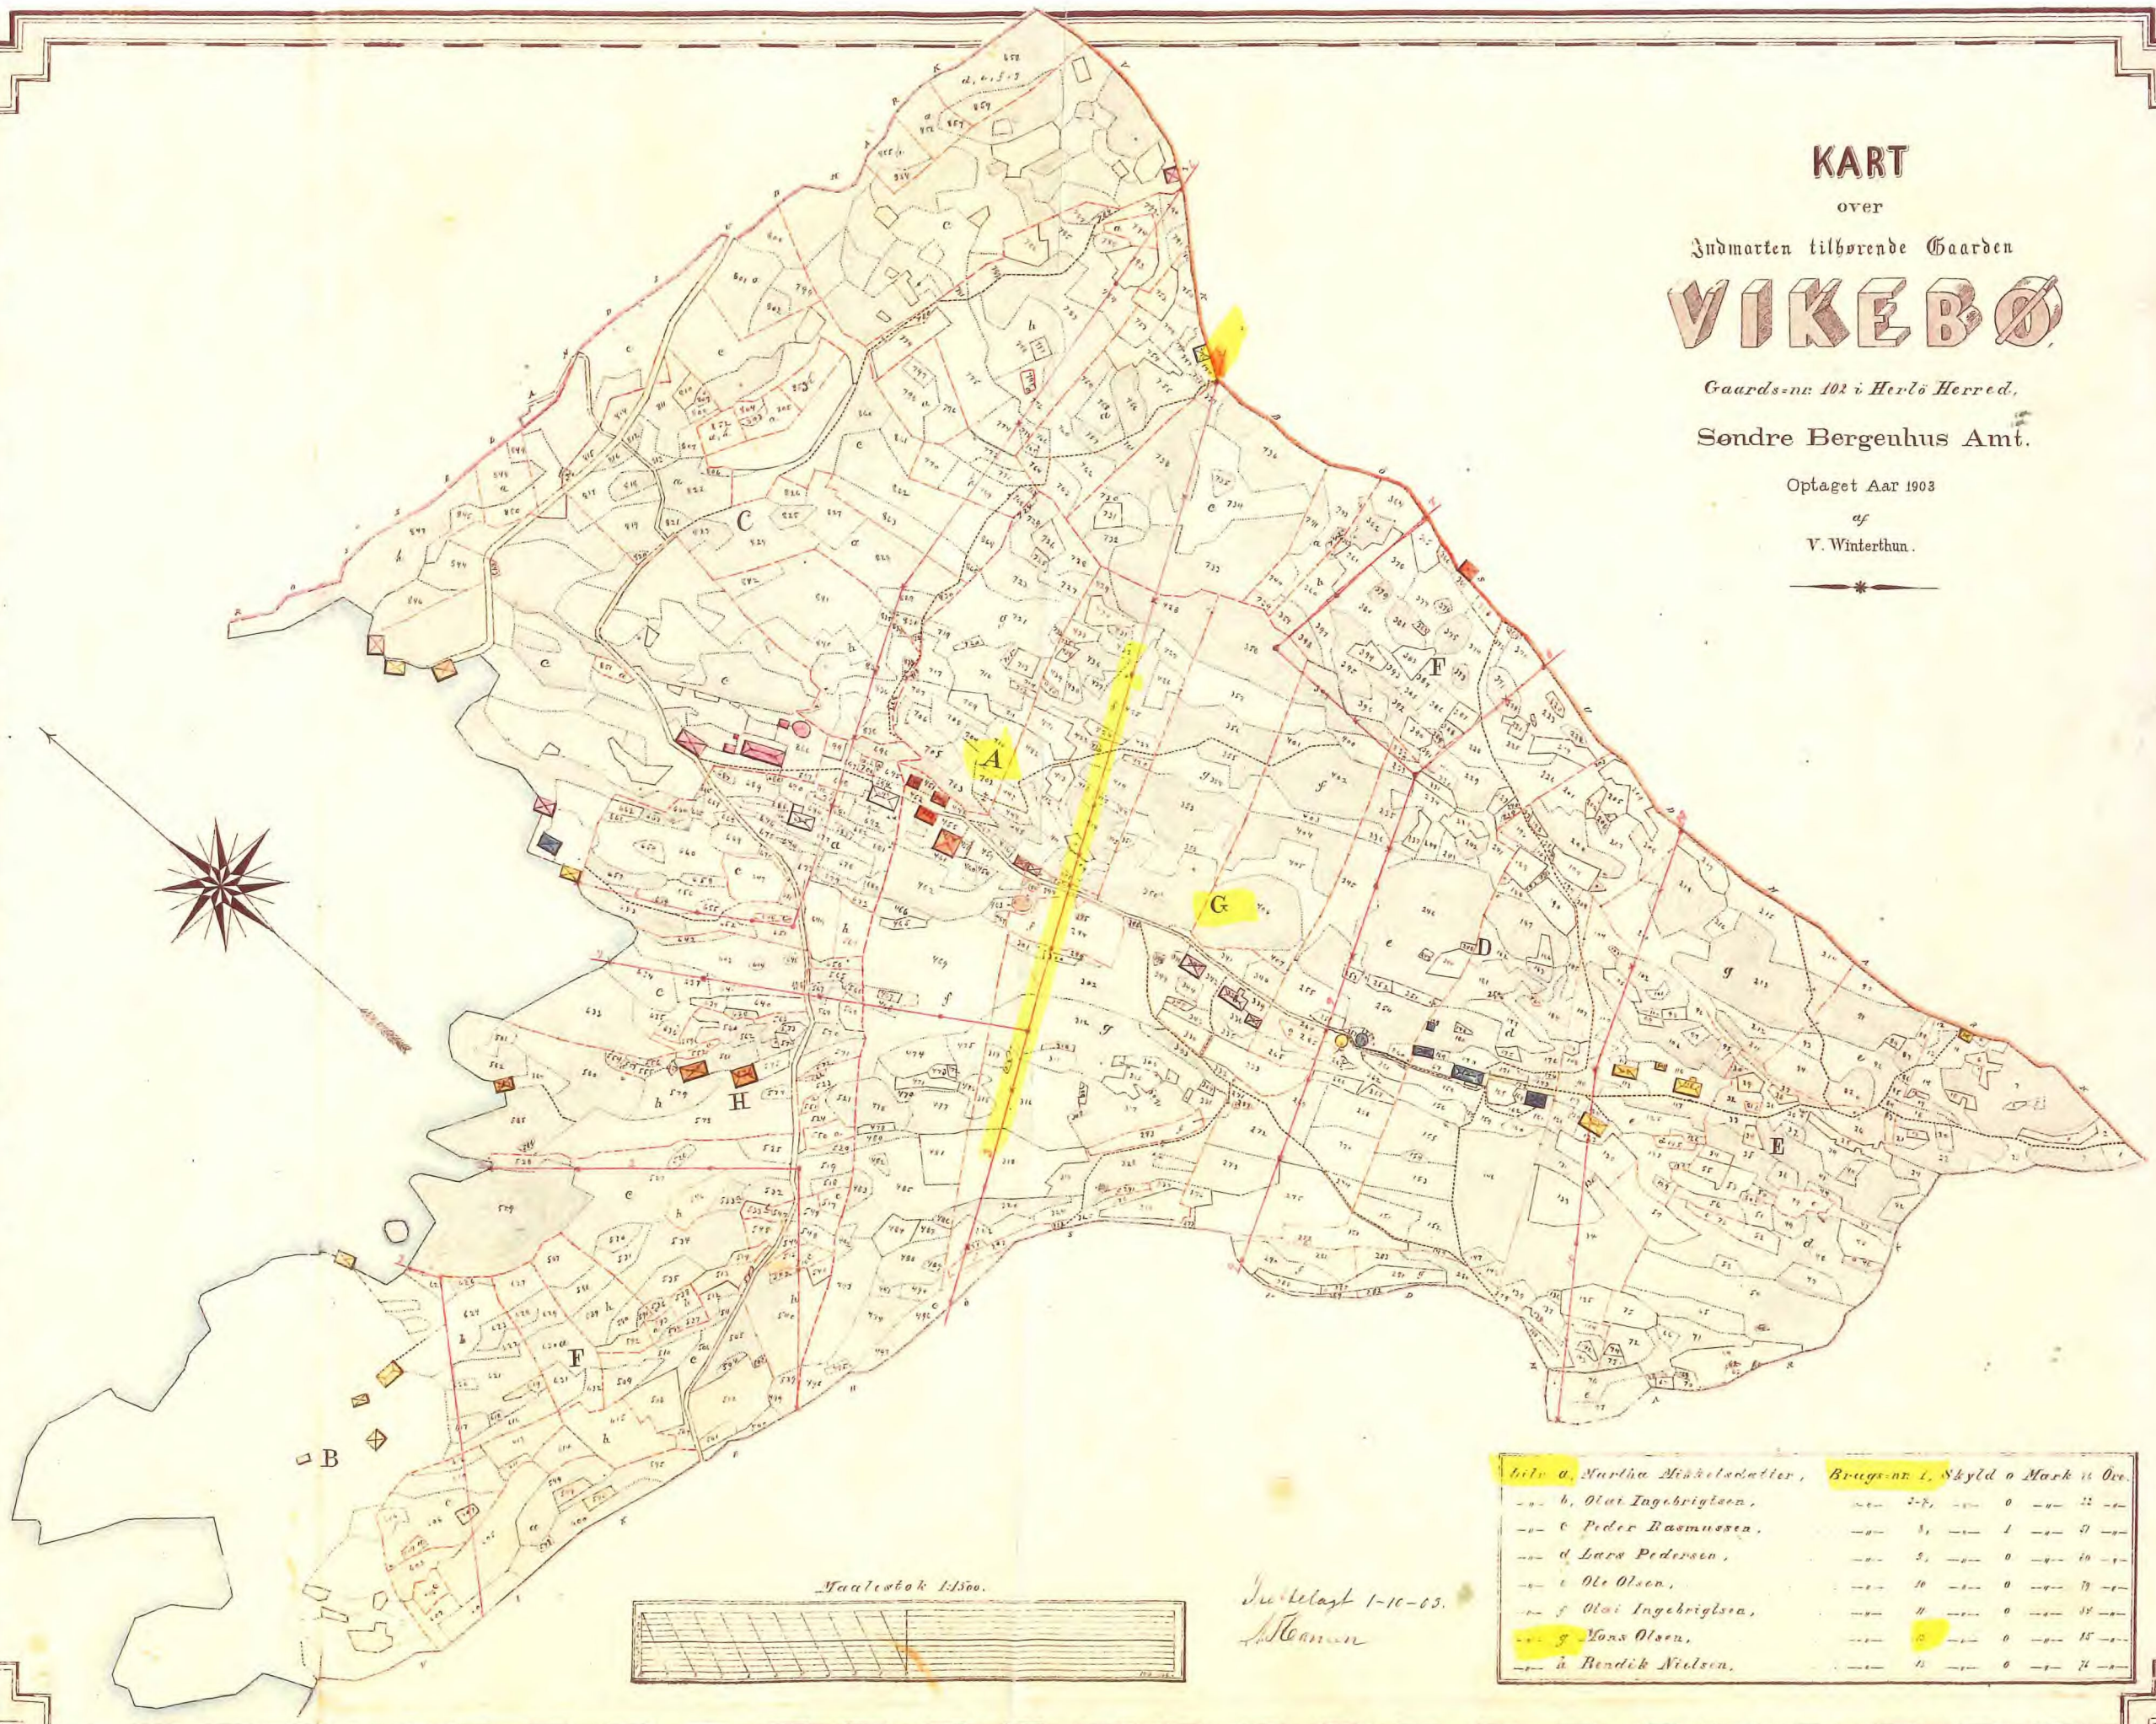


*Maalestok 1:1500.*

Lige a. Martha Mikkeladatter, Brugs-nr. 1, Skyld o Mark u. Ov.	
b. Olof Ingebrigtsen,	2-8, 0 - 22 -
c. Peder Rasmussen,	1, 1 - 31 -
d. Lars Pedersen,	3, 0 - 60 -
e. Ole Olsen,	10, 0 - 70 -
f. Olof Ingebrigtsen,	11, 0 - 18 -

*Ju. tilagt 1-10-03.  
 Hønen*


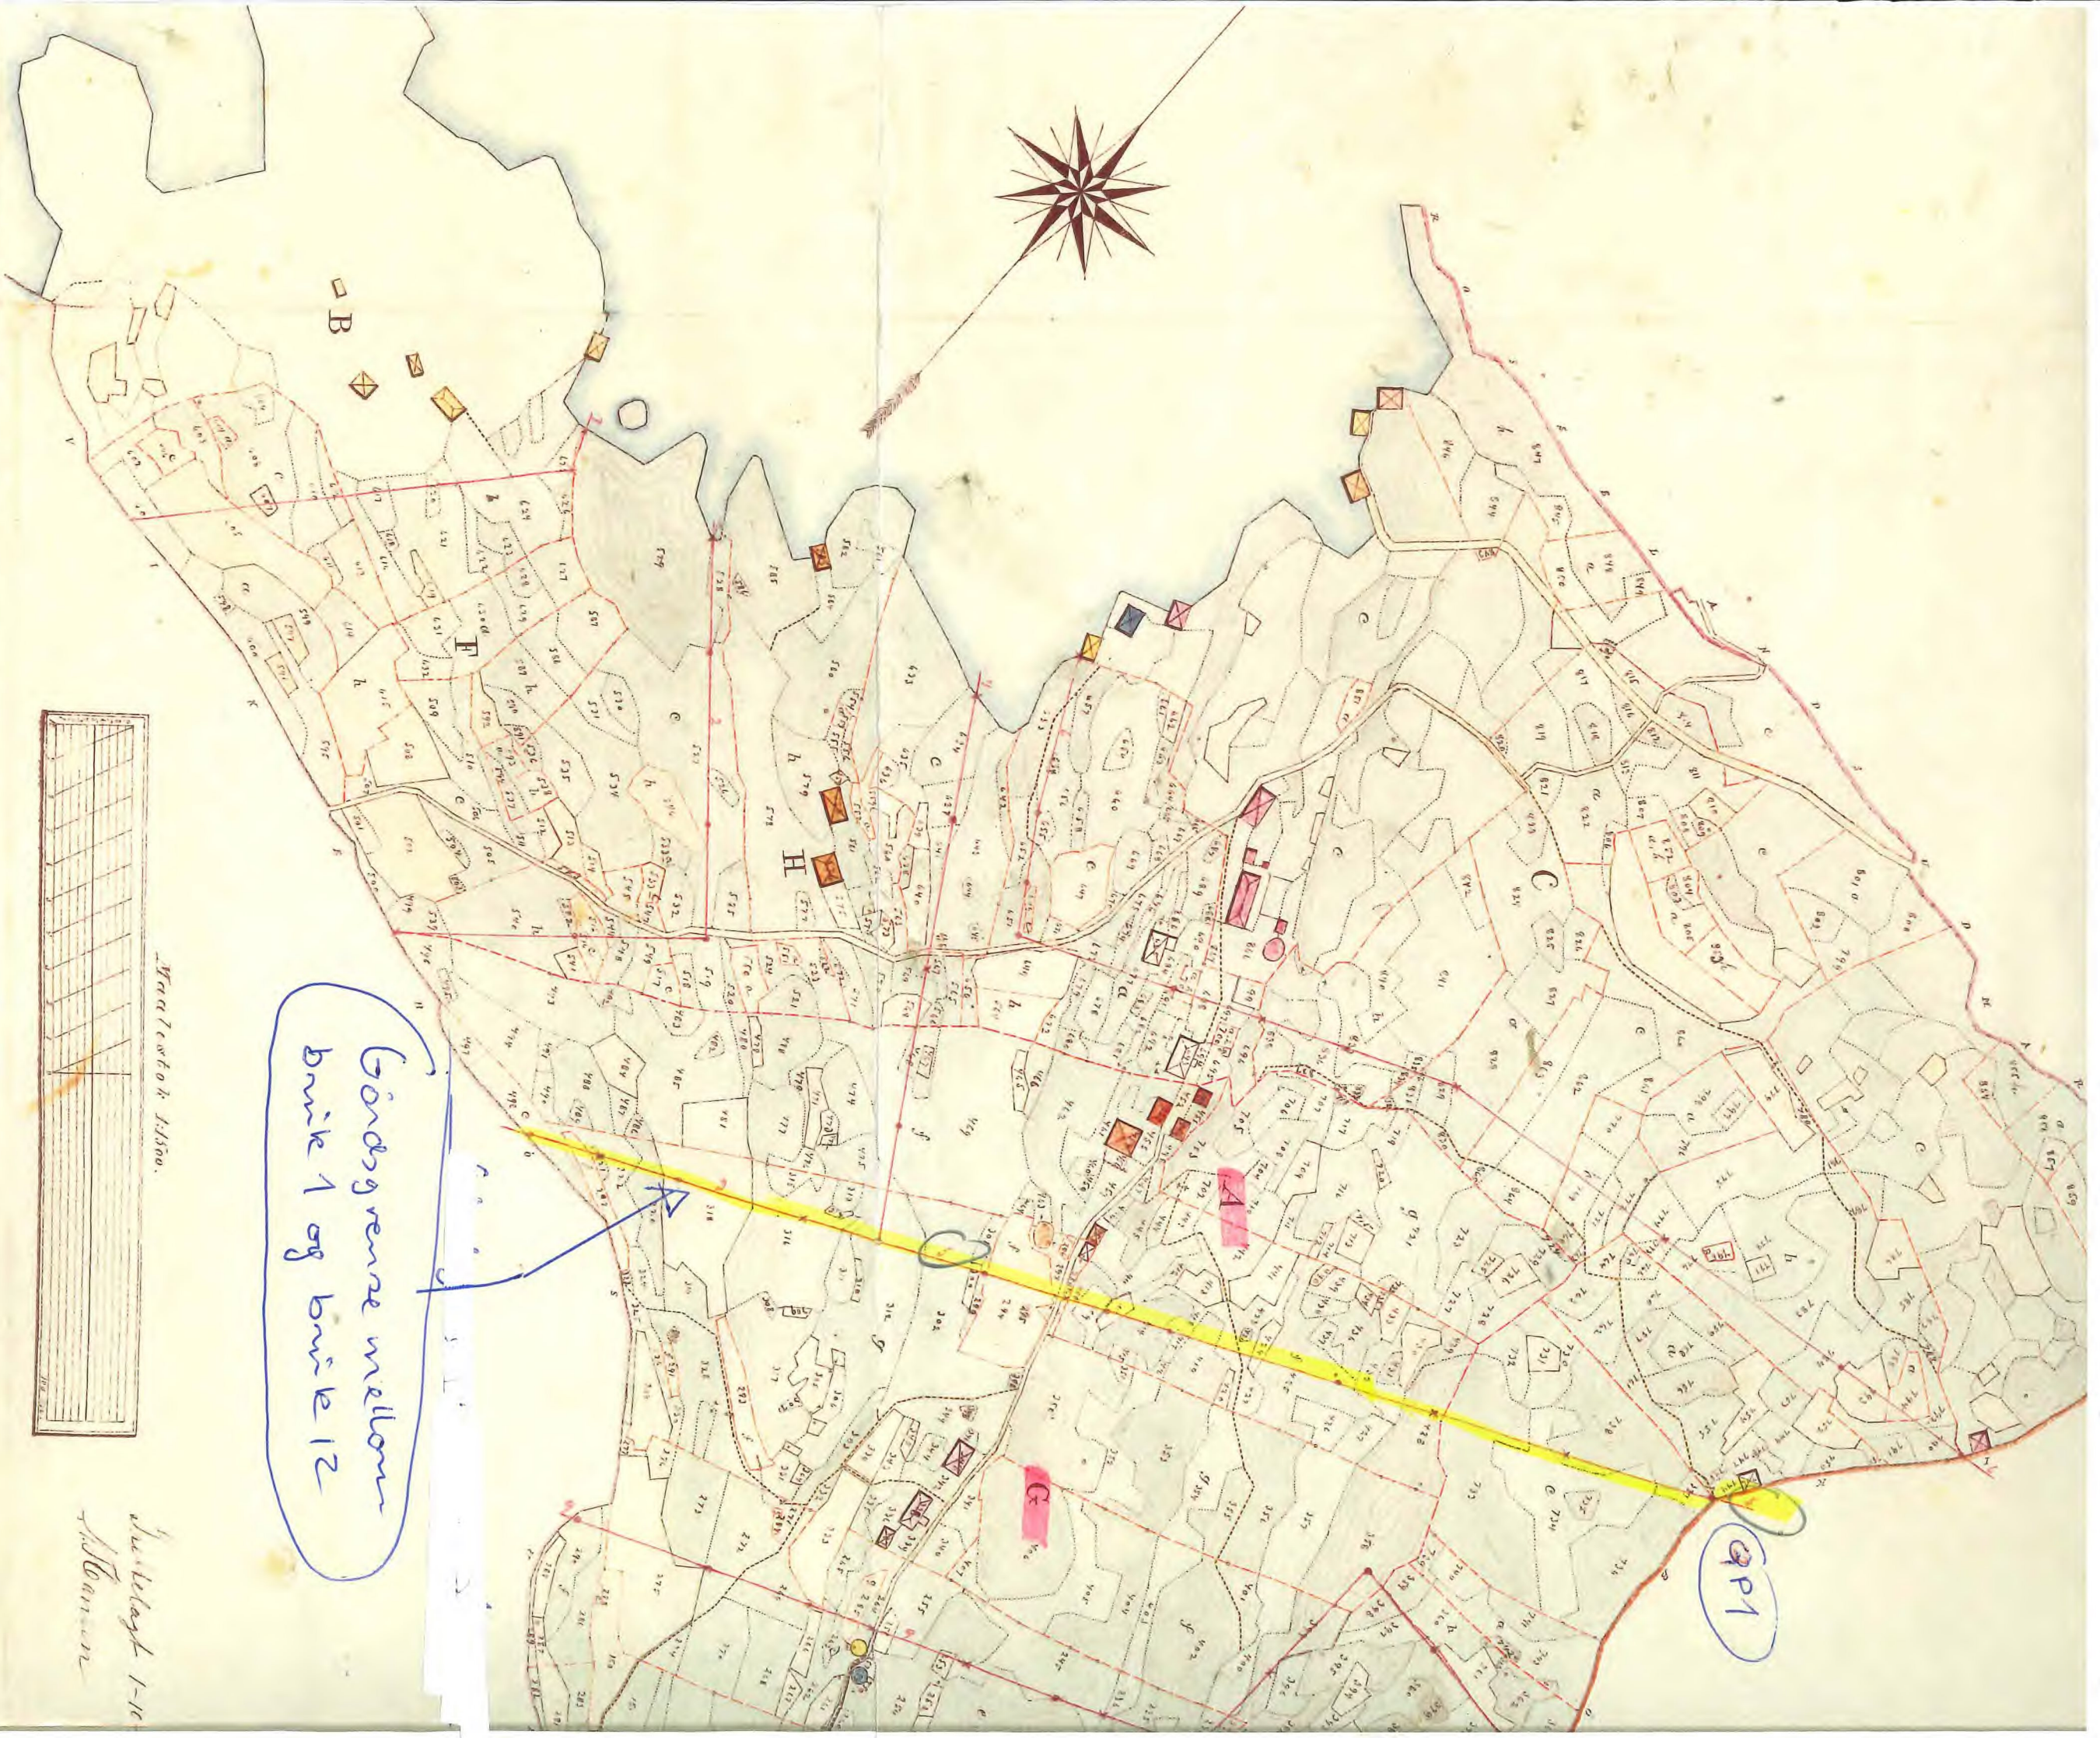

Bördsgrænse mellem  
brik 1 og brik 12




