




30m

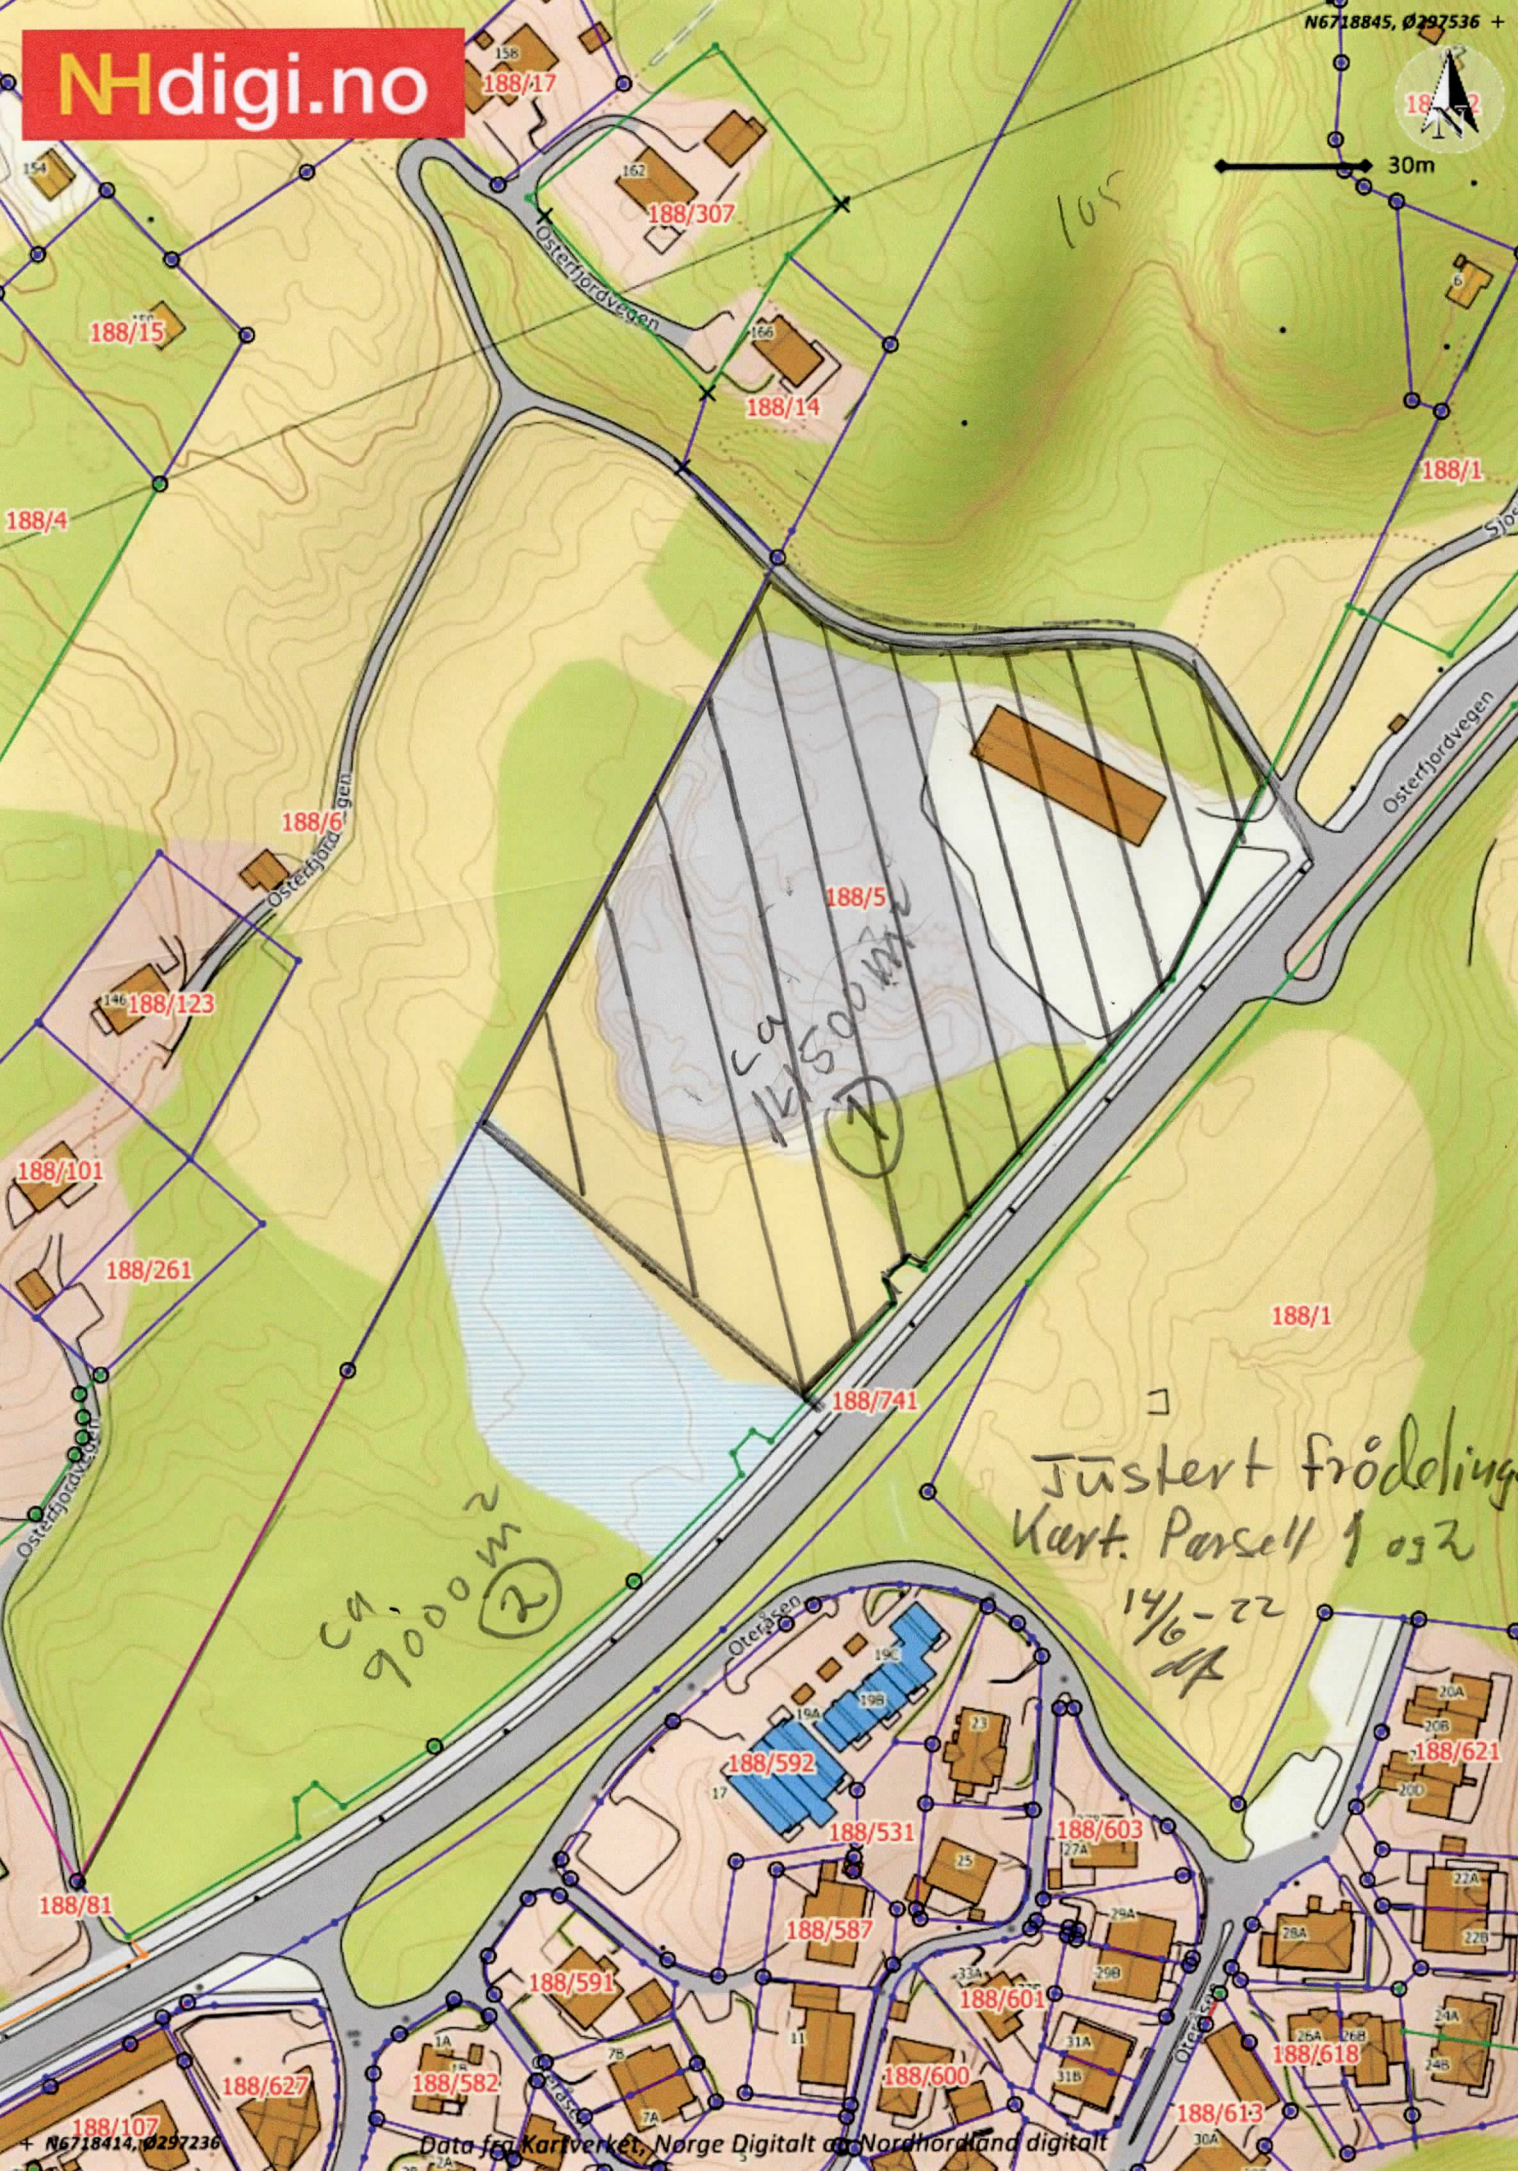

188/15

188/17

188/307

188/14

188/1

188/6

188/5

188/123

188/101

188/261

188/1

188/741

ca 9000 m<sup>2</sup> (2)

Jüstert frødeling  
Kart. Parsell 1 og 2  
14/6-22  
df

188/592

188/531

188/603

188/621

188/81

188/587

188/591

188/601

188/618

188/627

188/582

188/600

188/613

188/107