
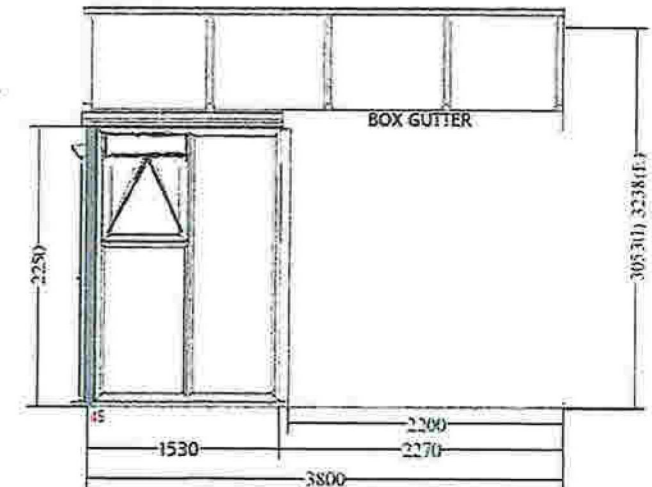
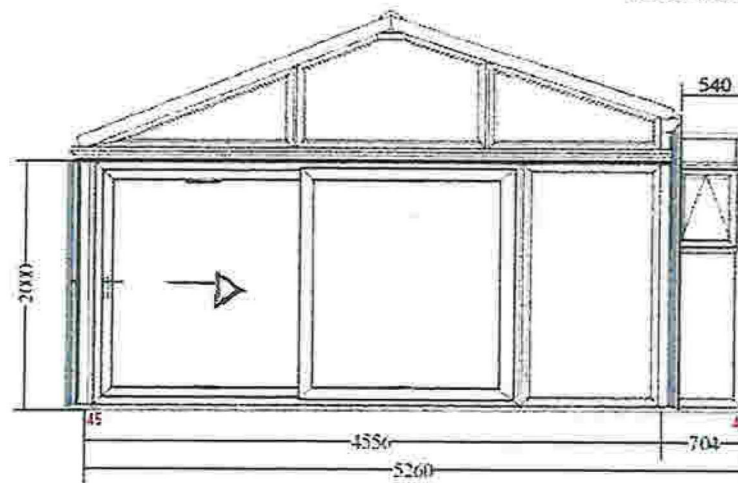


202

Eaves Beam Finish To Outside of Corner Post  
Eaves Beam Finish Flush To External Roof Bar

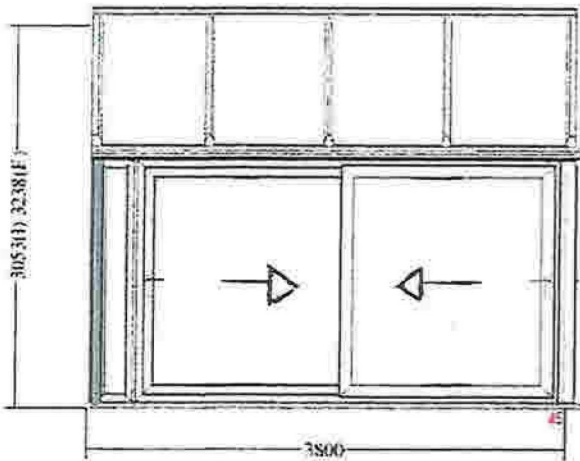


**GARTNERTEKNIKK AS**  
DRIVHJULSAHAGESTUER

Job No:- 584147  
Ref:- Agnes Sonstabo

*All dimensions relating to perimeter are to internal face of supporting frames or face of host building unless otherwise stated.*

\* All dimensions shown are in millimetres and are to Internal Frames / Ring Beam \*



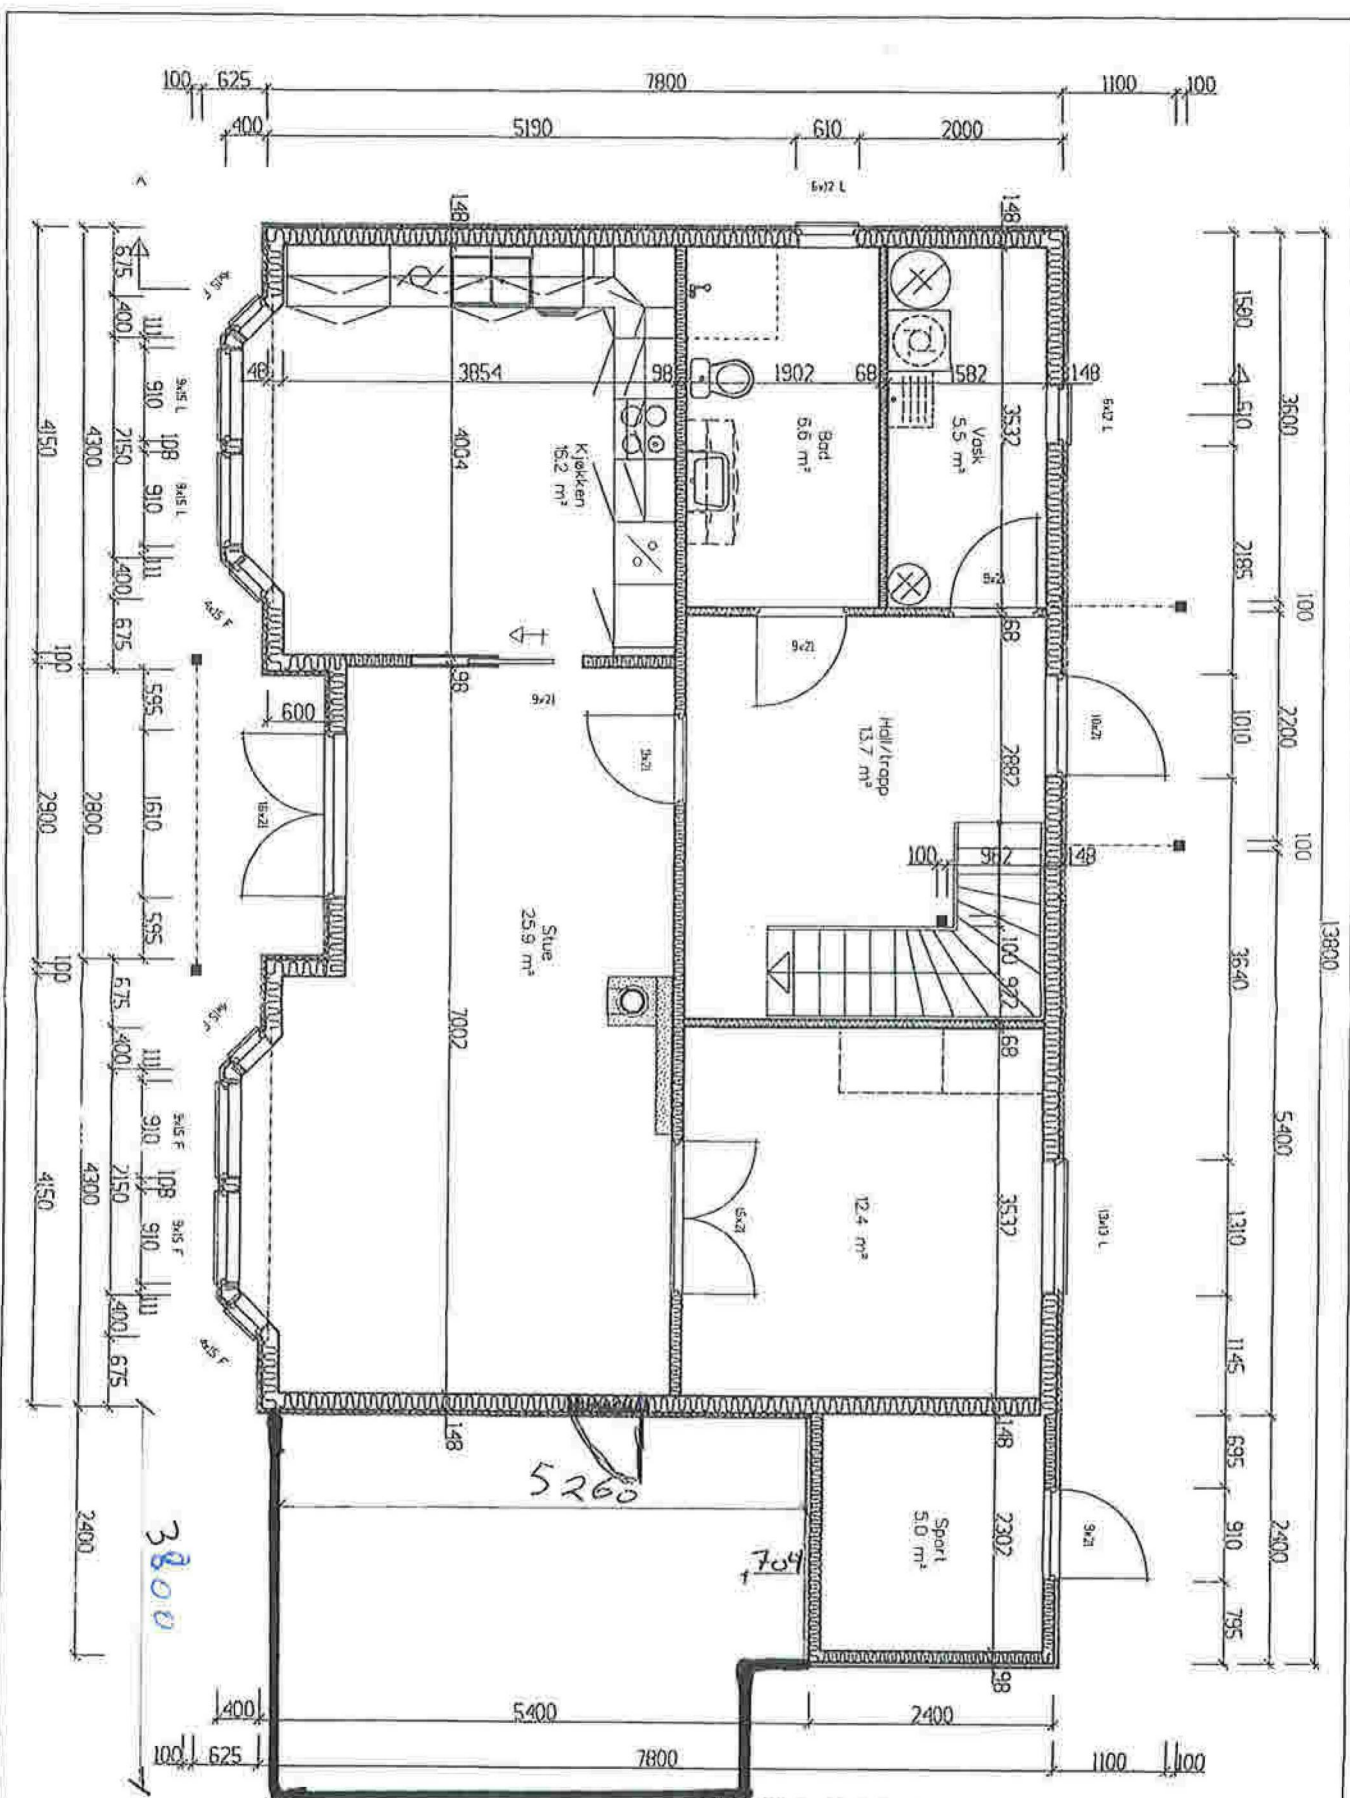

001 01.07.02 RGN Flyttet sportbad og trapp

DATA Design Studio

Prosjekt BOLIG HIBA I29+ rev.  
Tegning vedr. HOVEDPLAN

Prosjekt Id 02-049

Tilblotchevert CARL FREDRIK TONNING

Tegnr. 504

Byggested

Gnr. 1

Bnr. 1

Målestokk 1:50

Dato 11.04.02

Tegnet av TCK



Arkitekt BYGGERN VEST HIBA AS - 5039 BERGEN  
Leverandør STEVNEBØ TRELAST AS - 5037 BØVÅGEN

TLF 5518030 - FAX 5518037  
TLF 5636900 - FAX 5636940



© Tegningens bestilling skal ikke betales


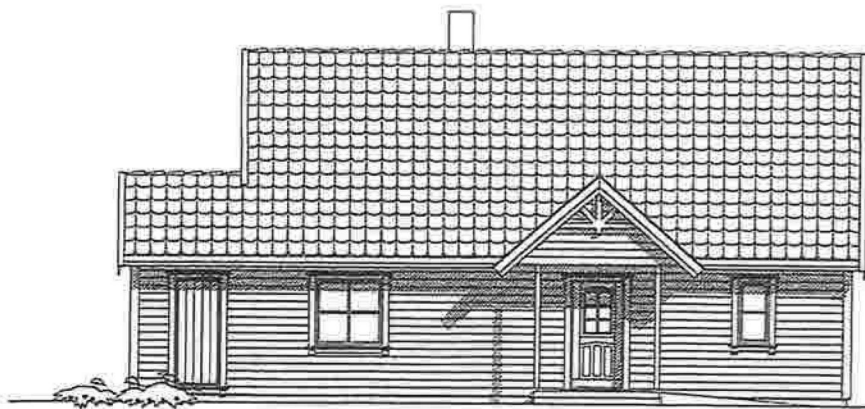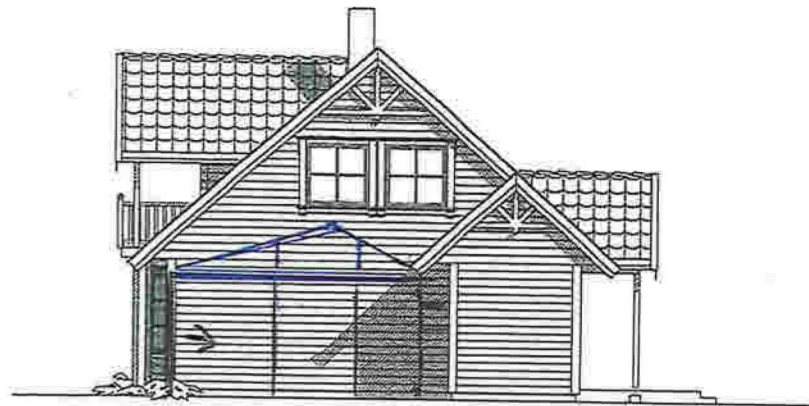

001 01.07.02 RGN Flyttet sportsbod

DATA Design System

Prosjekt BOLIG HIBA 129+ rev.  
Tegning vedr. FASADER

Prosjekt ID: 02-049  
Tegnning: 502  
Målestokk: 1:100  
Dato: 20.03.02  
Tegnet av: TOK

Tiltakshaver: CARL FREDRIK TONNING

Byggetid: Gnr.: Bnr.:

Arkitekt: BYGGERN VEST HIBA AS - 5039 BERGEN  
Leverandør: STEVNEBØ TRELAST AS - 5037 BØVAGEN

Tlf 5516039 - Fax 5516031  
Tlf 5634500 - Fax 5634541



(F)

© Tegningen er beskyttet. HIBA AS er ansvarlig.