



ORIGINAL TEIKNING 13.04.95 M 1:100
STEINAR SAGEN ALS - DIKETHAUGEN-VADAN
7024 TRONDHEIM

UTVIDING AV TERRASSE - ETABL. GARPÅRT OG LOZZER
ING. TAULE ALS - RÅDNYVEGEN 1400, 5936 MÅNGER

TILTAKSTAVER
RØNNARHAUGEN

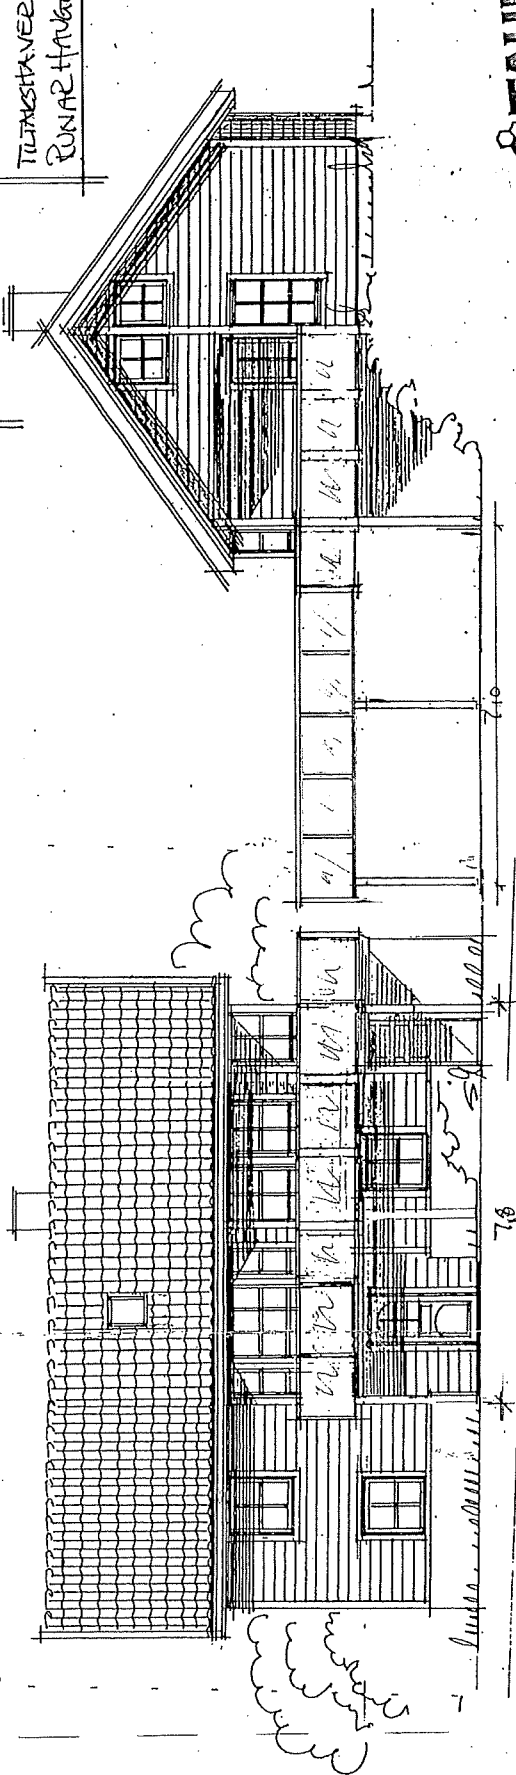


TAULE
ING. TAULE AS
TEL: 56 85 85 55 - MOB. 908 66 010
WWW.TAULE.NO

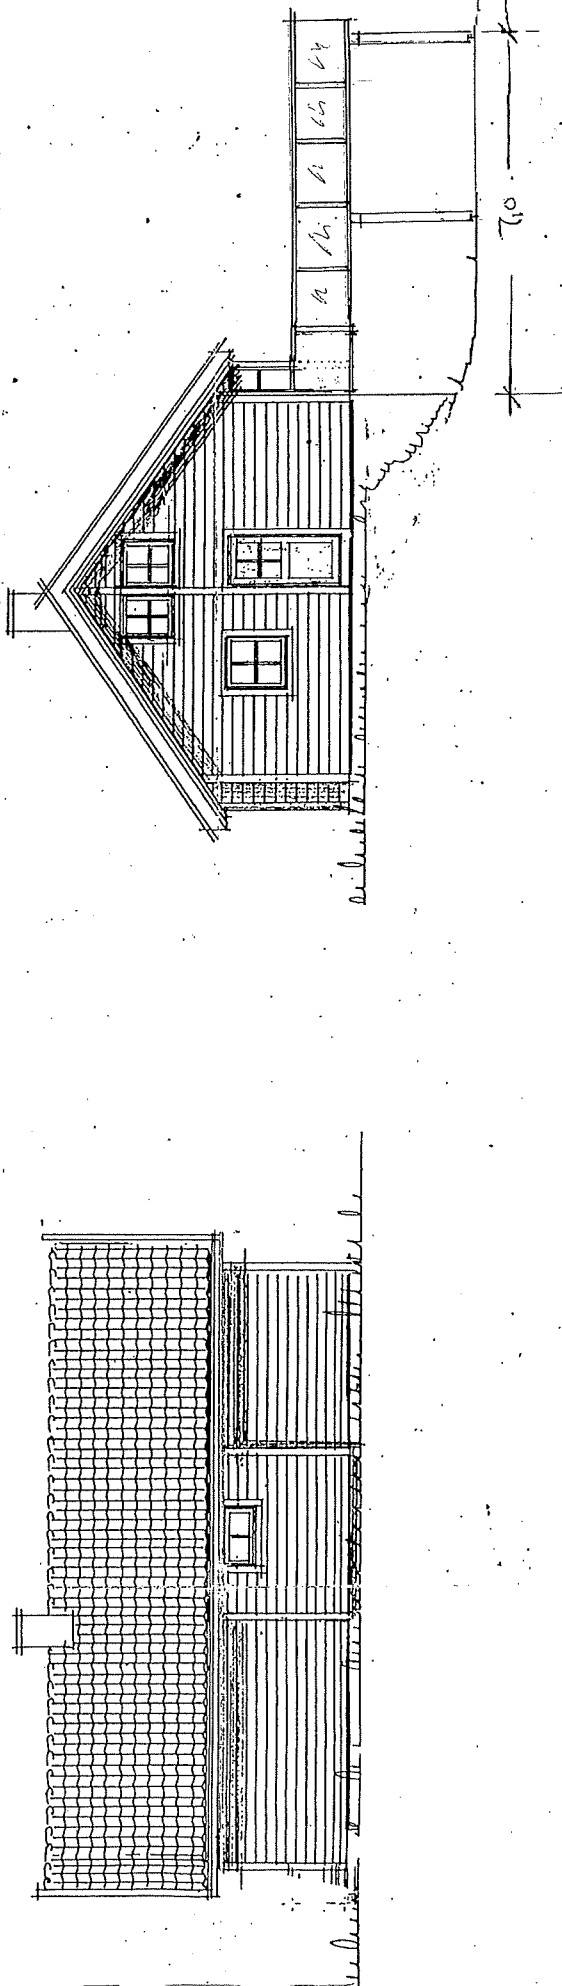

E2

ELKREDDINGS-
GRENSE

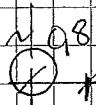


EKSIST. TØRREMUR

ASFALT

EKSIST. TERRENG

FUNDAMENT
SØLVE NYBYGG
TERRASSE

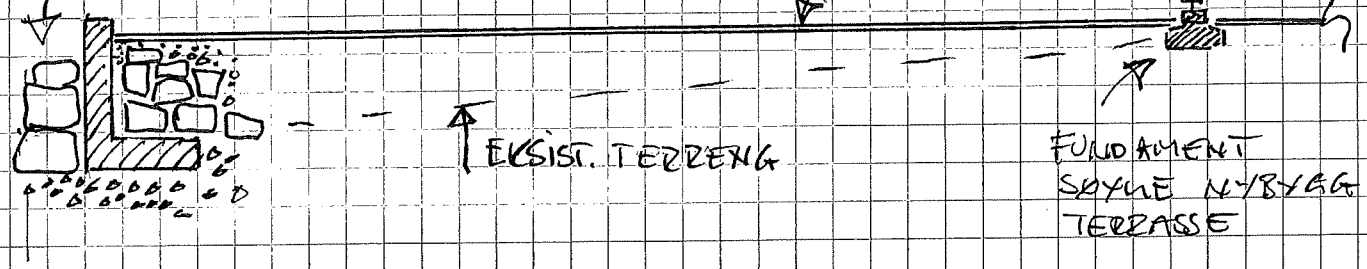

SKJITT A-A OG


TYPISK SKJITT BETONGMUR
M 1850

GRNR. 137/532

KUBBALELTET 26

5916-1SDALSTØ

TILTAKSLEIVER 2 RUND HAUGEN

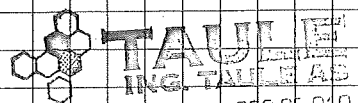

Tlf. 56 35 85 55. Mob. 908 65 010

TJS 711-22