


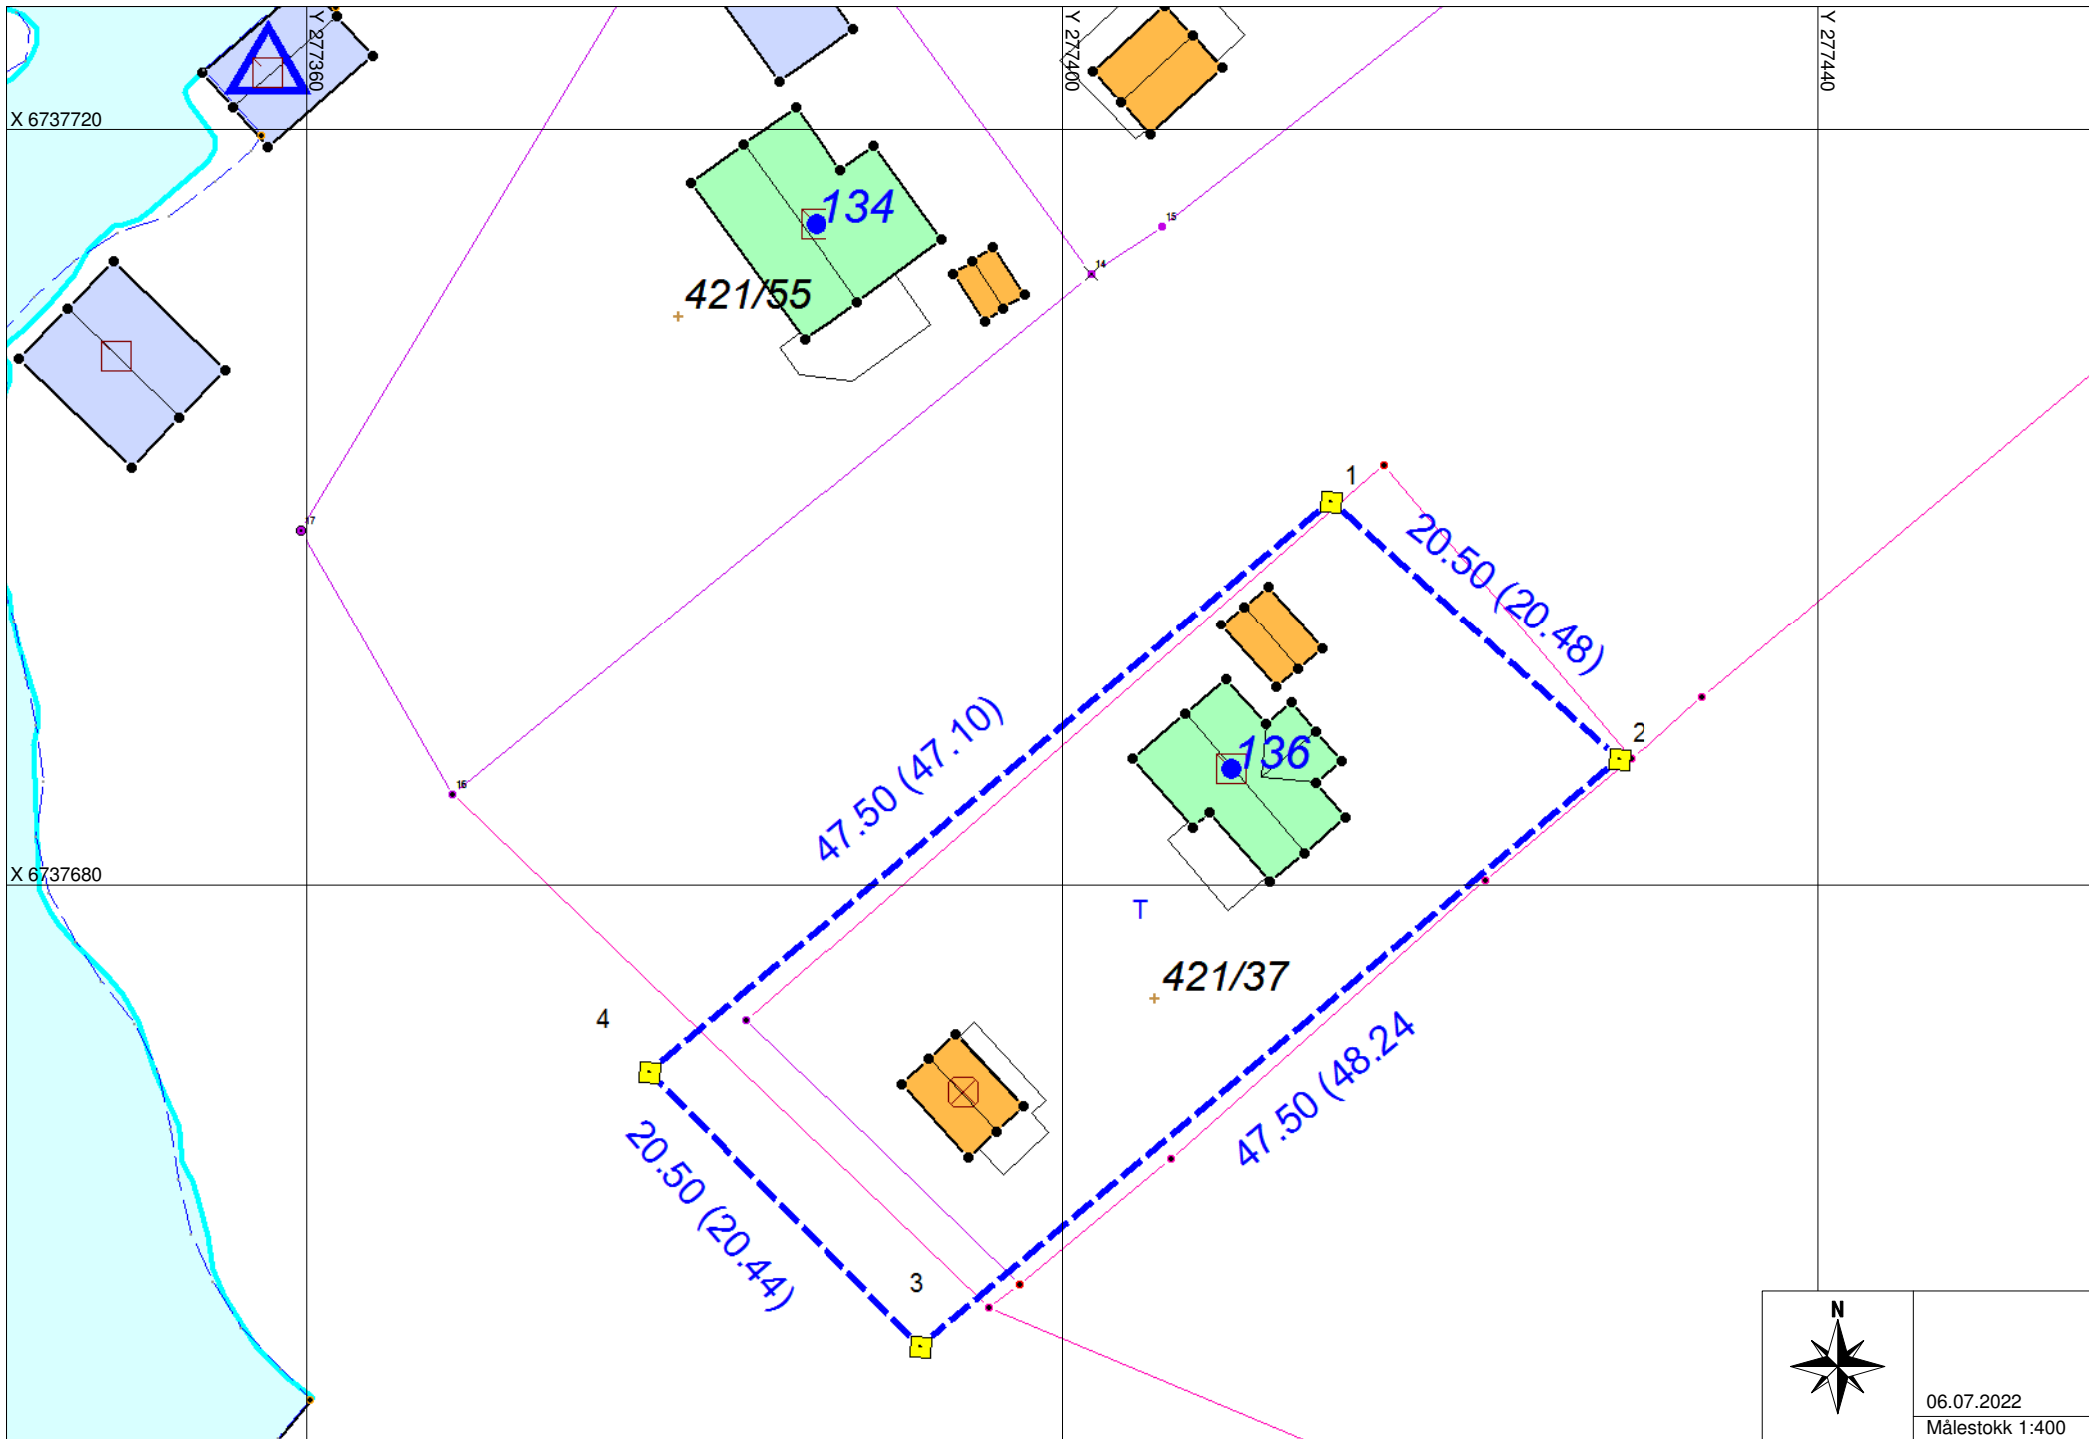

06.07.2022
Målestokk 1:400