



FØR

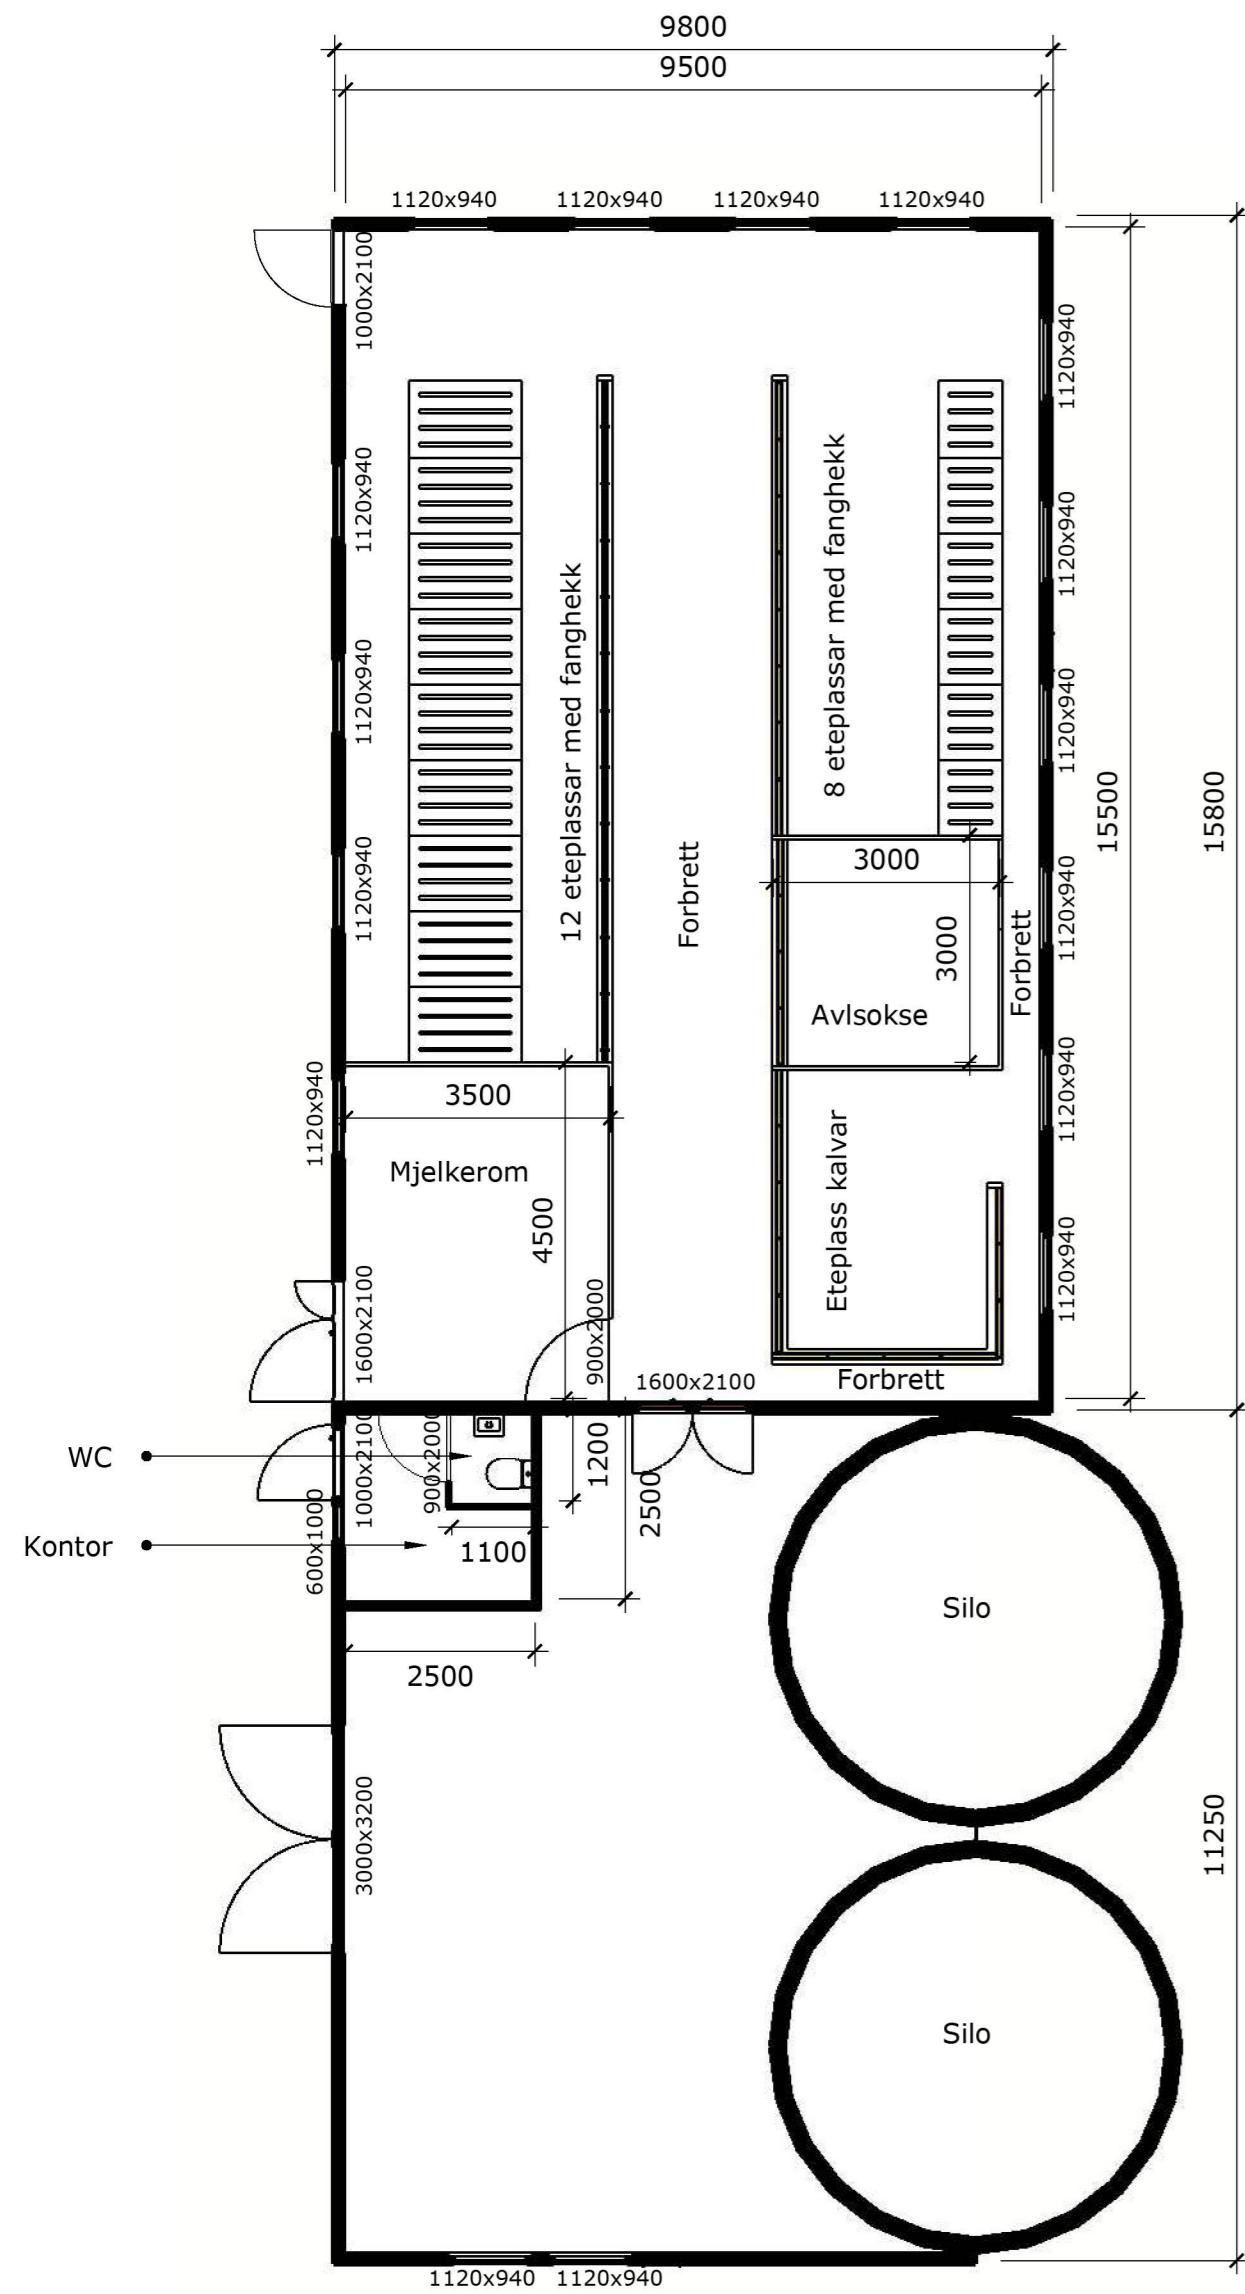

ETTER

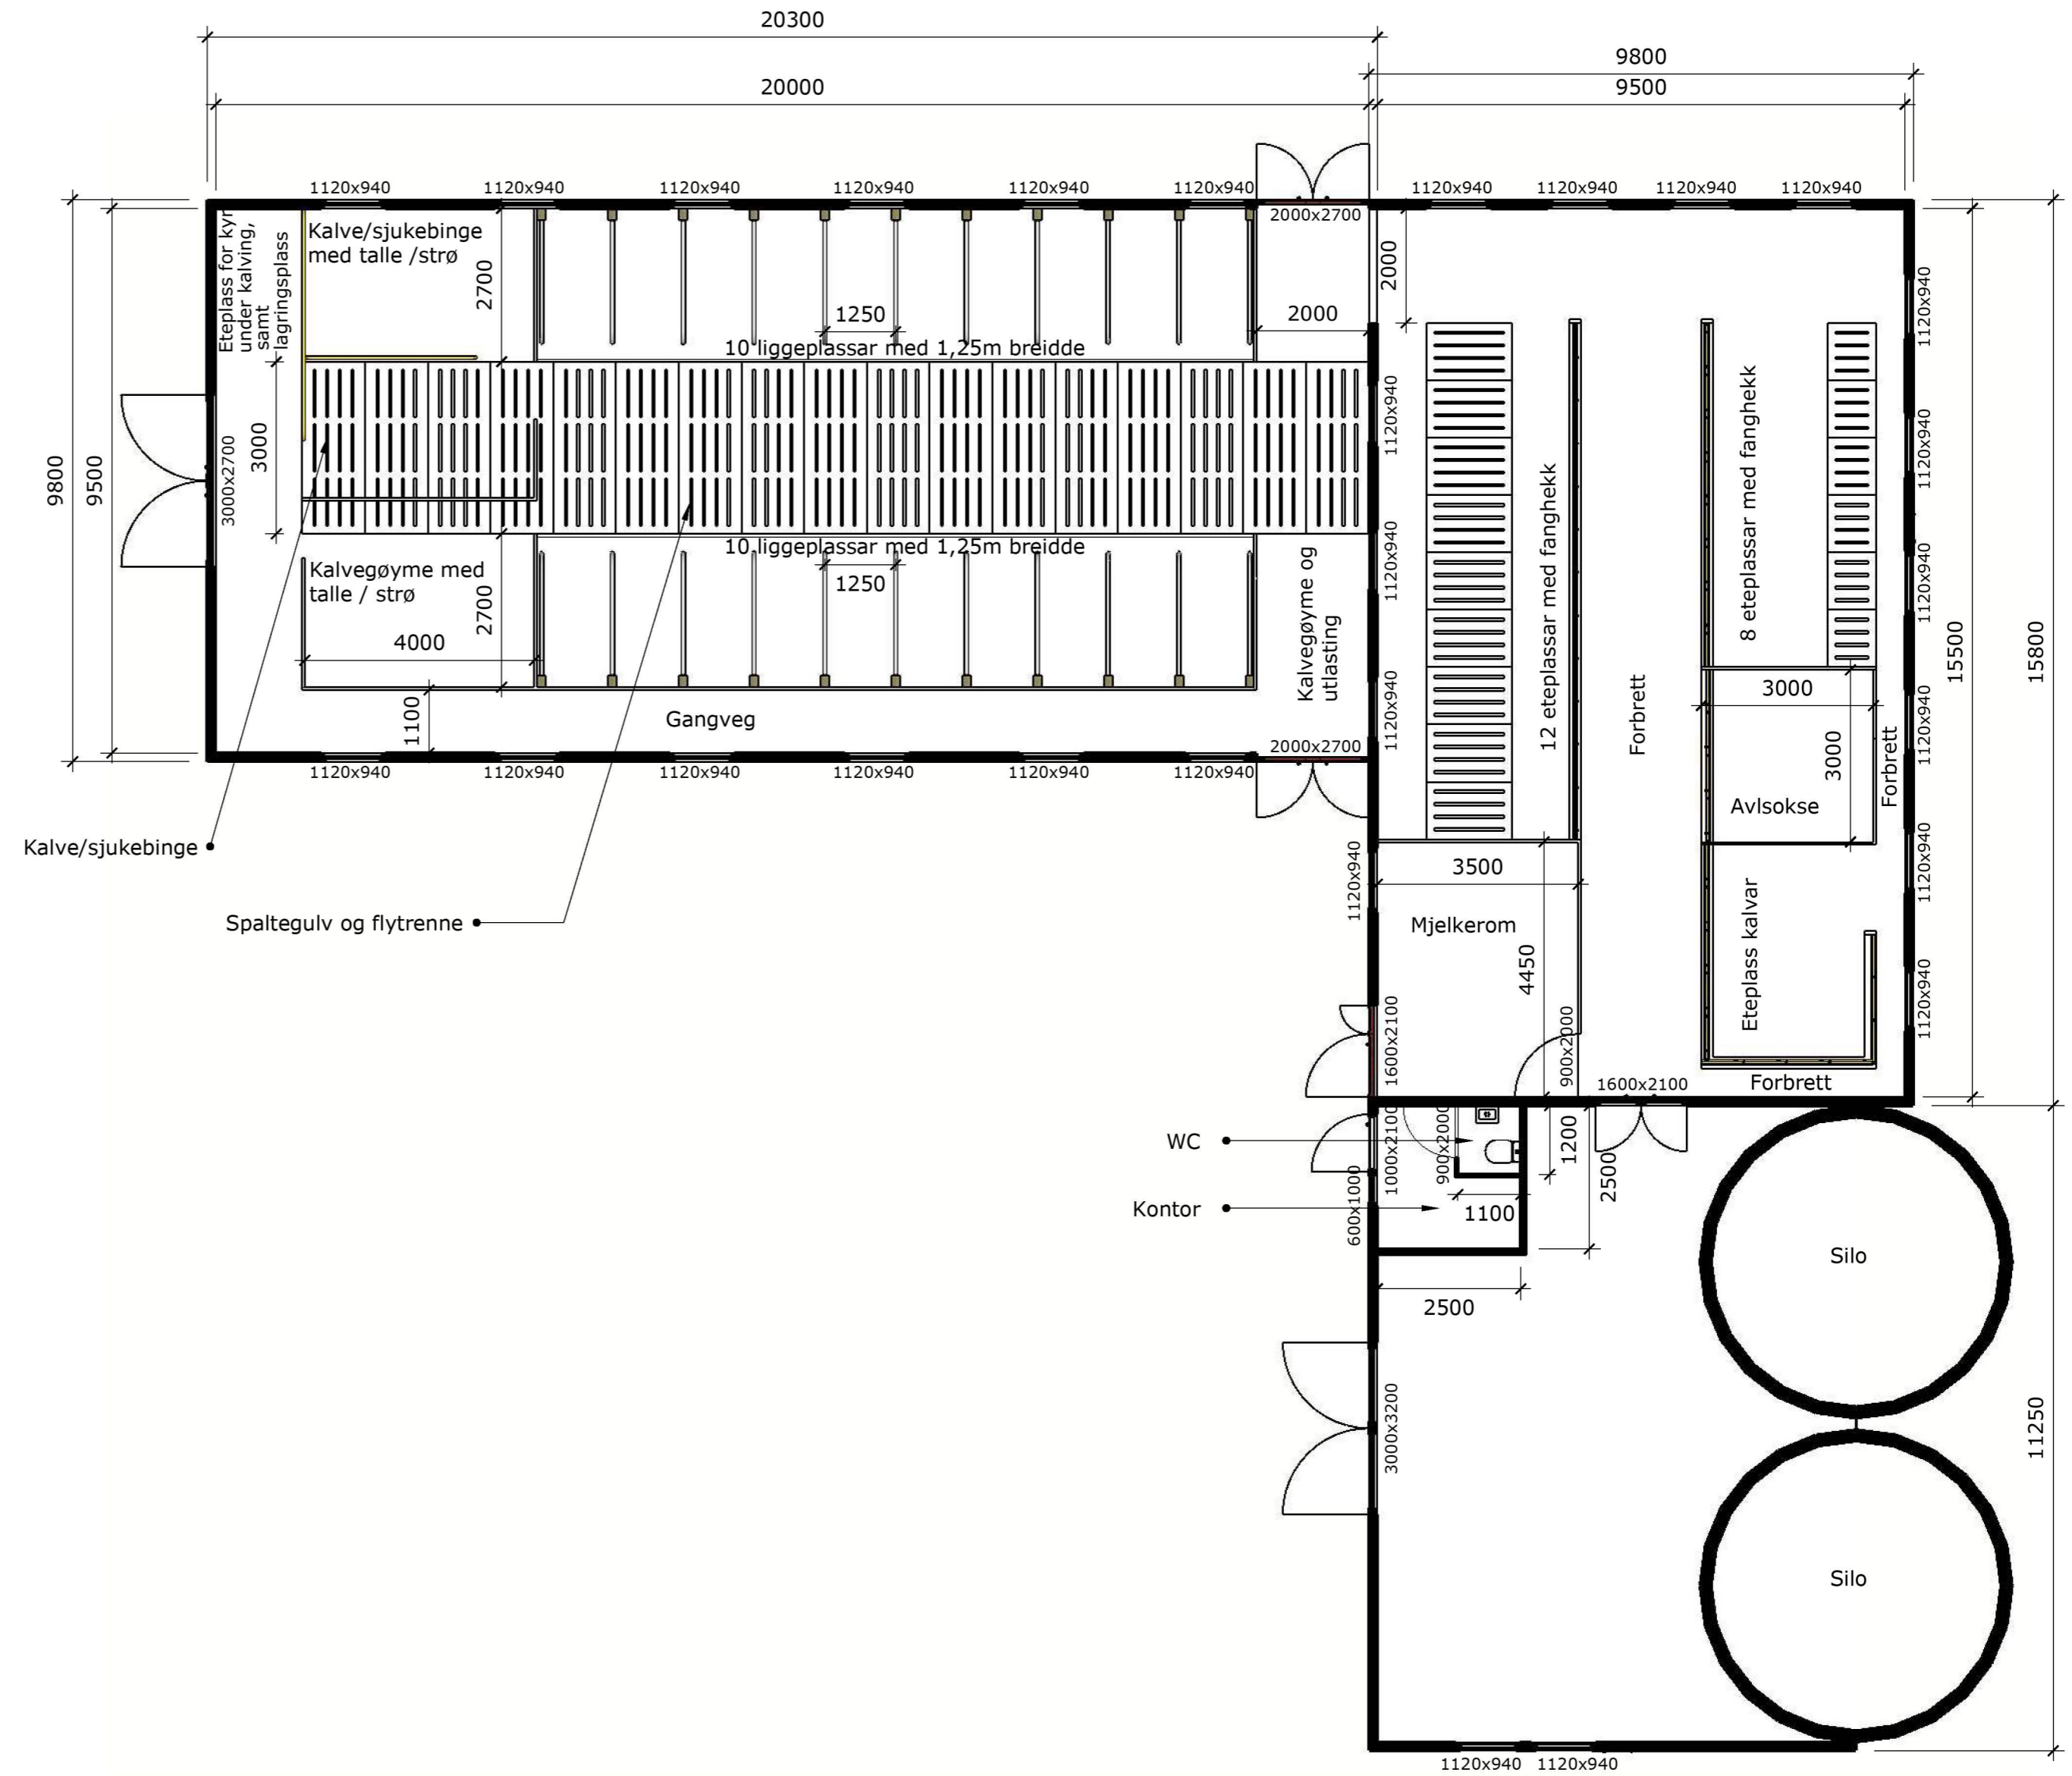

Item ref	Quantity	1 ETASJE			Invoice No.
Designed by Alexander Zhmaev	Tiltakshaver Johannes Nesse	Approved by date		Sheet format A2	Date 02.05.2022
www.360viz.no				TILBYGG AMMEKYR	
				Seimsstranda 483, 177/6	Edition 00