



FØR

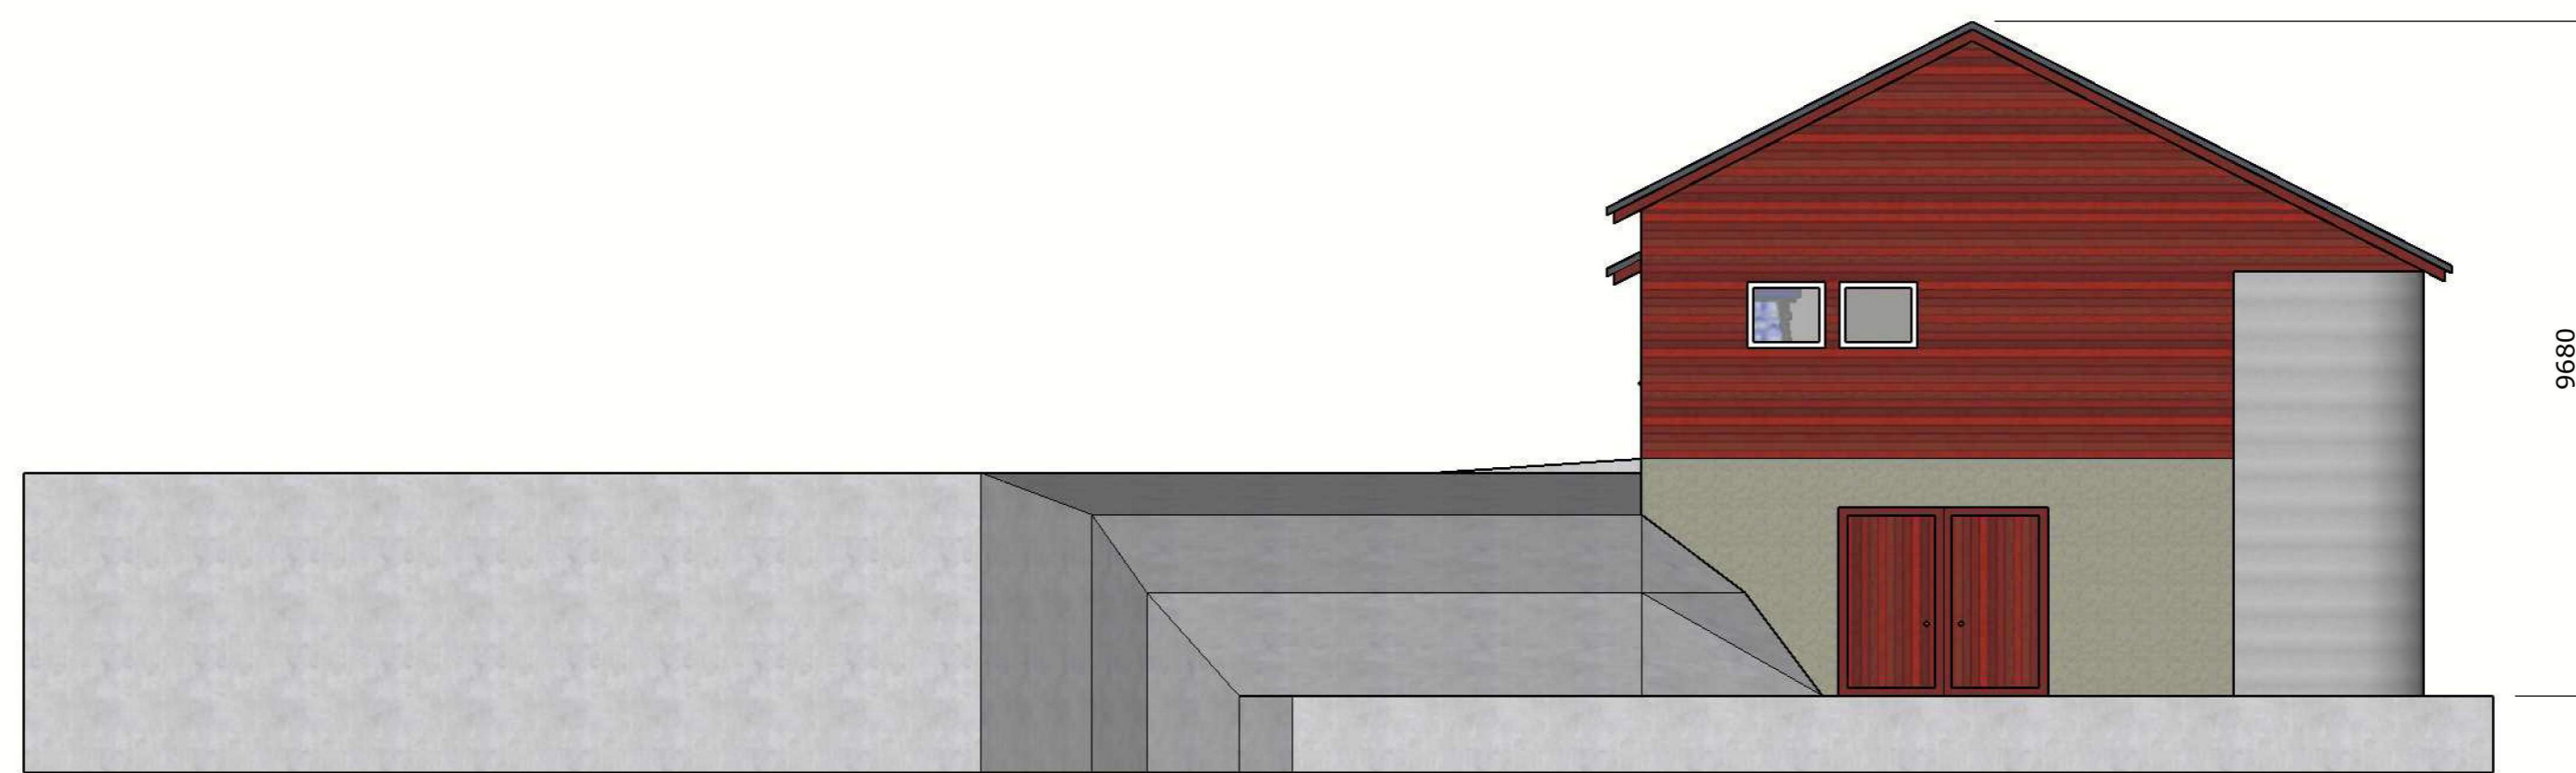

ETTER

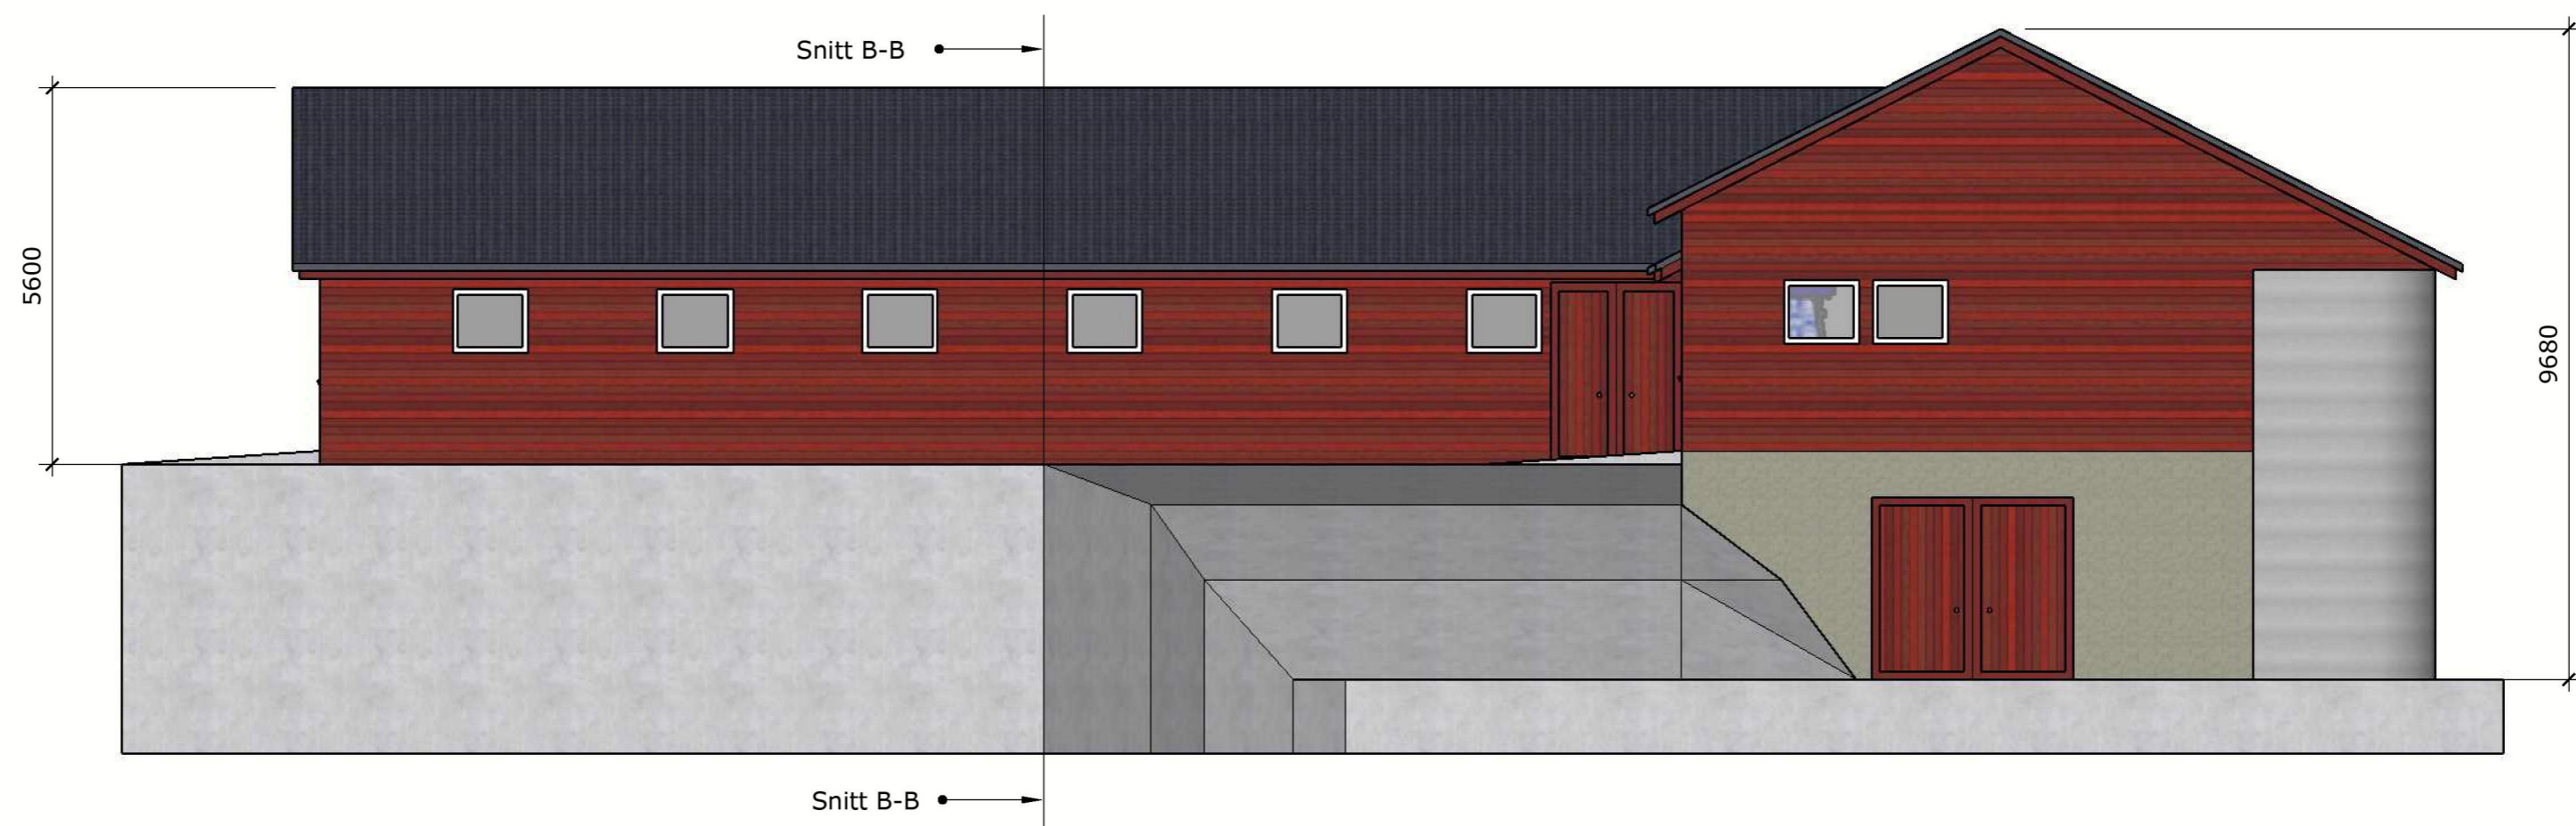

Item ref	Quantity	NORD			Invoice No.	
Designed by Alexander Zhmaev	Tiltakshaver Johannes Nesse	Approved by date		Sheet format A2	Date 02.05.2022	Scale 1:100
www.360viz.no				TILBYGG AMMEKYR		
				Seimsstranda 483, 177/6		Edition 00