


3

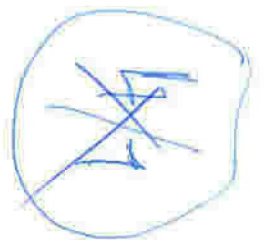





4/2

3





3

~~4~~






3

~~4/4~~



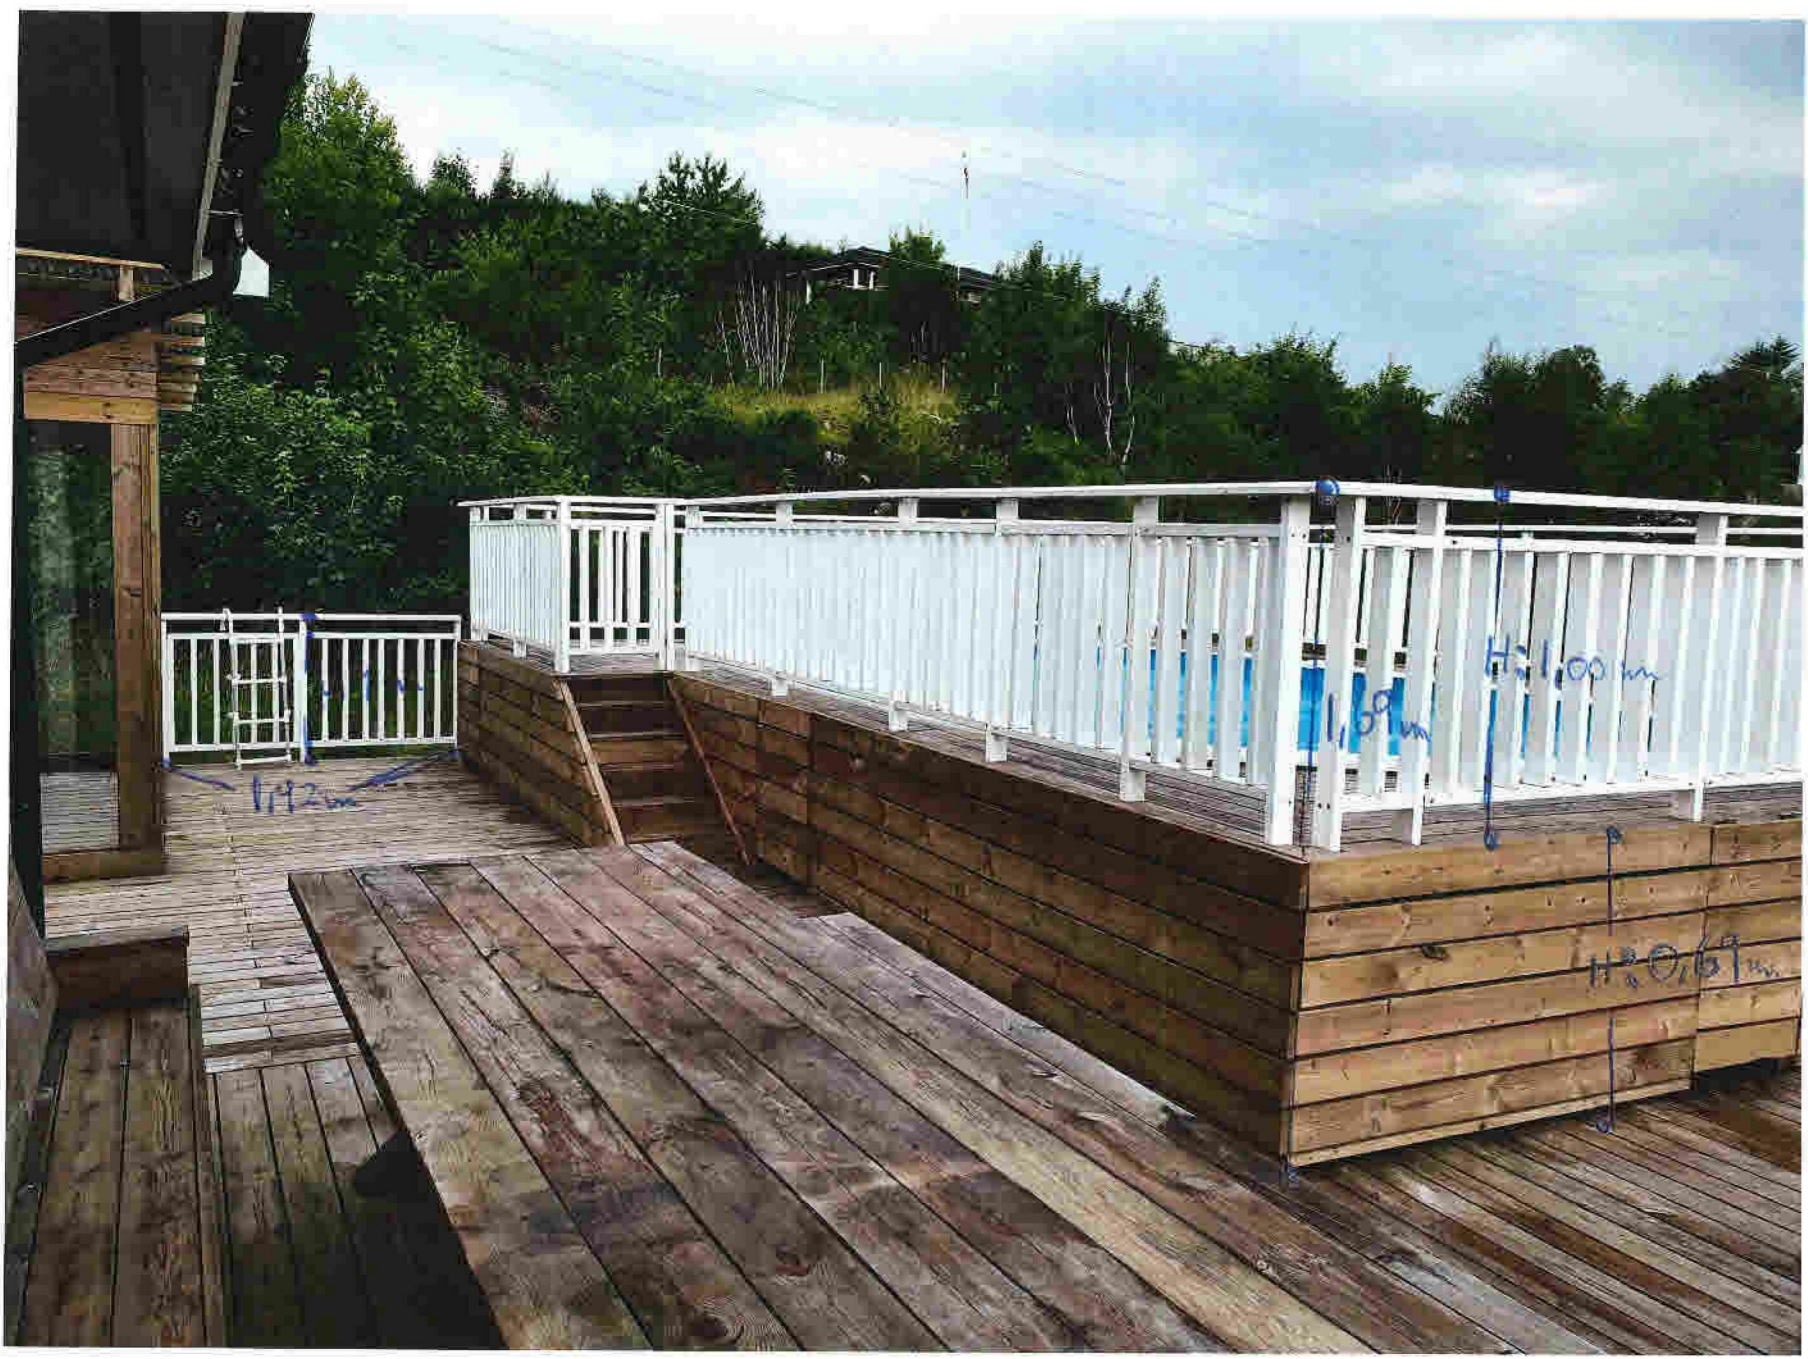

~~4/5~~

3





③ / ~~④~~