


1 SDALSTØBANKEN 101

Gbnr 137/259 (bygget)

137/826 (areal
rund)

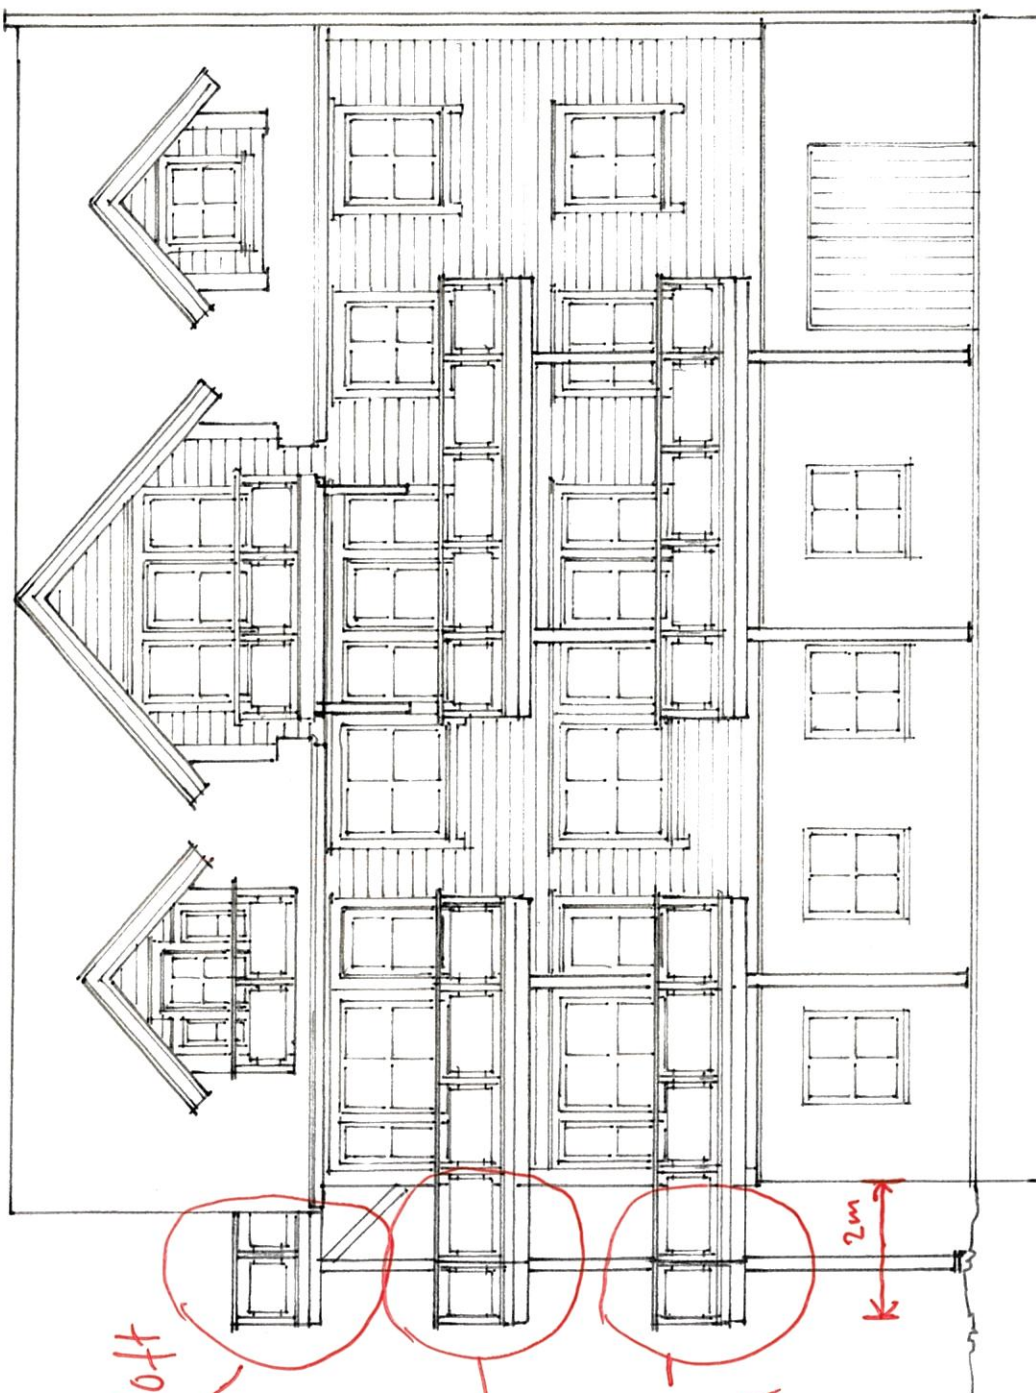

Altan loft

Altan 2. etg


Altan 1. etg

2m


FASADE SØR

AGE VIGLEIK NYHAMMER

KORRIGERT 24.7.17

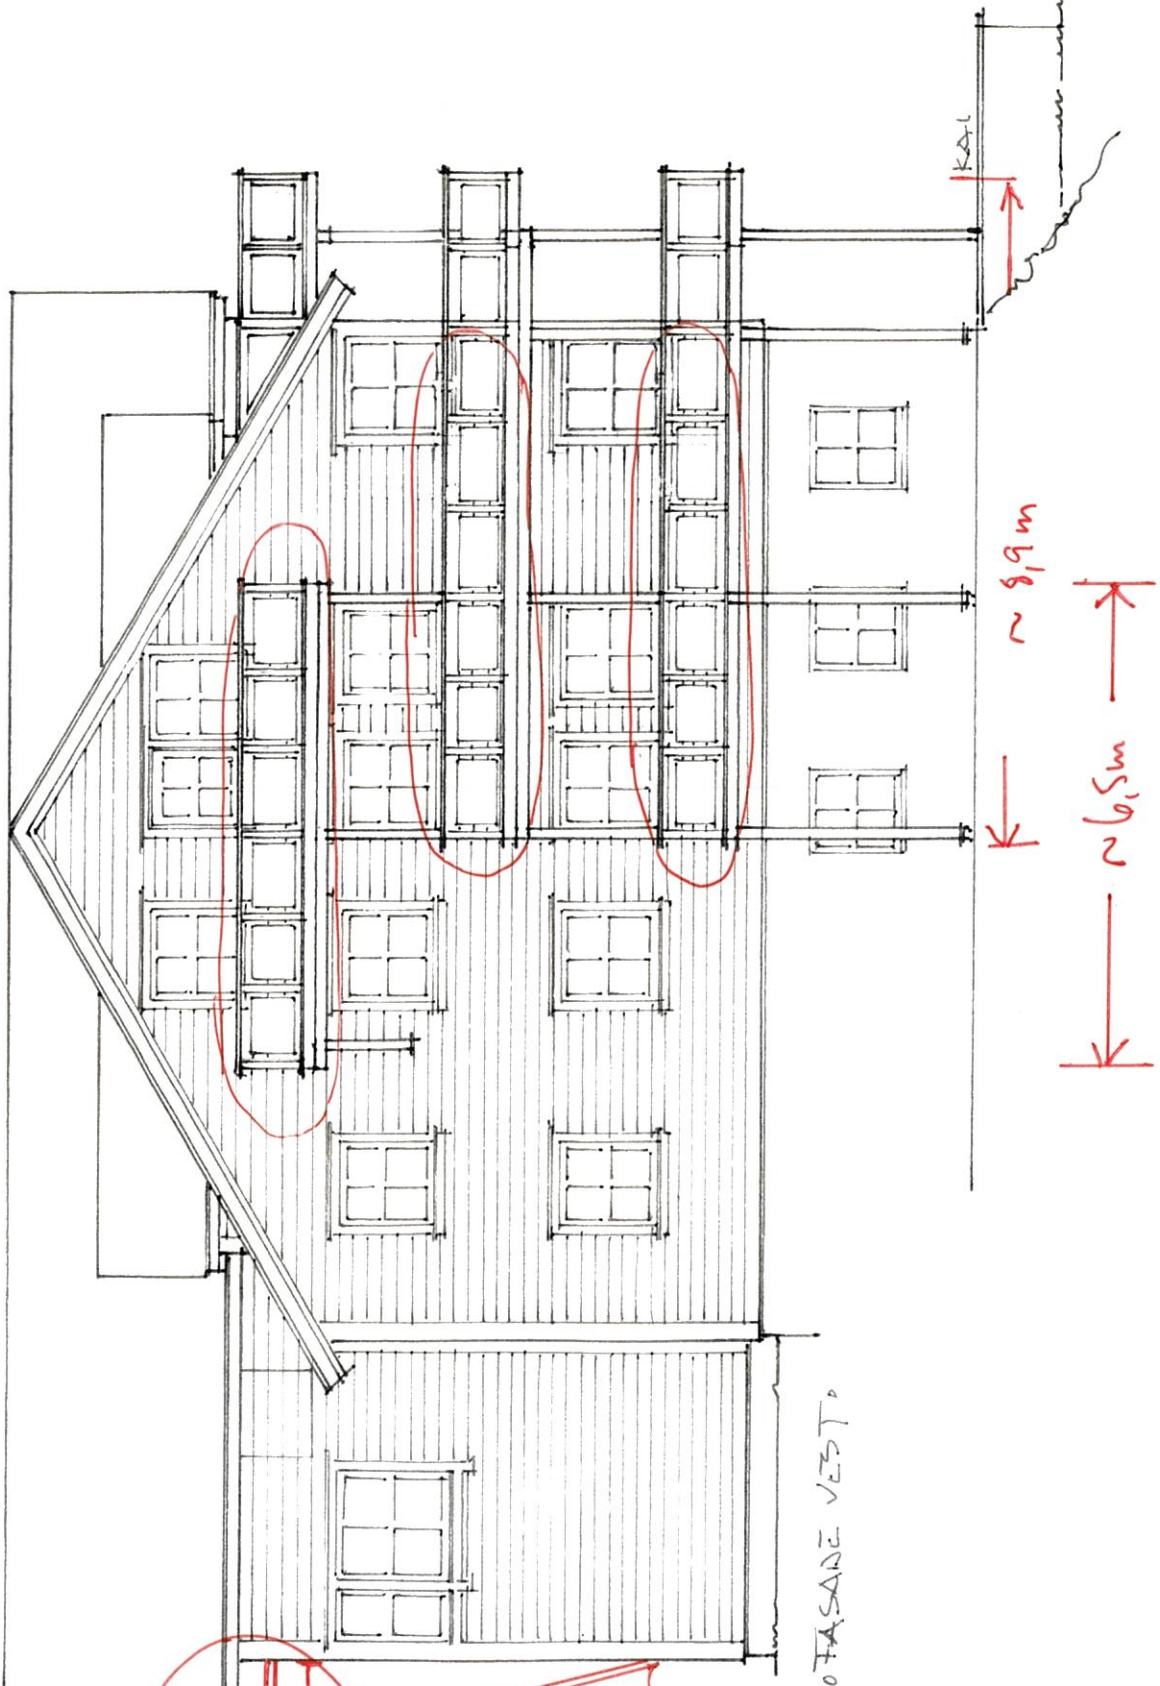

A
104.
104.

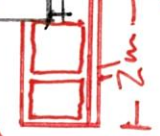


FASANE VEST

Karl

ÅGE VIGLEIK NYHAMMER

KORRIGERT 24.9.17

Altan loft

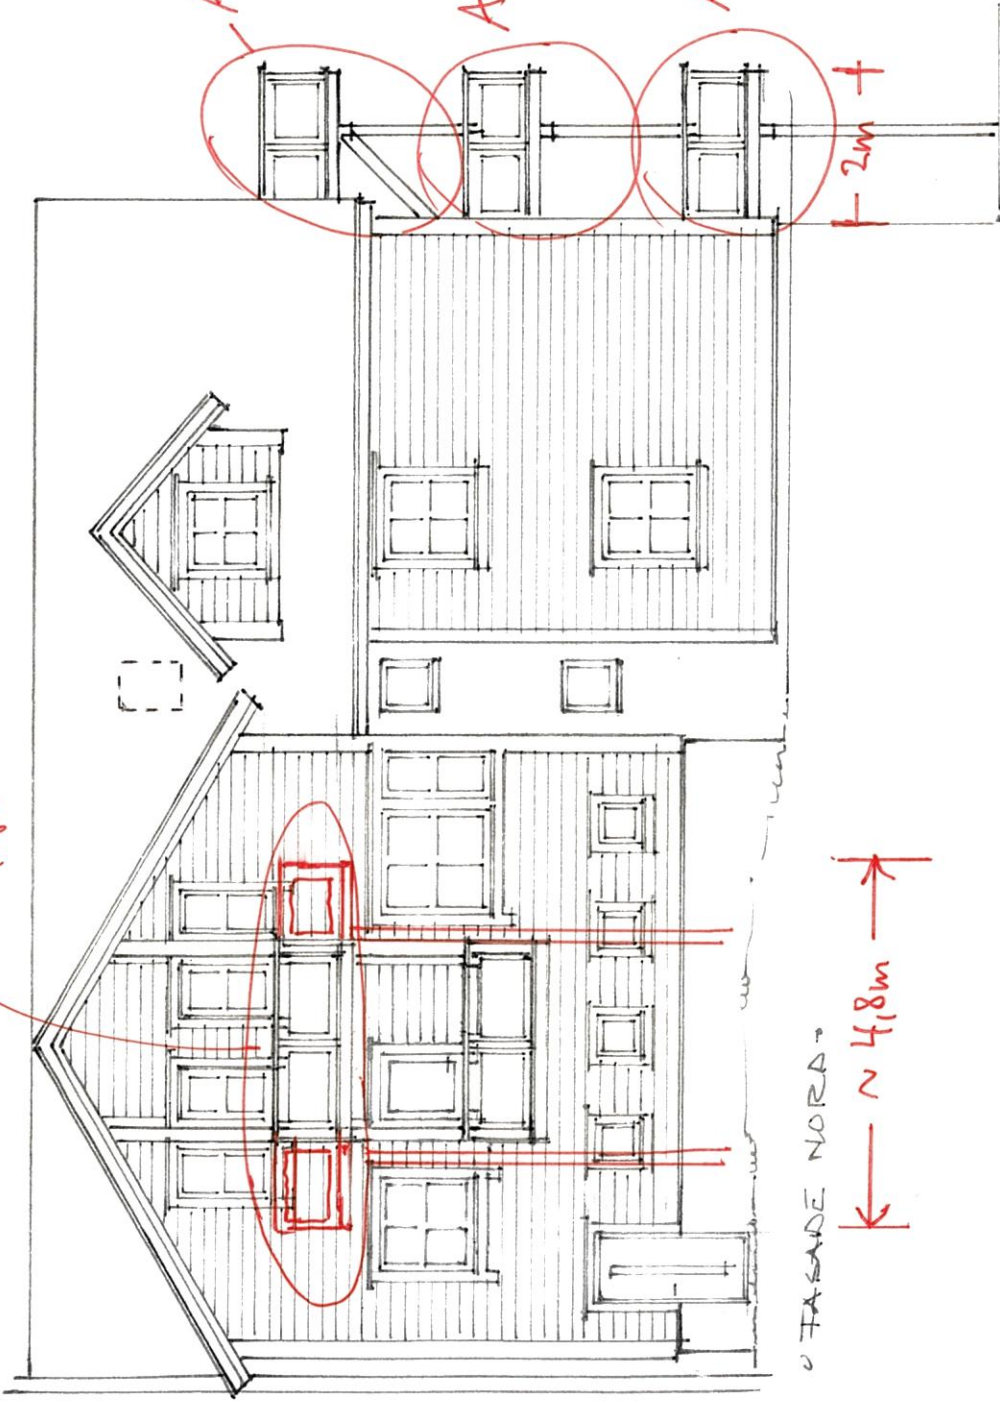

Altan loft

Altan 2. etg.

Altan 1. etg.

2m


4,8m

REG VIGLEIK NYHAMMER

KORRIGERT 24.9.17