



E1 4-2

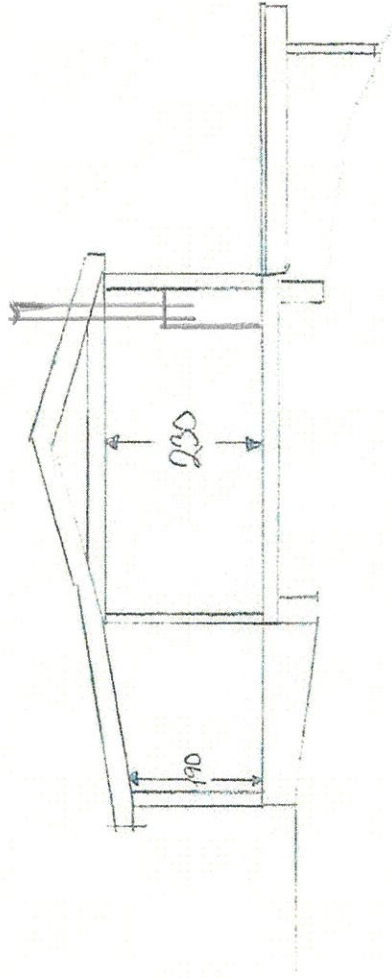

Housenrg 66
1:100 skit

ED 2-2


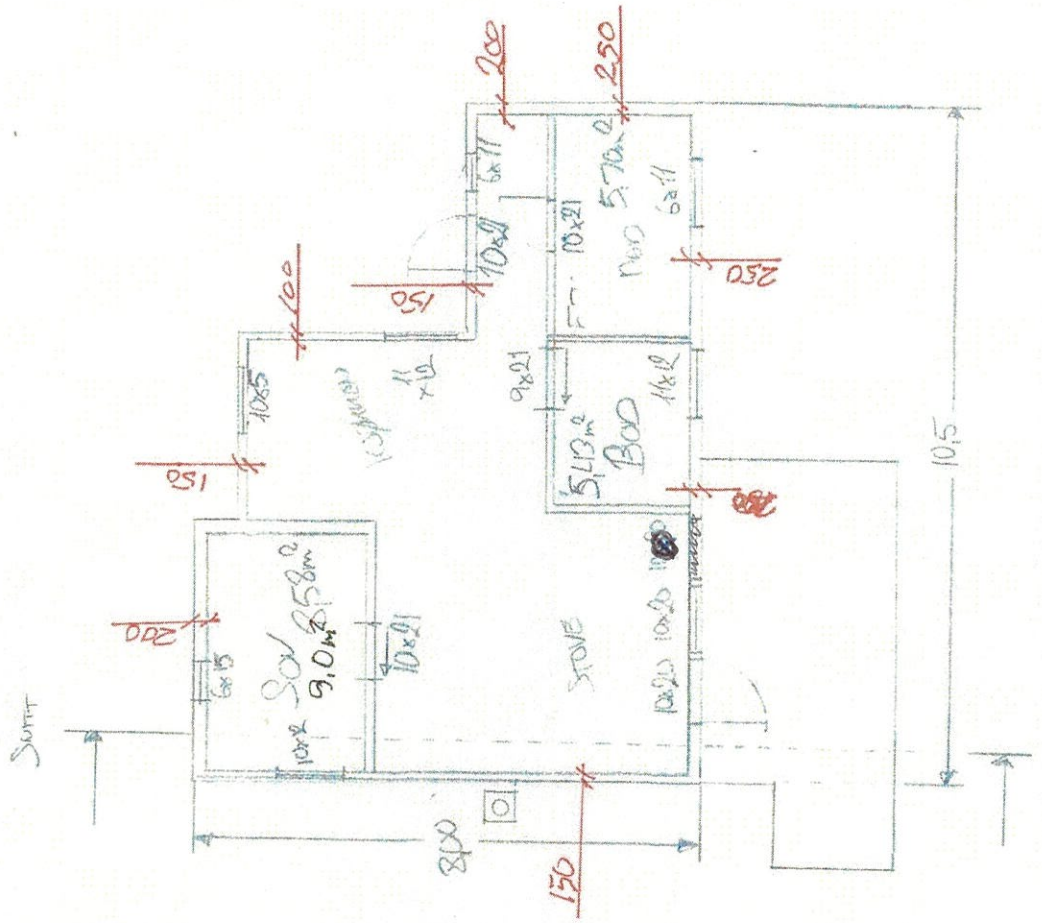

HOUSINGPLAN 66

1:100