


27 SEPT. 2022

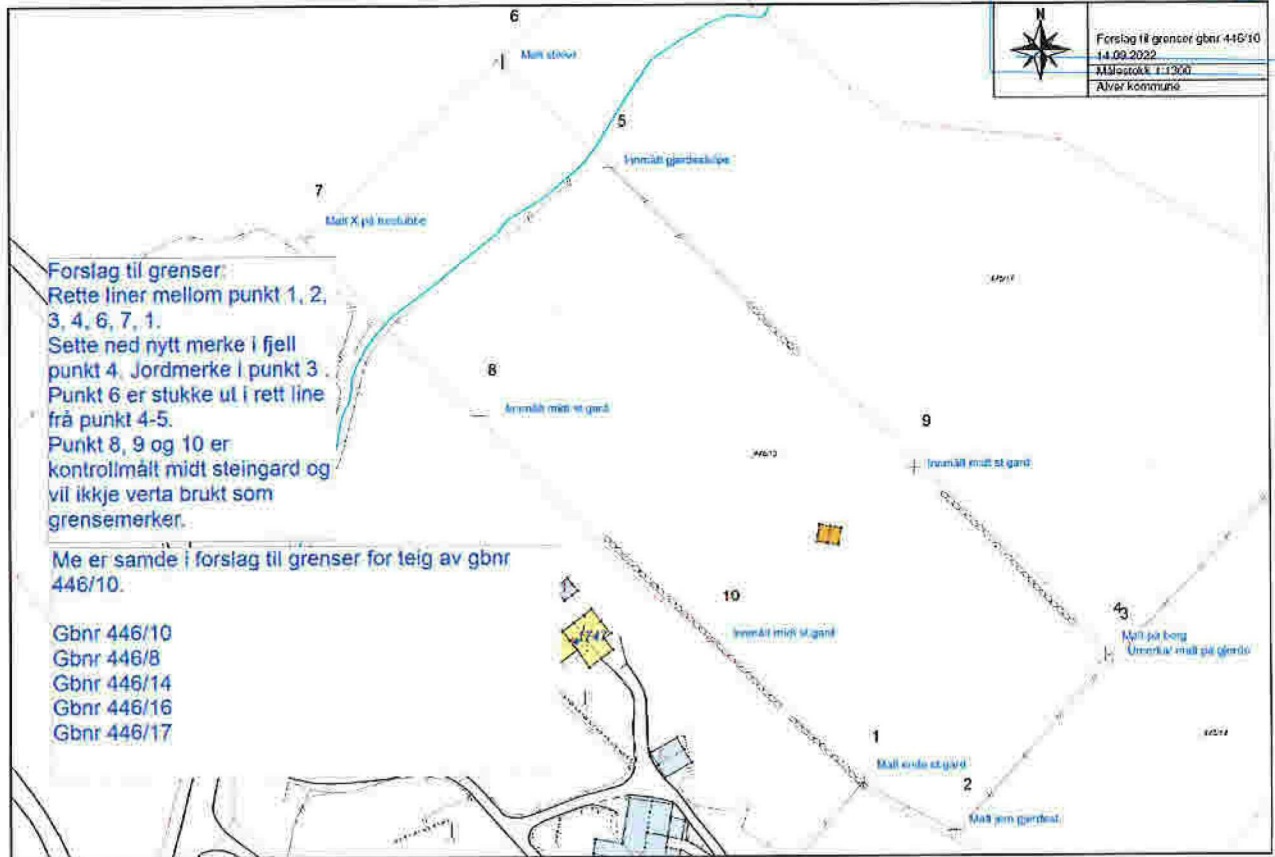

Godkjert:
 Thomas Terje Manger