


Klubben

12.1

AS bult.

# Hjelmås

18/16-22

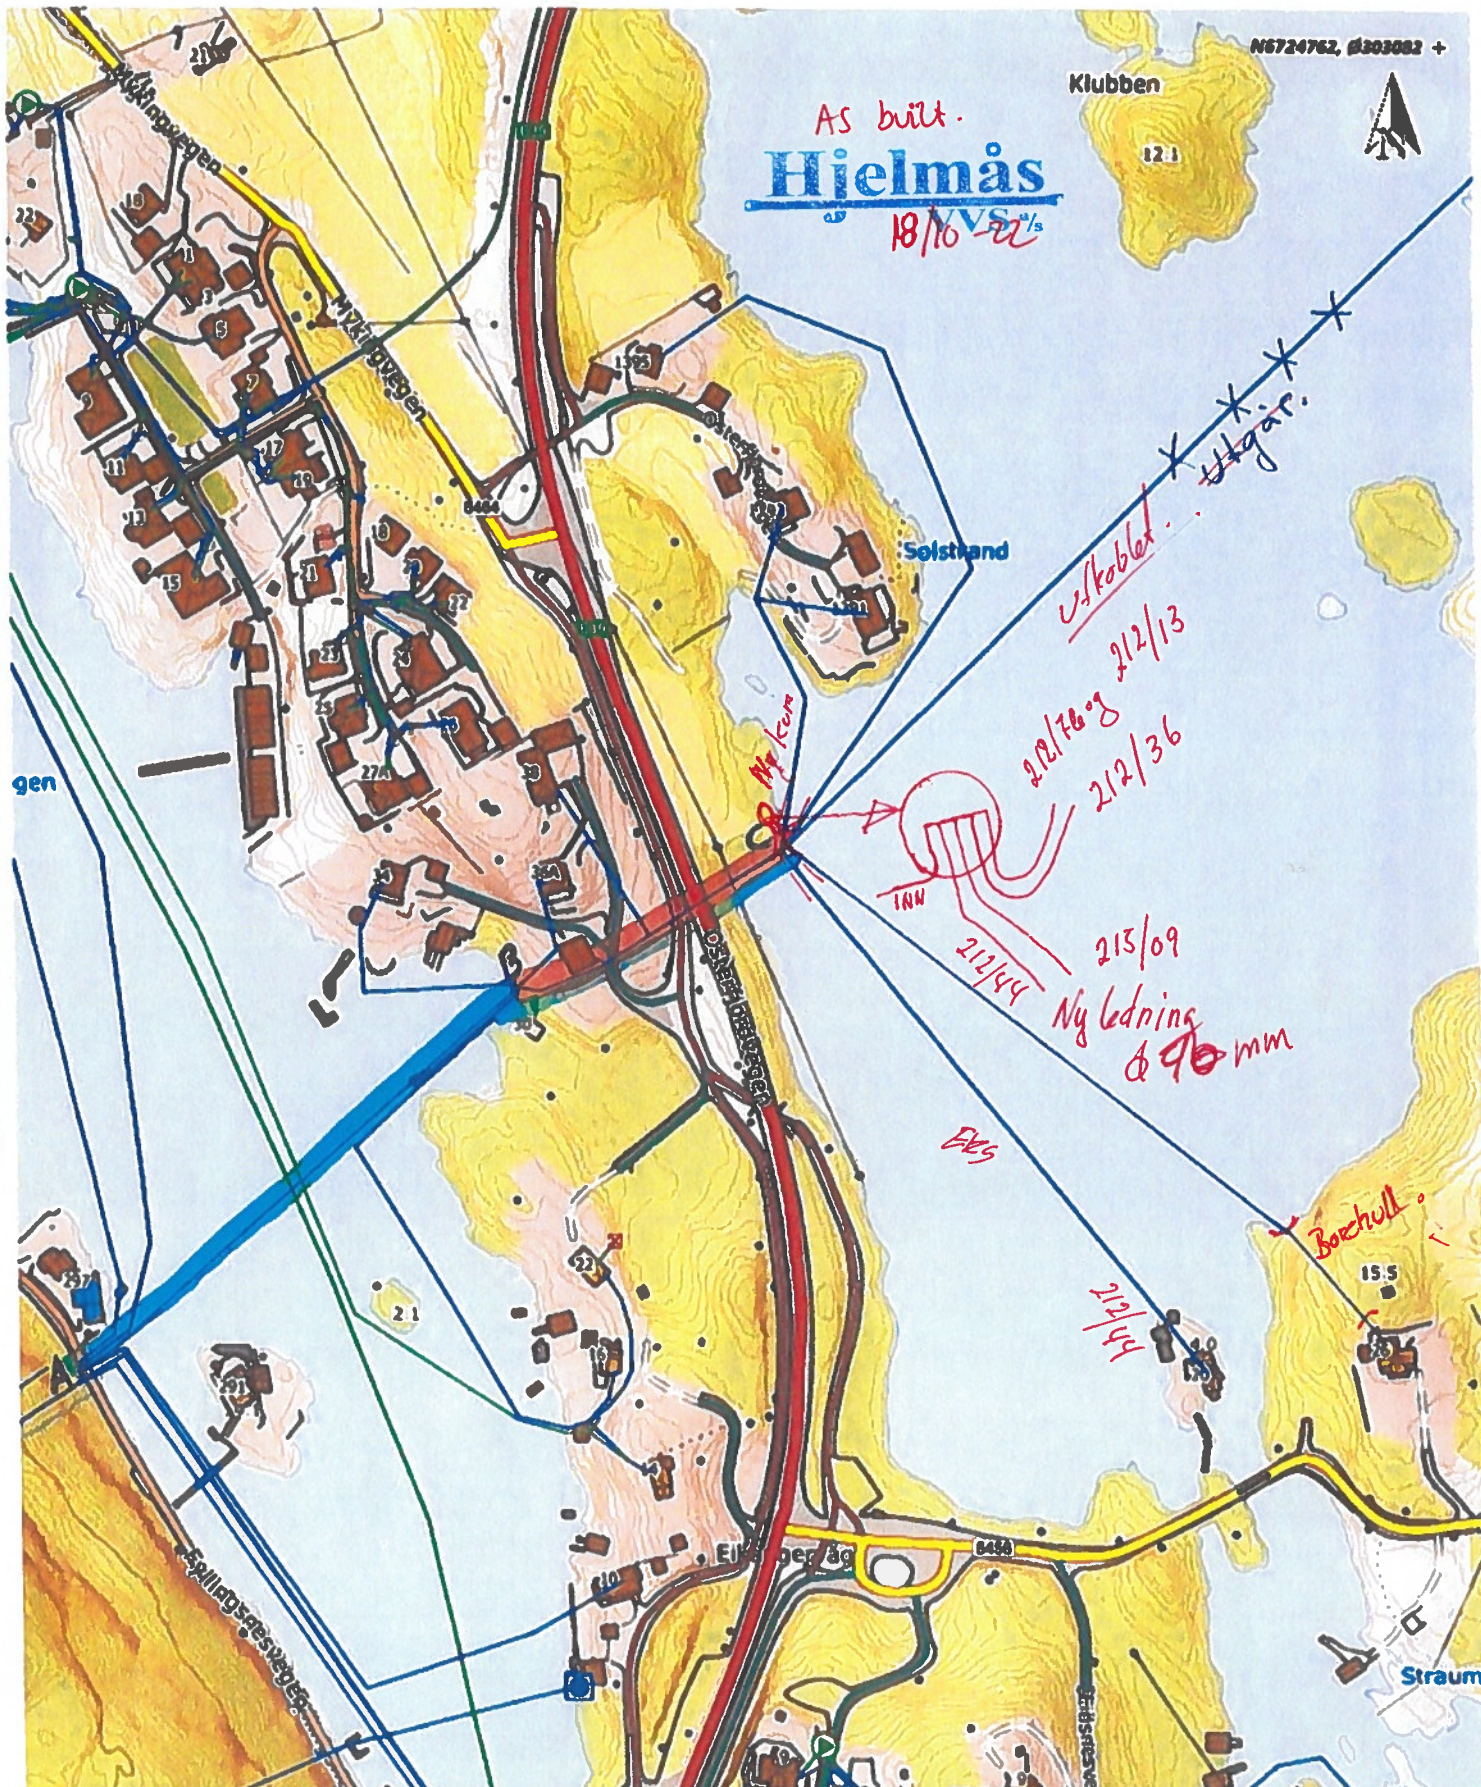

212/08 212/13  
212/36

215/09  
Ny ledning  
Ø 90 mm

EKS

212/12

Borchull

Situasjonskart -

68nr 215/09 (Knr. 4631)

Gerd Eikanger Hansen

Dato: 15-07-2021



Målestokk: 1:2 500

