

1

Gnr 418 Bnr 19
Rosnesvegen 481
Spillvannsledning og
Plassering av Slamavskiller
1:500
Arke. Rosnes 46-93-94-59

Ny hytte Slamavskiller 4 m³




Ny terrasse

418/9

418/19

418/19

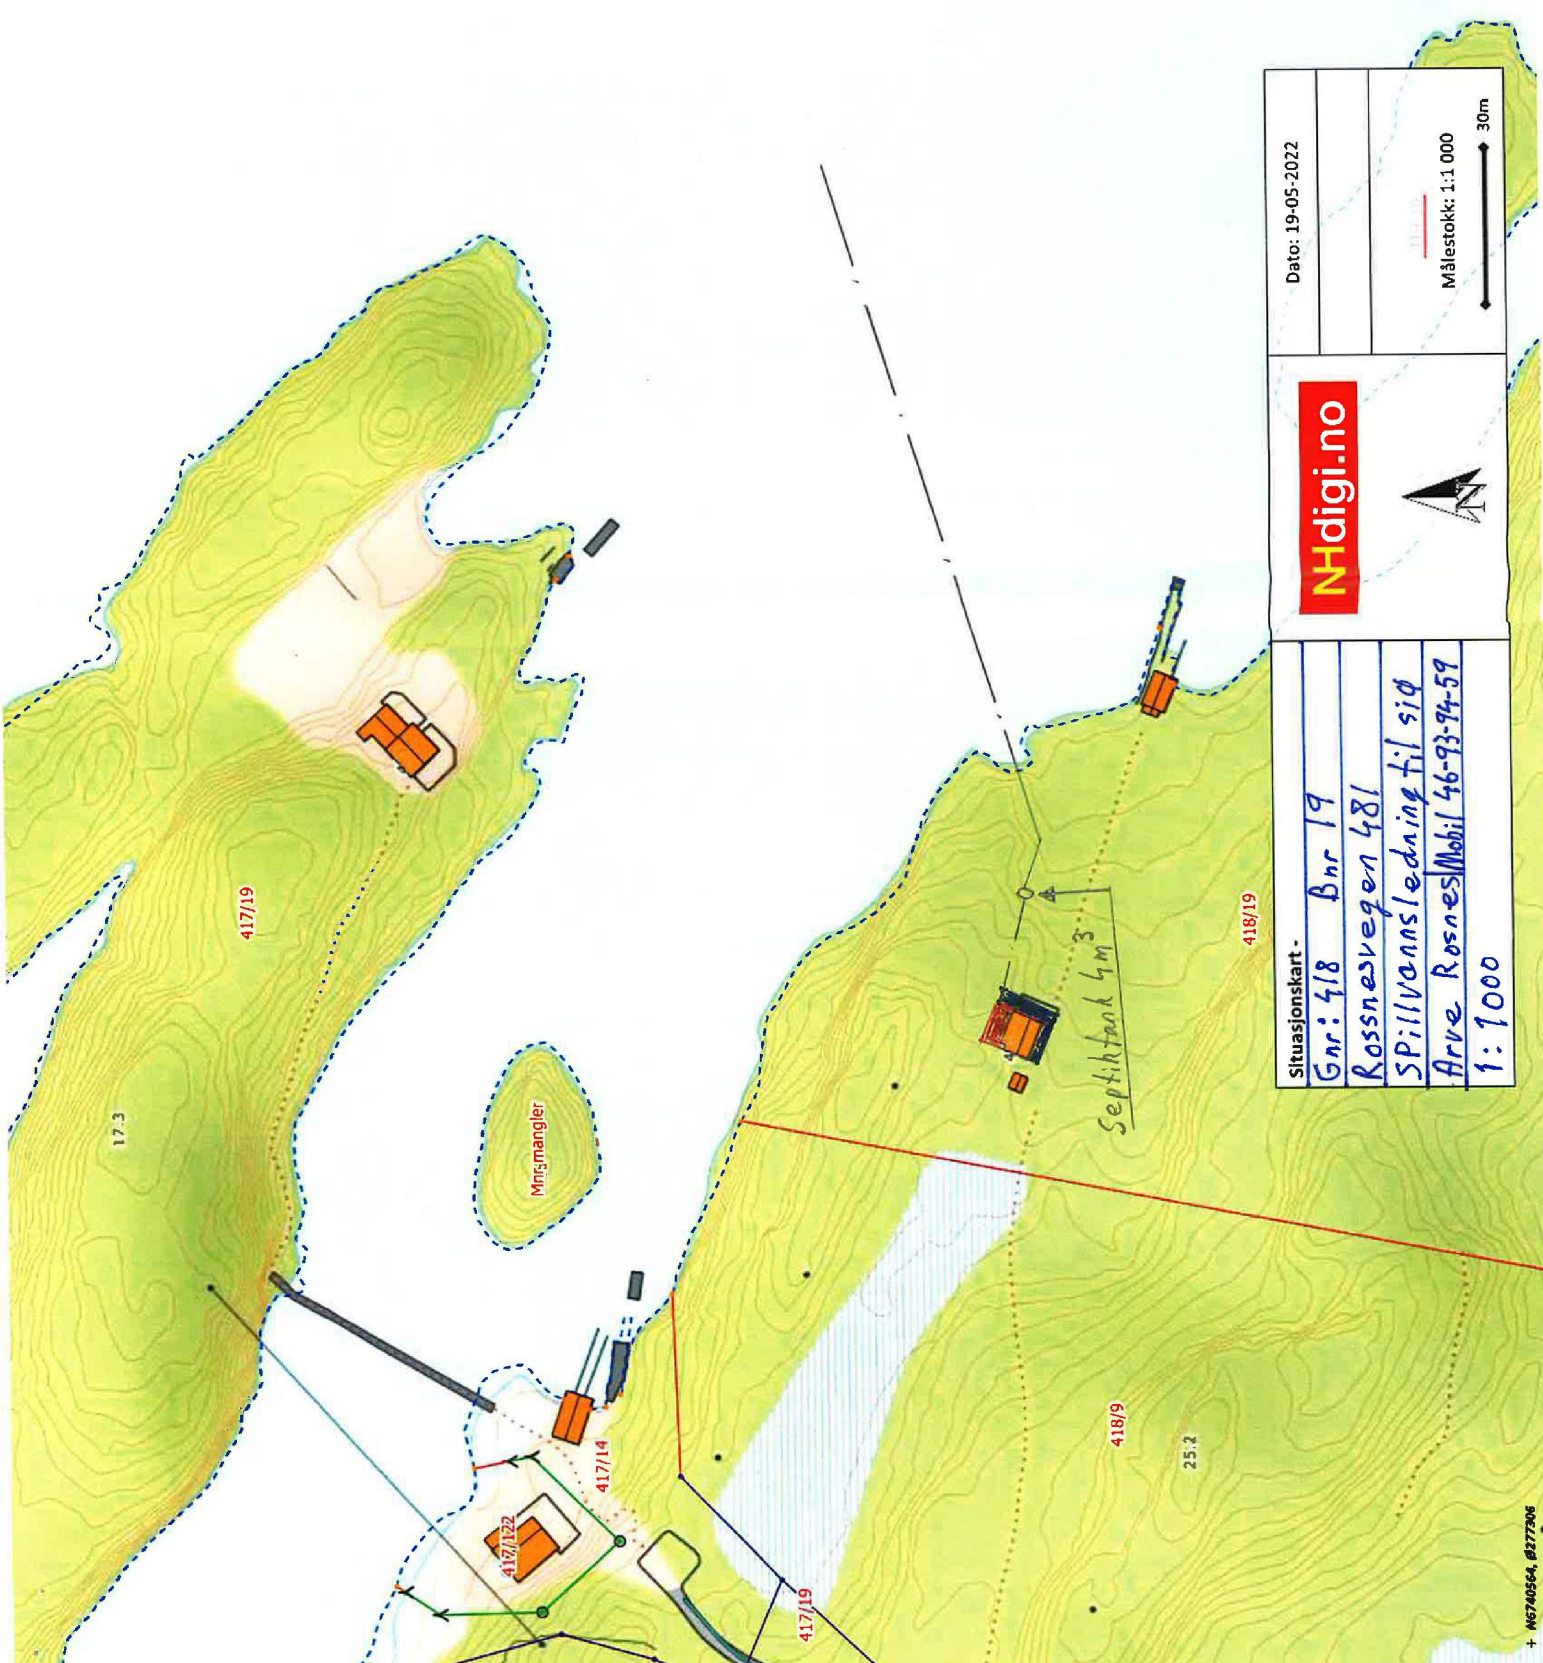

Situasjonskart -		Date: 19-05-2022	
Gnr: 418 Bnr 19		 Målestokk: 1:1 000 	
Rosnesvegen 481			
SPillvannsledning til sjø			
Arve Rosnes Mobil 46-93-94-59			
1: 1000			

NHdigi.no