




PROFIL 1

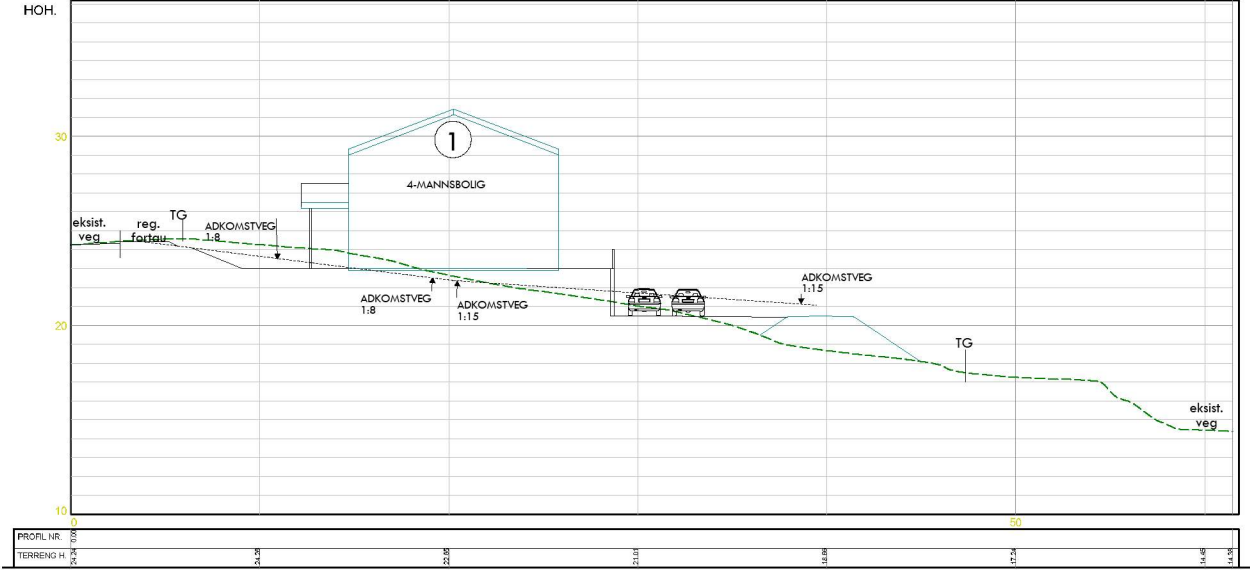


PROFIL 2

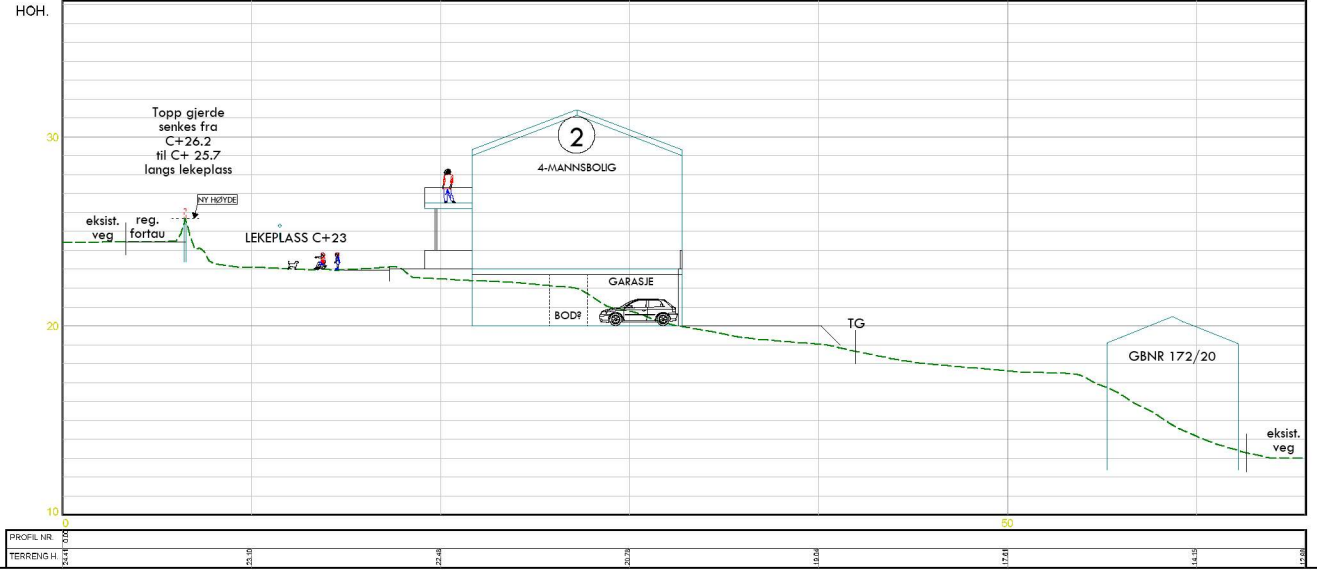

PROFIL 3

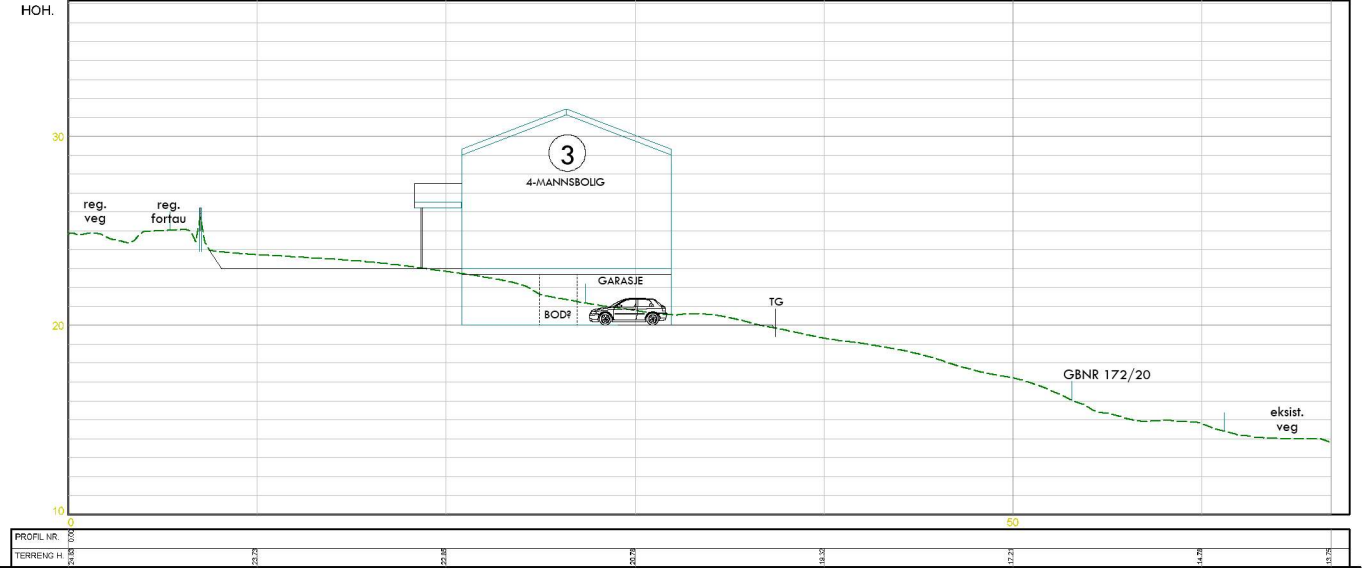

BIRKELUNDSTUNET VEGPROFIL - PLANLAGT INTERNVEG

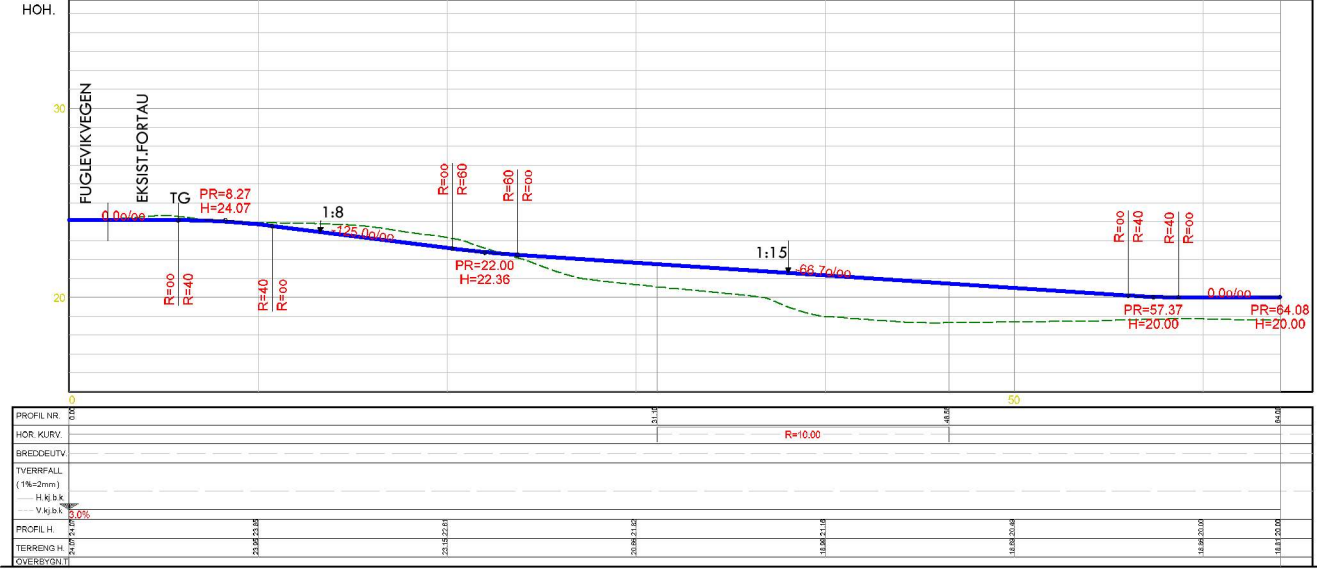

04.03.2021 Justeringer mhs

BIRKELUNDSTUNET					
SEIM					
ALVER					
Dato	02/10/19	Konstr./tegnet	Godkjent	Målestokk	
EUREF89 - SONE 32			1:400		
Profil 1-2-3					
				Erstatning for:	Erstattet av:
				206	
Henvisning:		Beregning		9004	