


Vedlegg 2.

5.12.2022

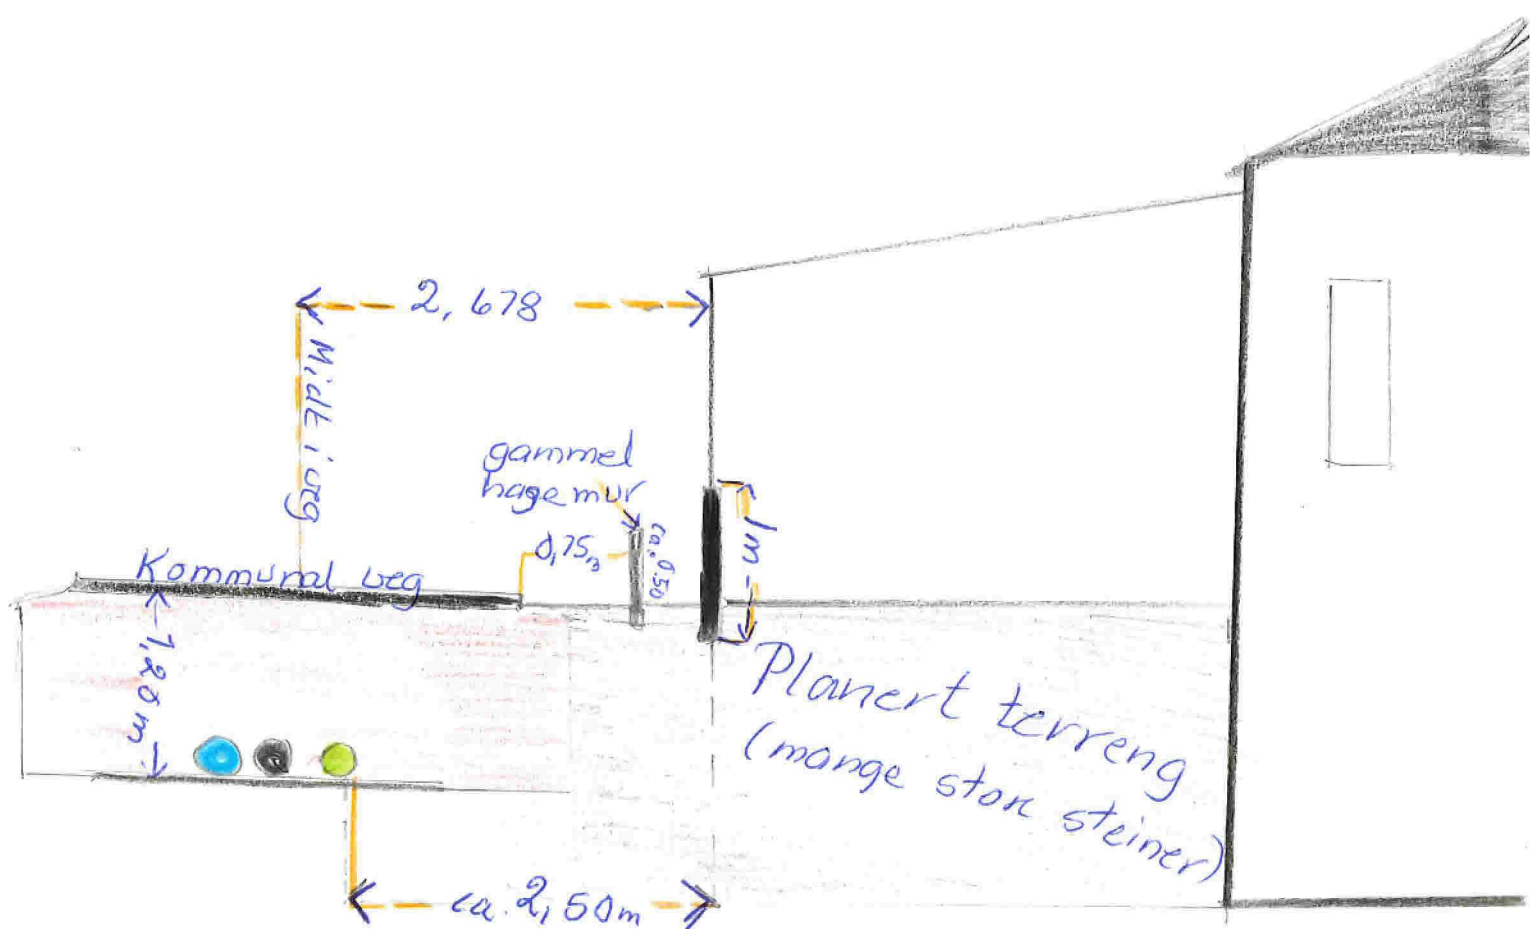

Galtanesv. 9

323/261