


**Justert plan**  
Sporing, personbil  
Radius = 4,0

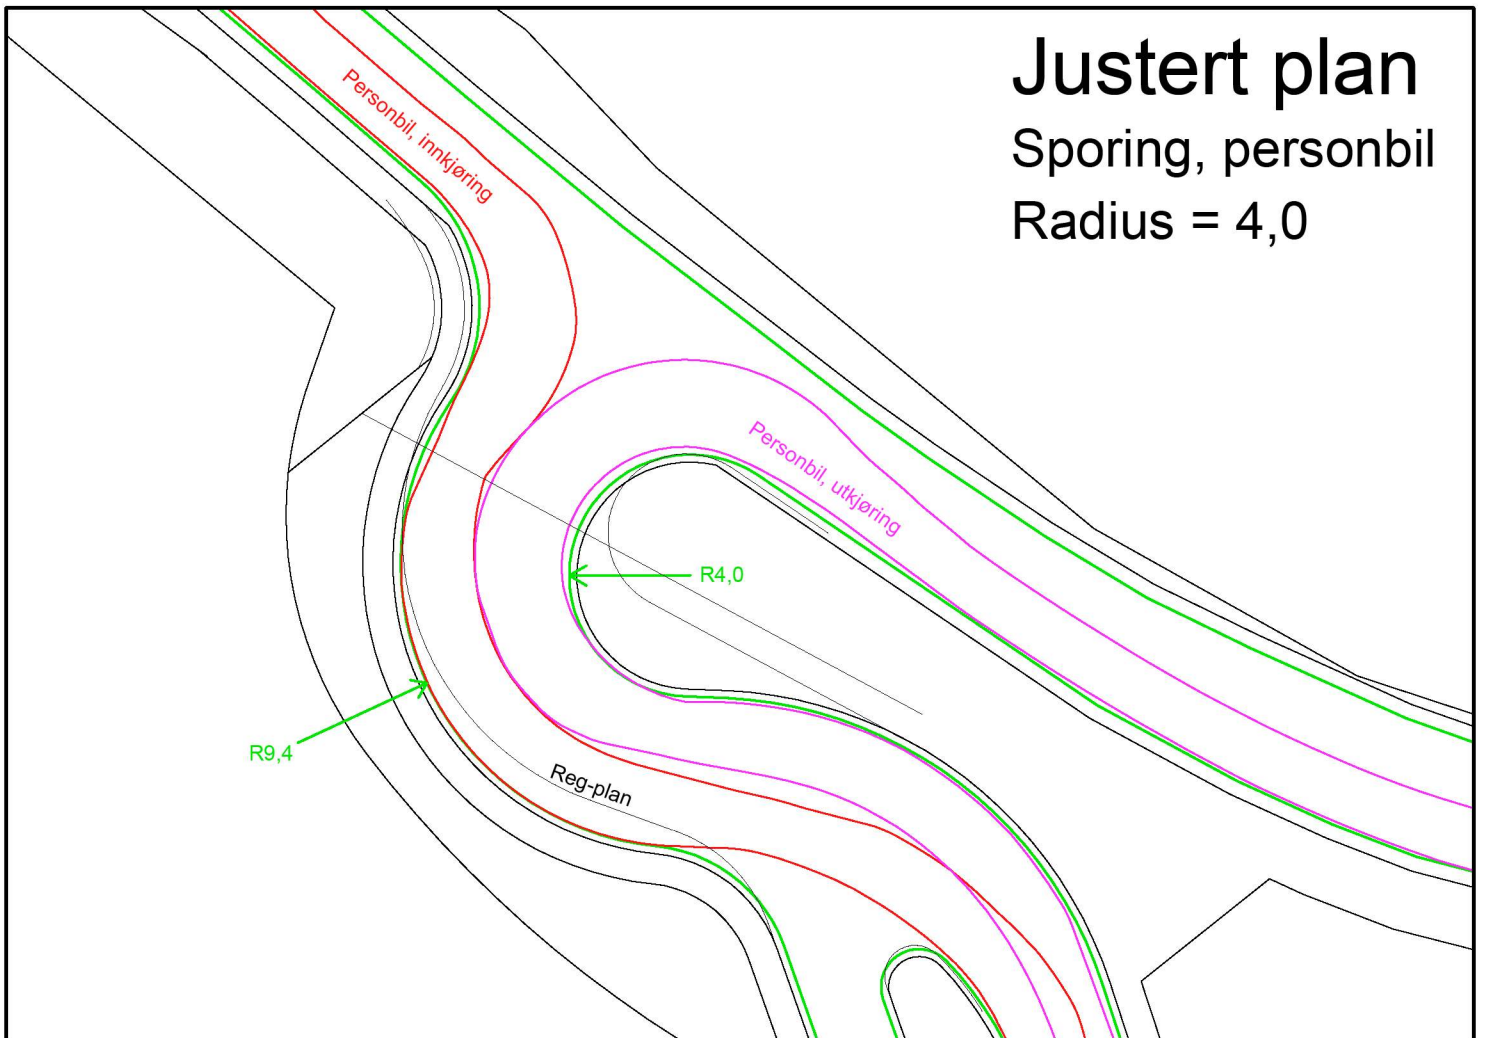

**Justert plan**  
Sporing, personbil  
Radius = 3,5

