



127/122

127/127

127/109

VL 160 K

SP 160 K

127/132

127 Lindås


OV 250 K

VL 200 K

VL 355 K

SP 160 K

127/123

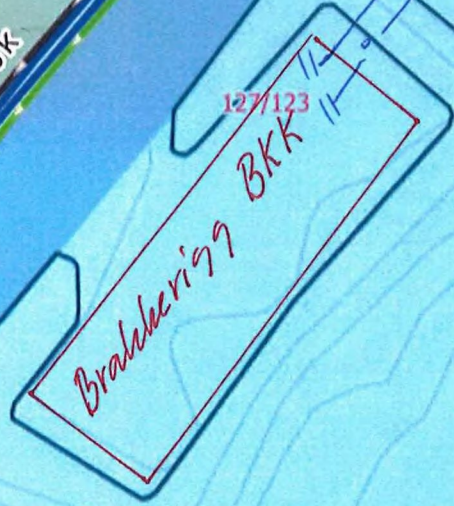

128/8 Austrheim

Situasjonskart - Plassering av brakkerigg for BKK

Dato: 16-01-2023



Målestokk: 1:500

