

VEG5

VEG7

19. p. plassar

Teiknforklaring

	Eks. veg		Friskt
	Førtau		Ståtrekkverk
	Sykkelveg		Betongtrekkverk
	GS-veg		Mur
	Hakleplass		Kantstein 16 cm vis
			Nedsenka kantstein
			Vegmodell
			Teilgrense
			Eks. veg

OPUS


Lonena aust (46312021003)  
 PLANFLATE 2  
 Kryss fv57 x Juvikstøten  
 Kånalisering venstresvingefelt  
 Detaljar T-kryss

Stad: Bergen  
 Dato: 16.05.2022  
 Målestokk: 1:250 (A1)  
 Prosjektant: H1  
 Tegnar: T1  
 Kontrollert av: E1

Proj.nr.: 21000  
 Teikn.nr.: E201






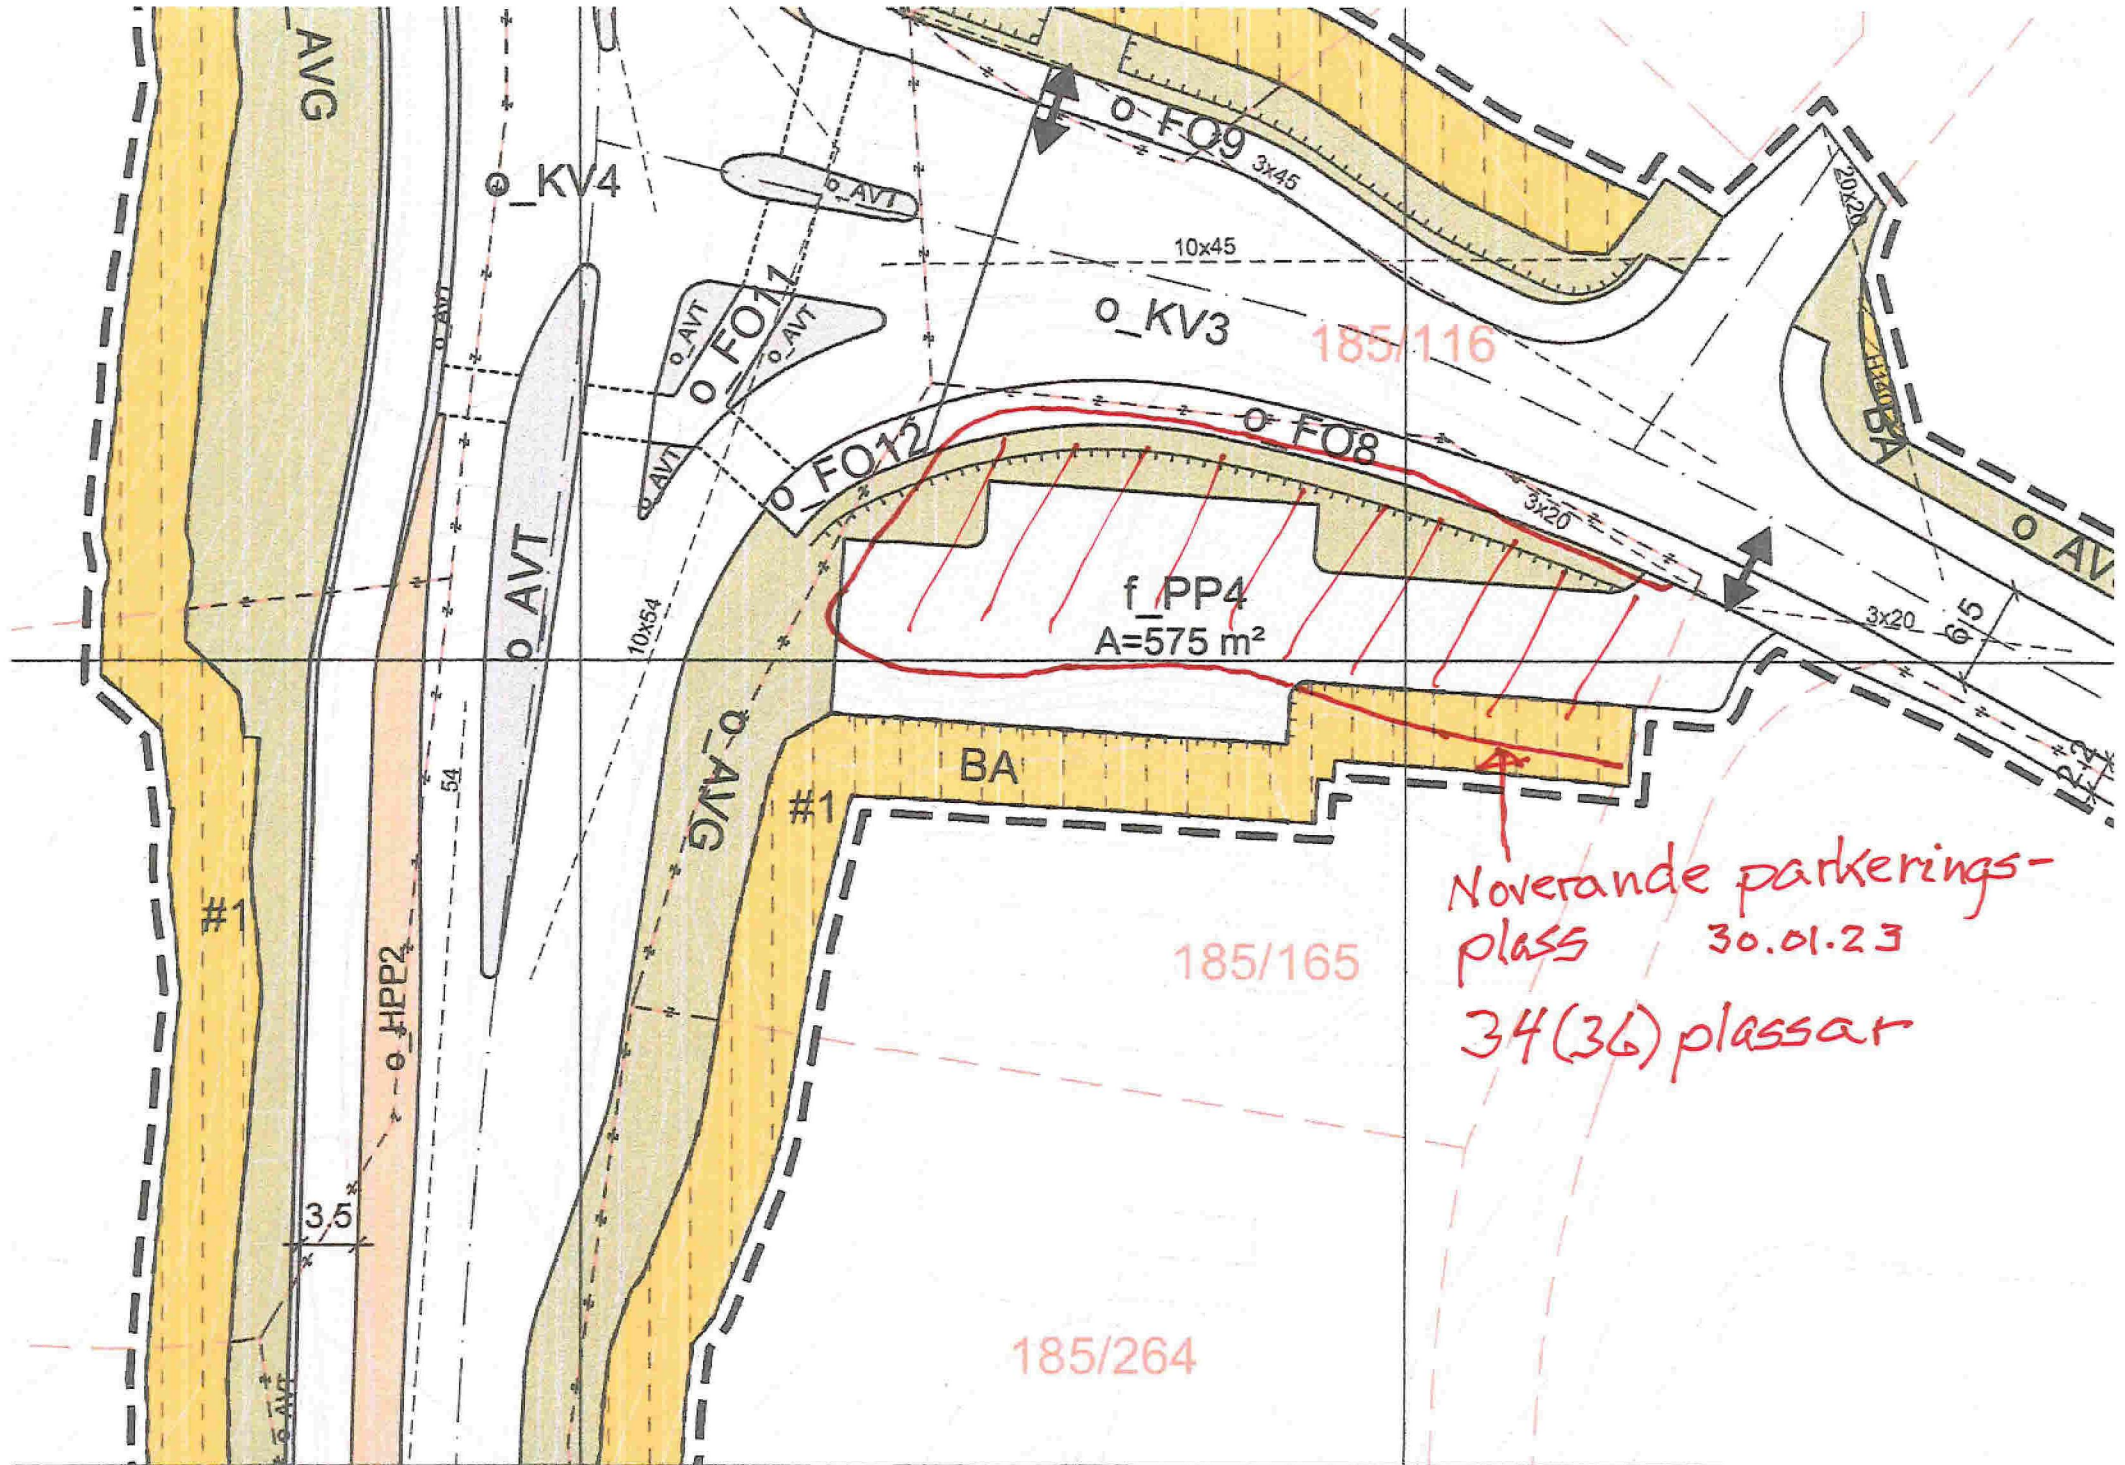




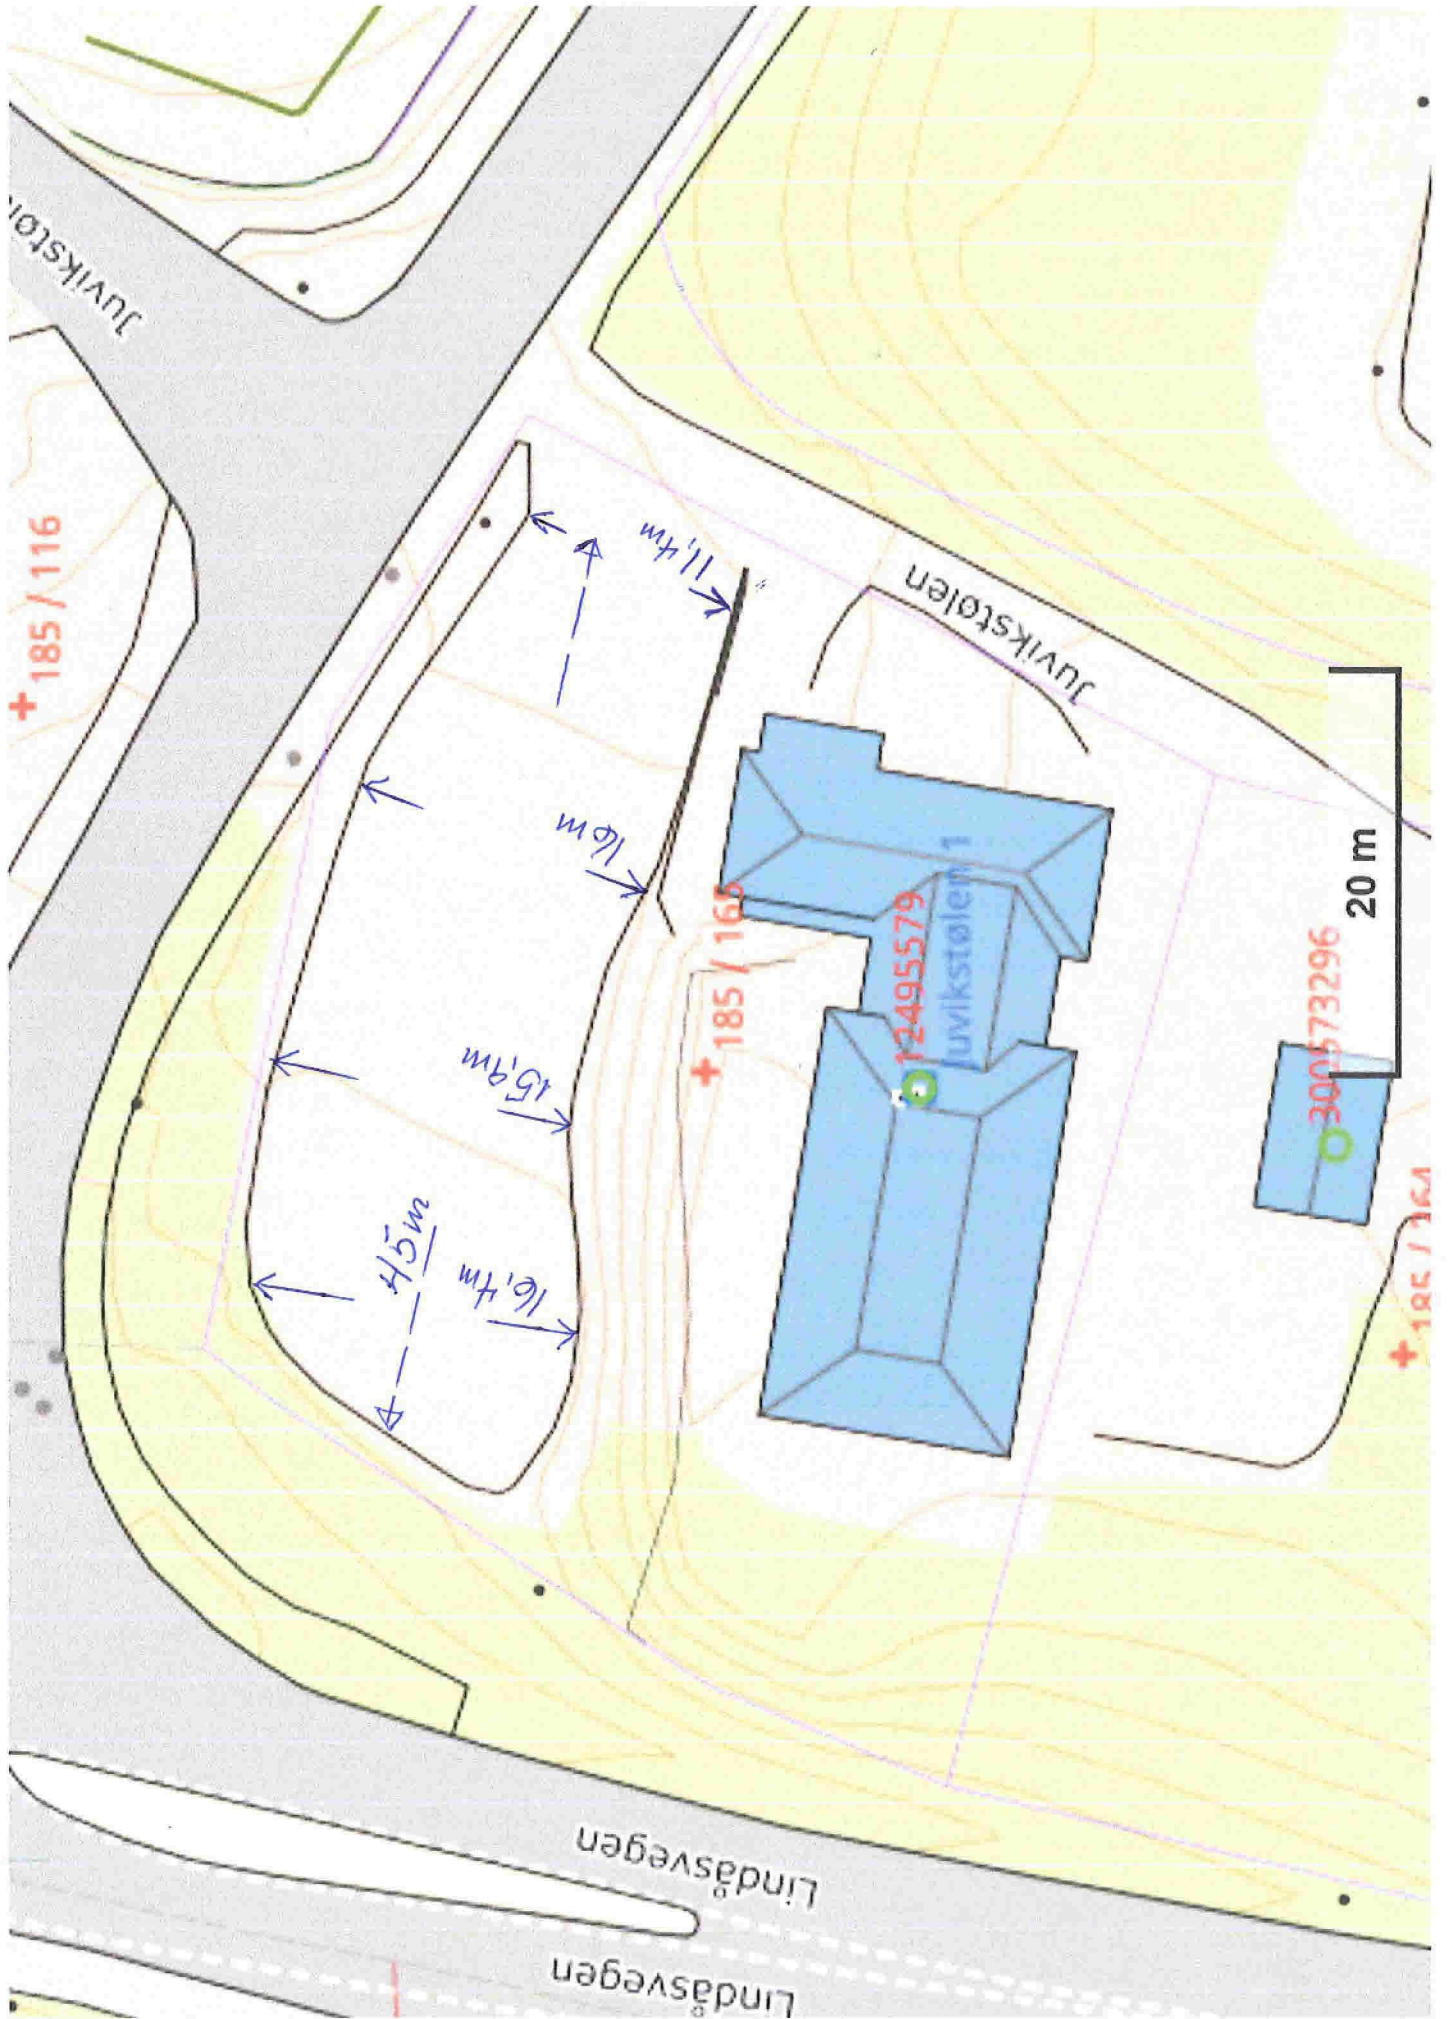

# Pinsemenigheten Betania Knarvik

Parkeringsplassen to tilfeldige dager, 25. og 26. januar 2023

