

INNMÅLINGSTJENESTER AS



Organisasjonsnr. 979 927 703
Bankgiro: 3624 07 79751

Vår ref:
Knut Henanger

Deres ref:

Dato: 04.01.22.

Stikningsdata for Gnr. 315 Bnr. 14, Hoplandsvegen 105, Alver Kommune.

<u>HUSET</u>			
<u>PUNKT</u>	<u>TEMA</u>	<u>X</u>	<u>Y</u>
05 1	5000	6716420.163	290120.098
05 2	5000	6716415.722	290121.920
05 3	5000	6716416.177	290123.030
05 4	5000	6716413.402	290124.168
05 5	5000	6716412.946	290123.058
05 6	5000	6716408.506	290124.880
05 7	5000	6716405.545	290117.663
05 8	5000	6716409.431	290116.069
05 9	5000	6716408.748	290114.404
05 10	5000	6716412.634	290112.810
05 11	5000	6716413.317	290114.475
05 12	5000	6716417.203	290112.881
<u>TOMTEN</u>			
05 14	4011	6716388.130	290104.060
05 15	4011	6716389.560	290102.620
05 16	4011	6716401.940	290090.180
05 17	4011	6716418.640	290074.450
05 18	4011	6716427.680	290066.060
05 19	4011	6716430.010	290063.890
05 20	4011	6716446.290	290105.690
05 21	4011	6716432.770	290118.540
05 22	4011	6716424.770	290127.440
05 23	4011	6716422.730	290130.820
05 24	4011	6716418.060	290126.760
05 25	4011	6716405.780	290144.000
05 26	4011	6716402.870	290147.900
05 27	4011	6716403.690	290151.320
05 28	4011	6716407.940	290150.290
05 29	4011	6716409.570	290151.800
05 30	4011	6716403.080	290158.980
05 31	4011	6716400.920	290149.240
05 32	4011	6716394.510	290124.410
05 33	4011	6716391.950	290116.260

Innmålingstjenester as



Kjersti K. Madsen

Kjersti K. Madsen

Kontoradresse:
Telefon
Kjersti K. Madsen
Johnny Sandvik

Helgeplassen 144
55 59 02 77 (76)
Mob.tlf. 90 78 72 08
Mob.tlf. 40 40 23 23

5148 Fyllingsdalen
E.Post: innmal@innmal.no

Y 290050


Y 29100

Y 290150

X 6716450

X 6716400

Stikningsskisse for Hoplandsvegen 105 Gnr. 315 Bnr. 14, Alver Kommune.

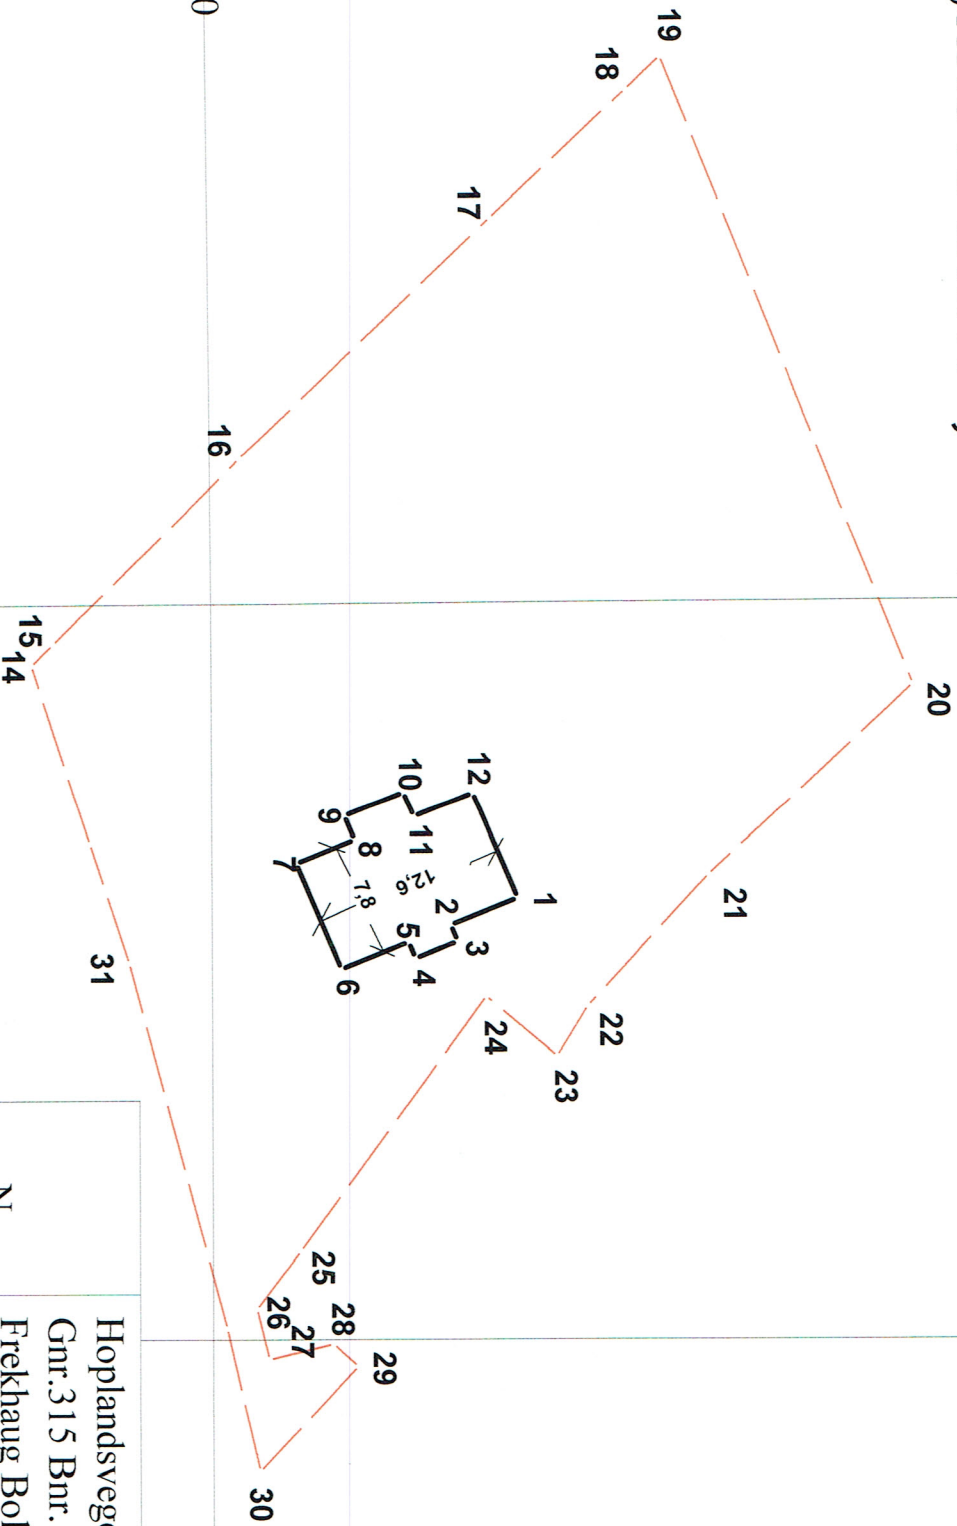

Gulv underetasje kote 88,7



Hoplandsvegen 105

Gnr. 315 Bnr. 14, Alver Kommune.

Frekhaug Bolig as

Dato: 04/01/22

Målestokk 1:500

Innmålingstjenester as

Per Arne R. Haldsen

315-14

```

-00 FFFFFFFFFFFFFFFFFFFFFFFFFFFFFFFFFFFFFFFFFFFFFFFFFFFFFFFFFF
-01 OOOOOOOOOOOO DDDDDDDDDDD VVVVVVVVVVVV KKKKKKKKKKKK OOOOOOOOOOOO
-02 SSSSSSSSSS KKKKKKKK NNNNNNNN TTTTTTTT TTTTTTTT II.III Bk MMMMMMMM
-03 TTTTTTTTTT KKKKKKKK HHH.HHHH VVV.VVVV AAAA.AAA SS.SSS Bk MMMMMMMM
-04 TTTTTTTTTT KKKKKKKK HHH.HHHH DDDD.DDD AAAA.AAA SS.SSS Bk MMMMMMMM
-05 PPPPPPPPPP KKKKKKKK XXXXXXXX.XXX YYYYYYY.YYY ZZZZ.ZZZ Bk MMMMMMMM
-06 PPPPPPPPPP KKKKKKKK PPPPPPPP.PPP AAAAAAA.AAA ZZZZ.ZZZ Bk MMMMMMMM
-07 PPPPPPPPPP KKKKKKKK dXXXXXXXX.XXX dYYYYYY.YYY dZZZ.ZZZ Bk MMMMMMMM
-08 Epi E1 E2 E3 E4
-09_Pi Sammenheng FFFFFFFFFFFFFFFFFFFFFFFFFFFFFFFFFFFFFFFFFF      MMMMMMMM
-00 Leica Geosystems AG
-00 Instrument:    GX1230 GG      Måledato: 18.08.2022
-00 Målejobb:      315-14      Operatør:Kjersti K. Madsen
-00 Jobbeskrivelse:innm topp grmur,315/14, Hoplandsvegen 105,Alver K
-00 Målt i euref89 NN2000
09_91
05 12      5000      6716417.001  290112.945   88.672      0.012
05 7       5000      6716405.393  290117.740   88.658      0.012
05 6       5000      6716408.346  290124.914   91.438      0.014
05 1       5000      6716419.970  290120.106   91.415      0.016
05 12      5000      6716417.001  290112.945   88.672      0.012
09_99

```

Innmålingstjenester A/s
 19/8-22
 Kjersti K. Madsen