


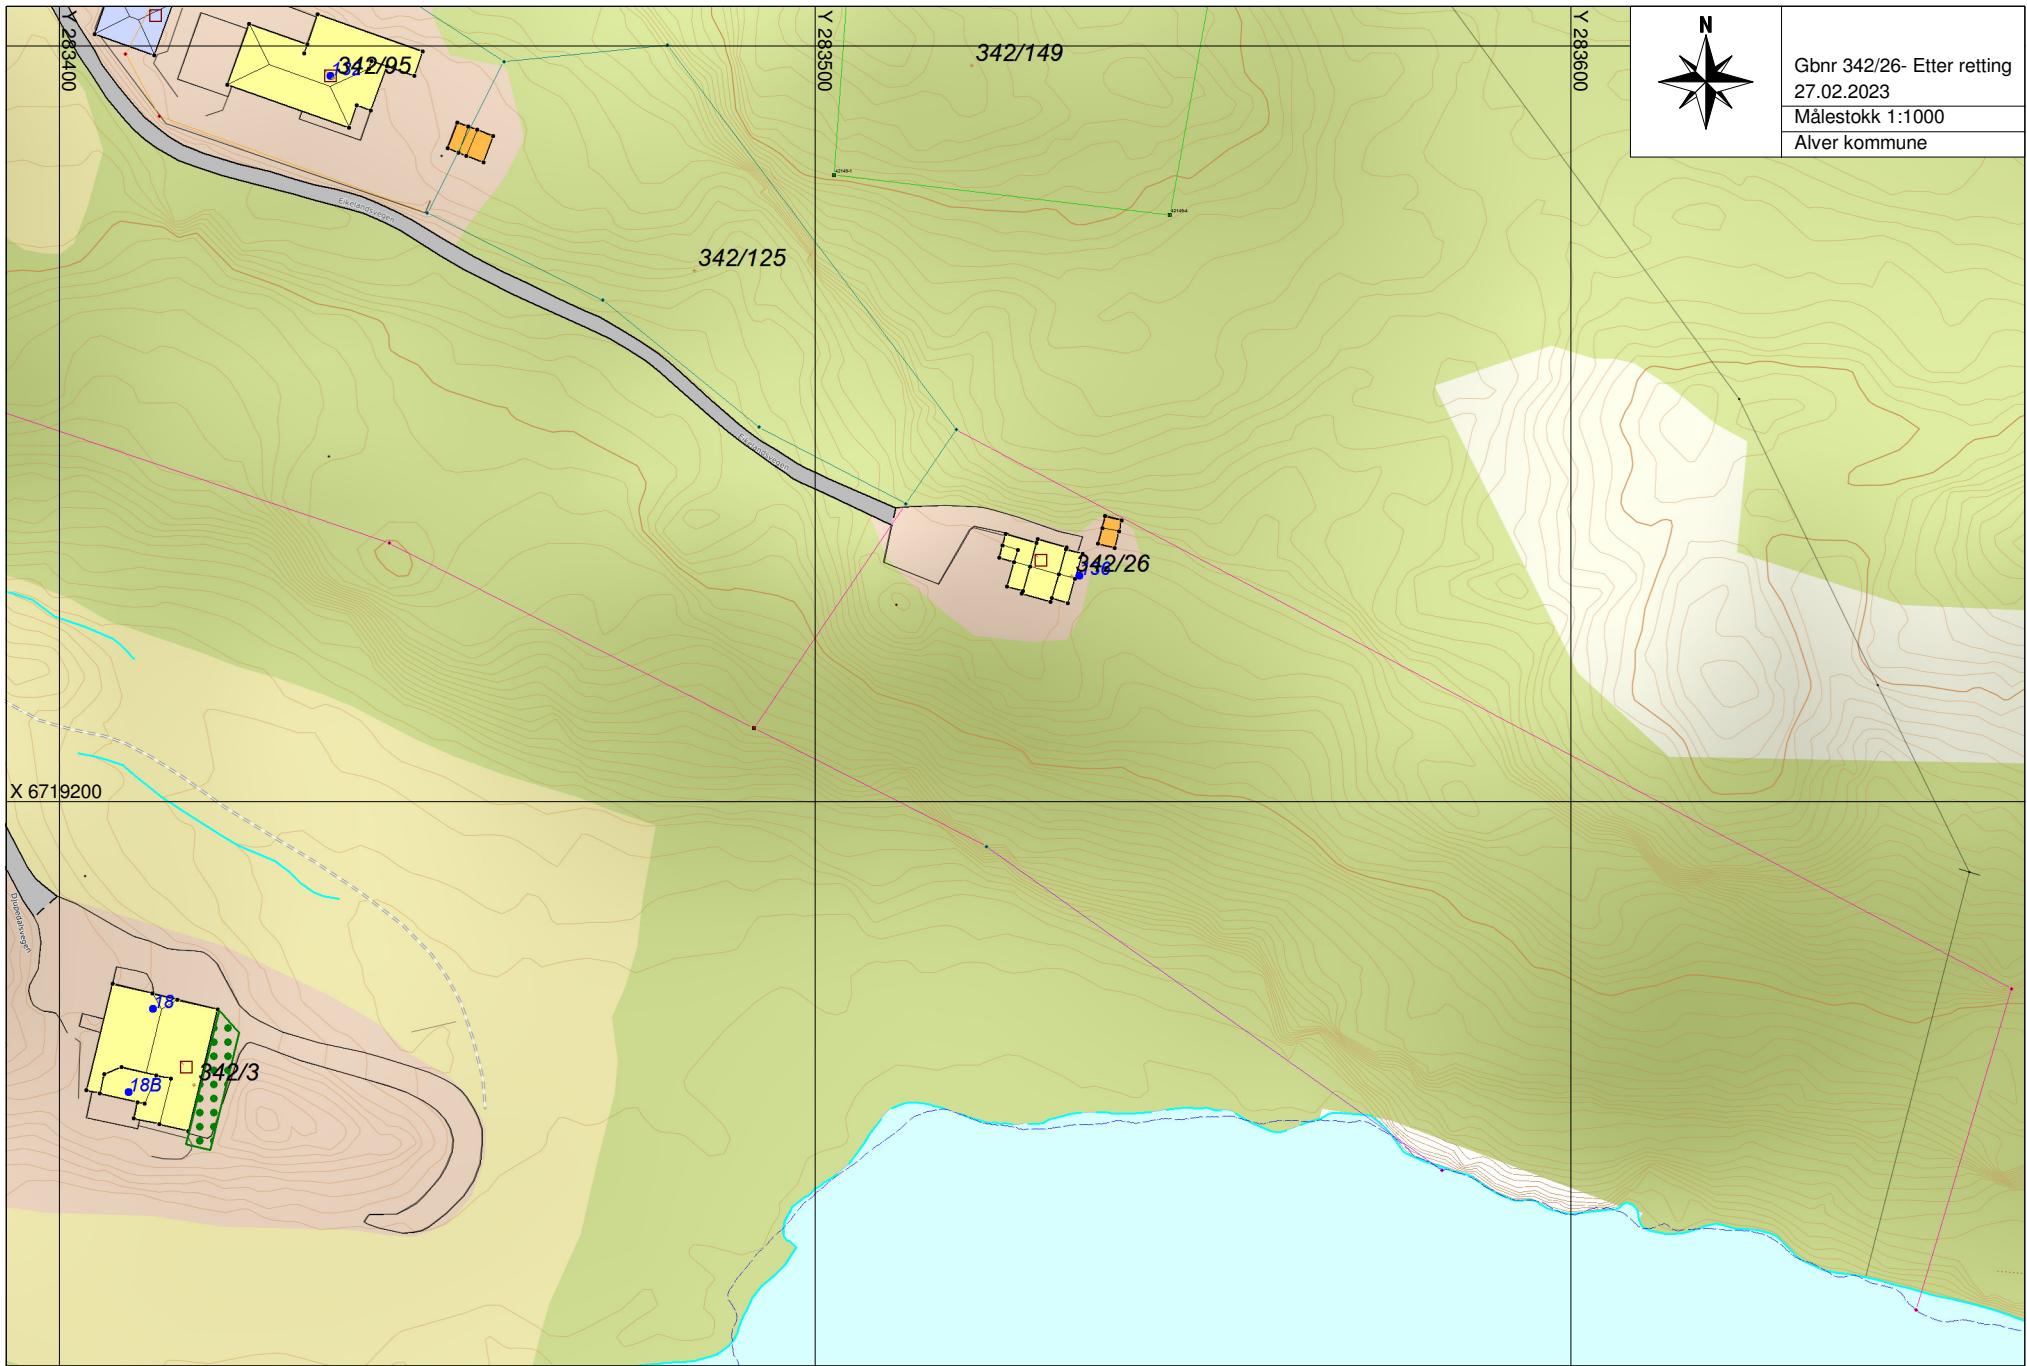

Gbnr 342/26- Etter retting
27.02.2023
Målestokk 1:1000
Alver kommune



342/95

342/149

342/125

342/26

342/3

18B

18B

X 6719200

Y 283400

Y 283500

Y 283600