


FASADE NOT VEST

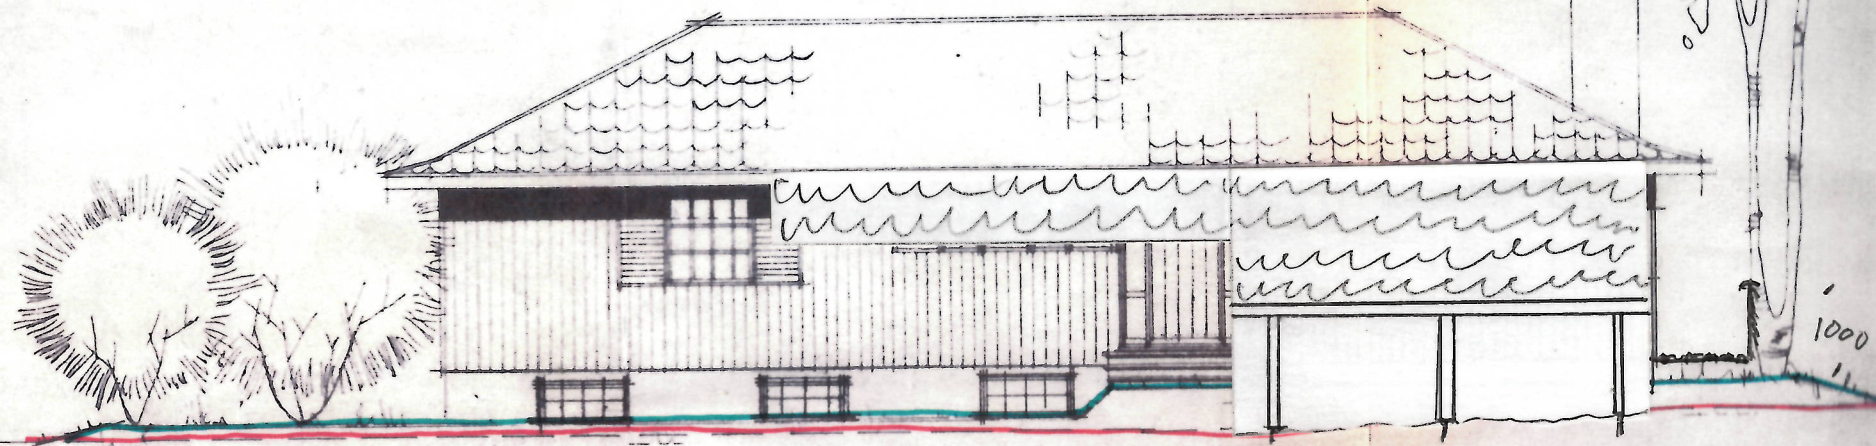

6000

5500

1300

FASADE NOT ØST