



GODTEKE
13 APR. 1972
Lindås Bygningsskild


LINDÅS KOMMUNE
KOMMUNE-
INGENIØRKONTOR
00040 C. 1. 72
ARKIV NR. 188

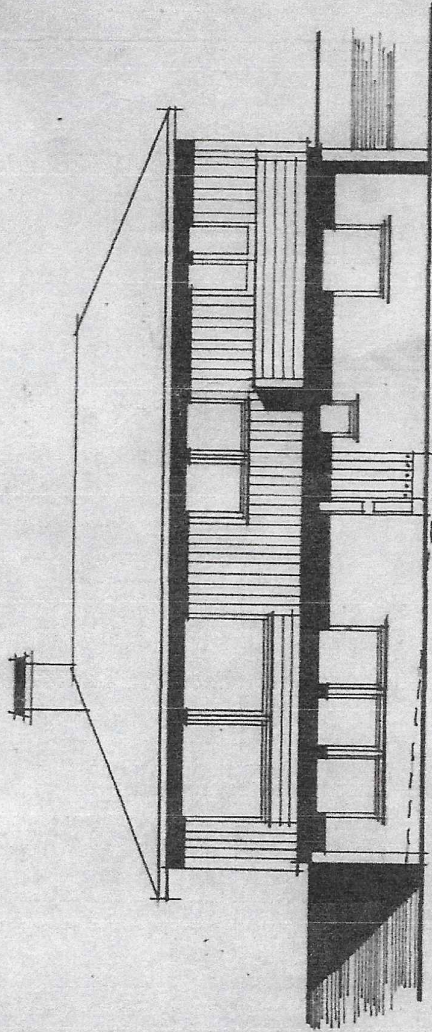


SYD-ØST

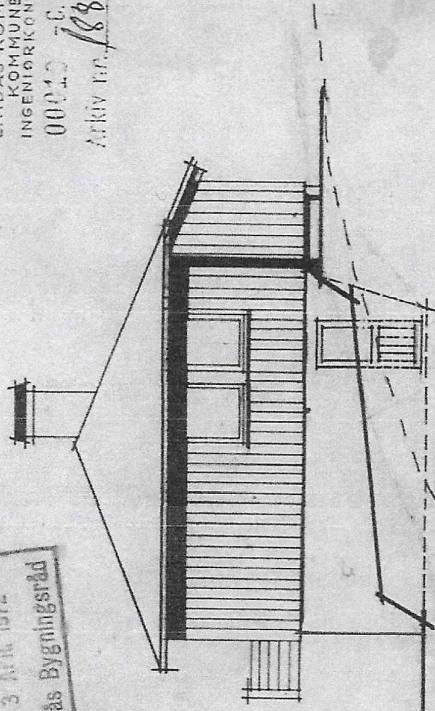

NORD-ØST

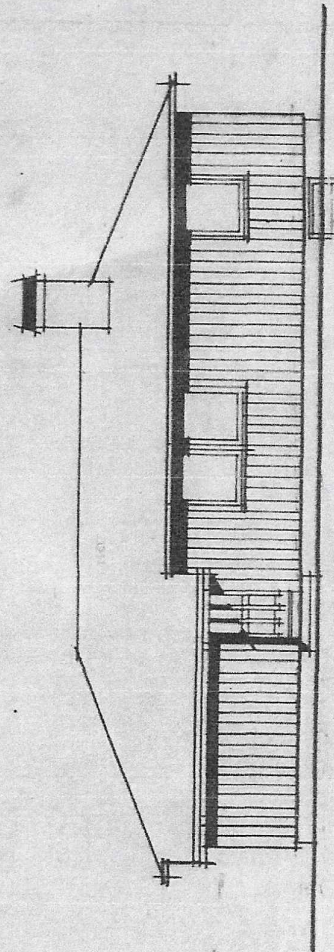

NORD-VEST

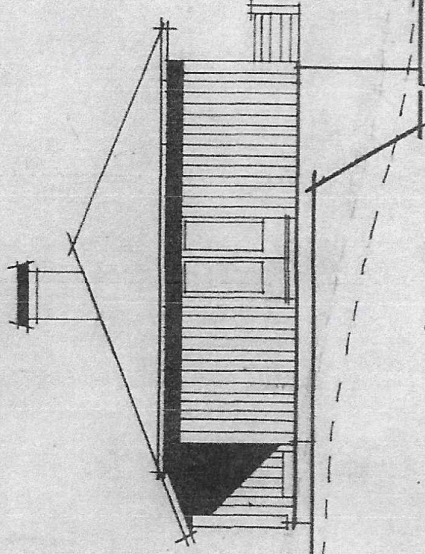

SYD-VEST

Tøikning n.s

Fasader
Som bygd i 1972

TYPE 111
FASAD
M=1
NACIV