




24208222  
21  
Raunholmskogen 21 A

Raunholmskogen

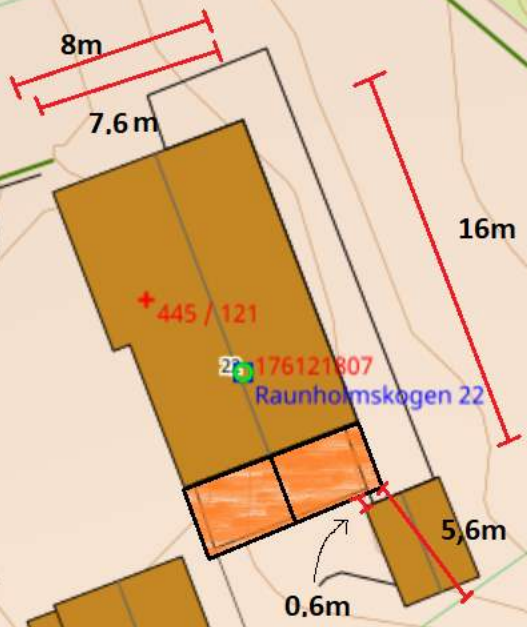

+445 / 121

22  
176121807  
Raunholmskogen 22

176121815

+445 / 207



Kartverket

23  
Raunholmskogen 23 A

